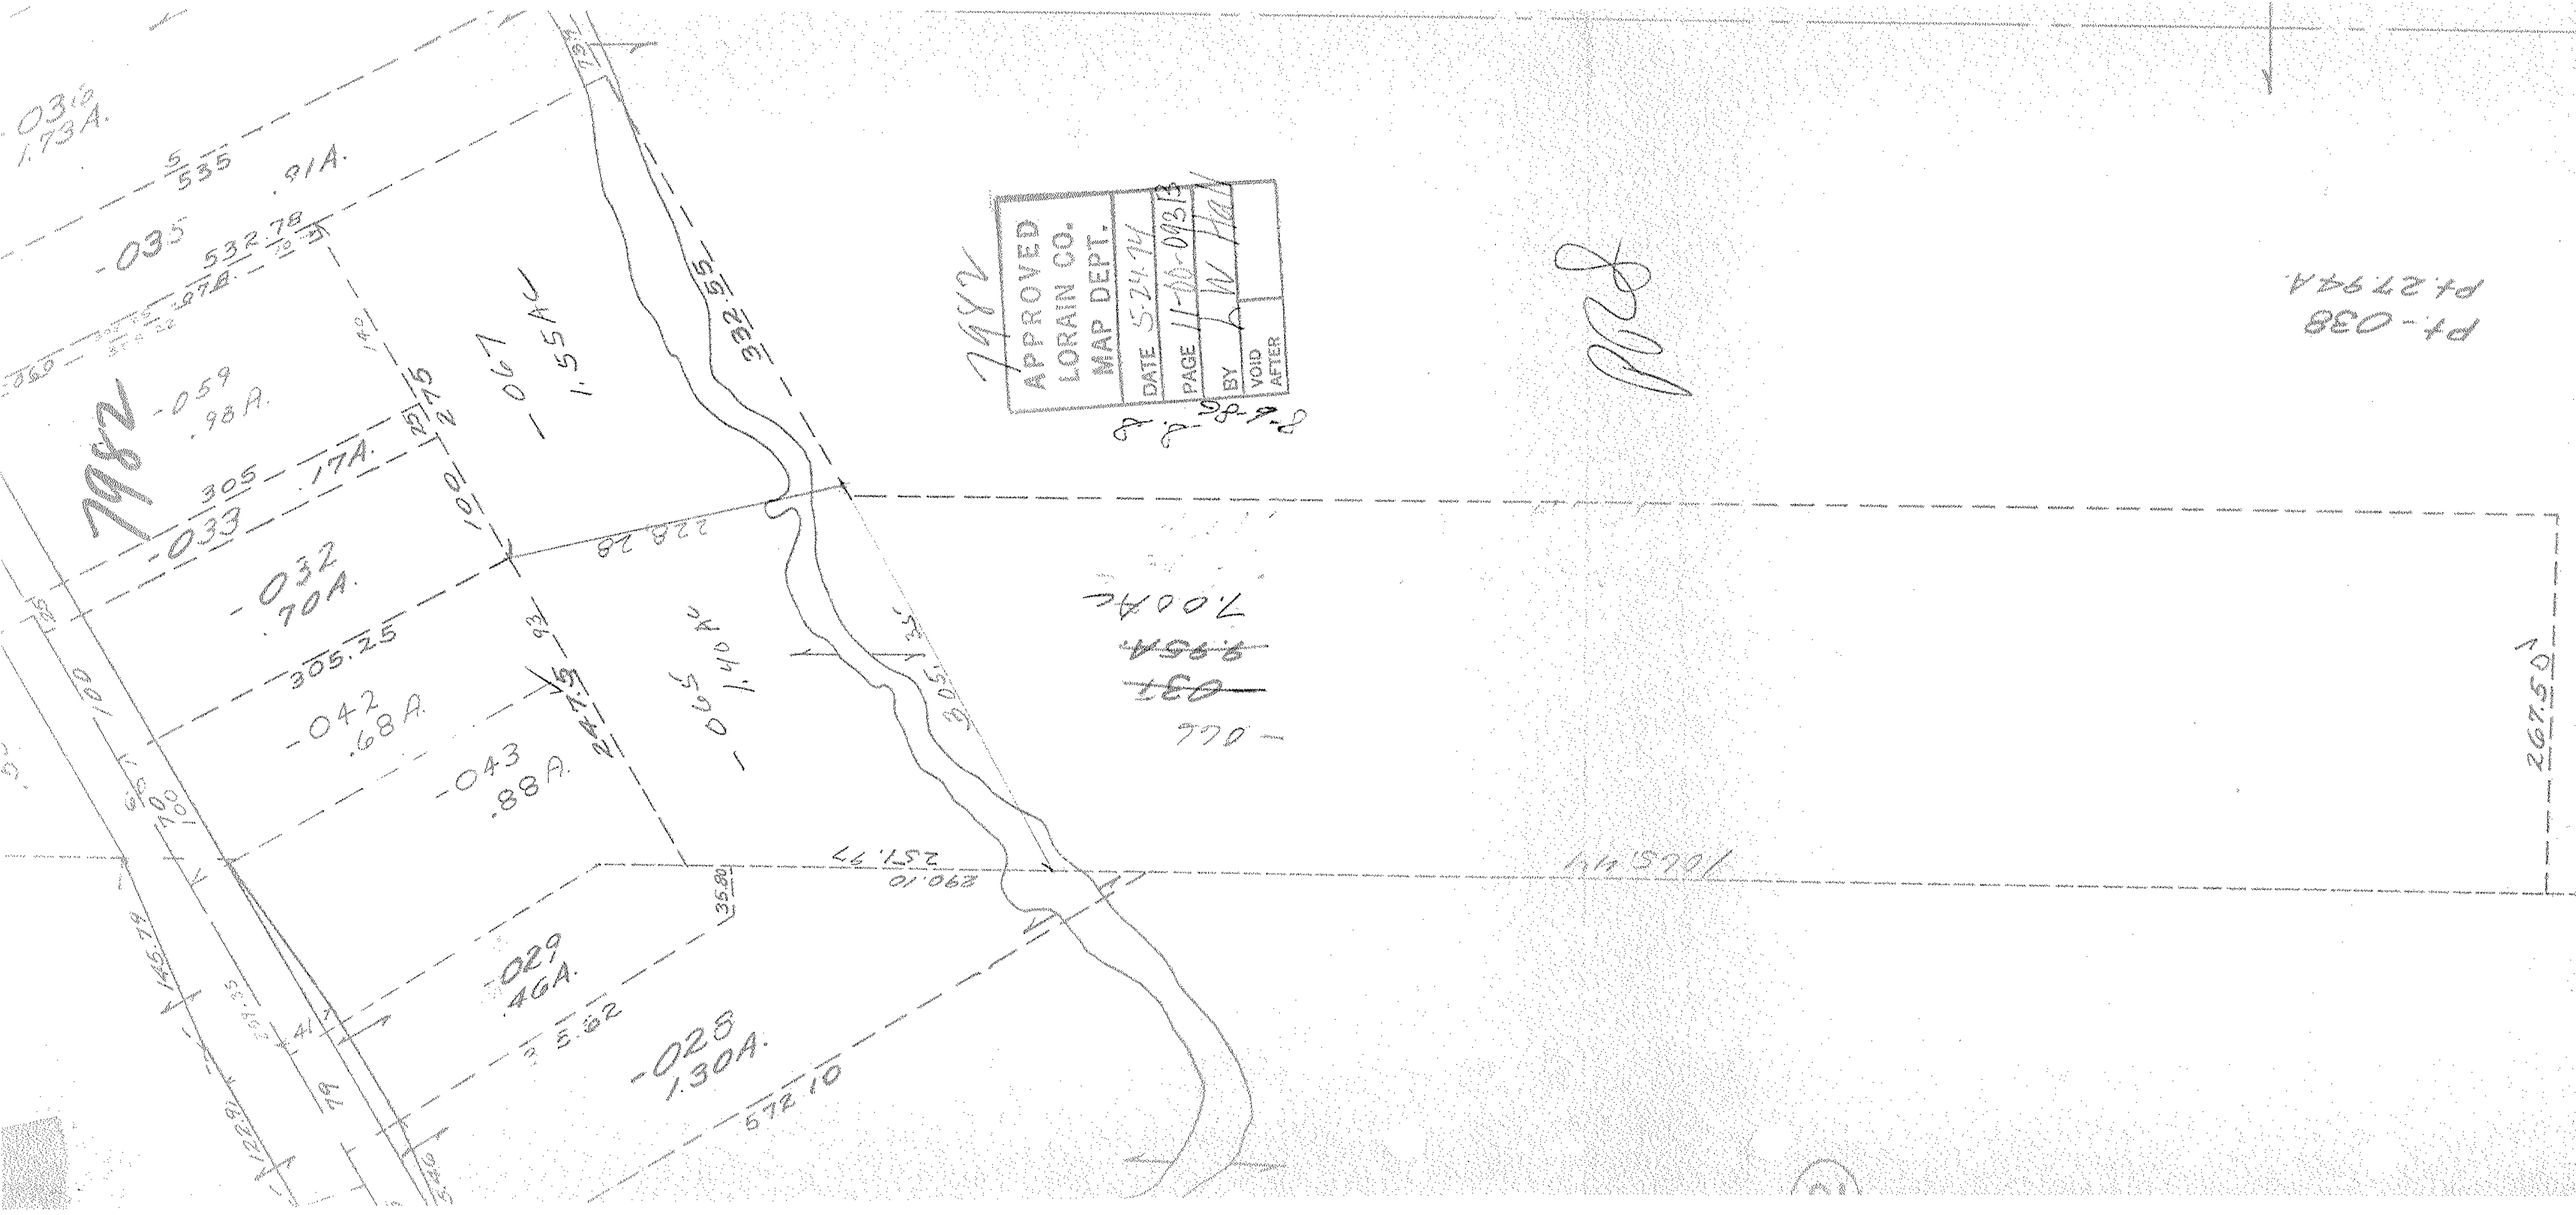
APPROVED
LORAIN CO.
MAP DEPT.
DATE 5-24-94
PAGE 11-00-0431
BY
VOID AFTER
7492
-031
1.73A.
-035
.91A.
-059
.98A.
-033
.17A.
-032
.70A.
-042
.68A.
-043
.88A.
-029
.46A.
-025
1.30A.
-067
1.55A.
-065
1.40A.
7.00Ac
Pt. -038
Pt. 27.94A.
267.50'
572.10
257.97
305.25
228.28
382.55
245.75
145.79
35.80
5.62