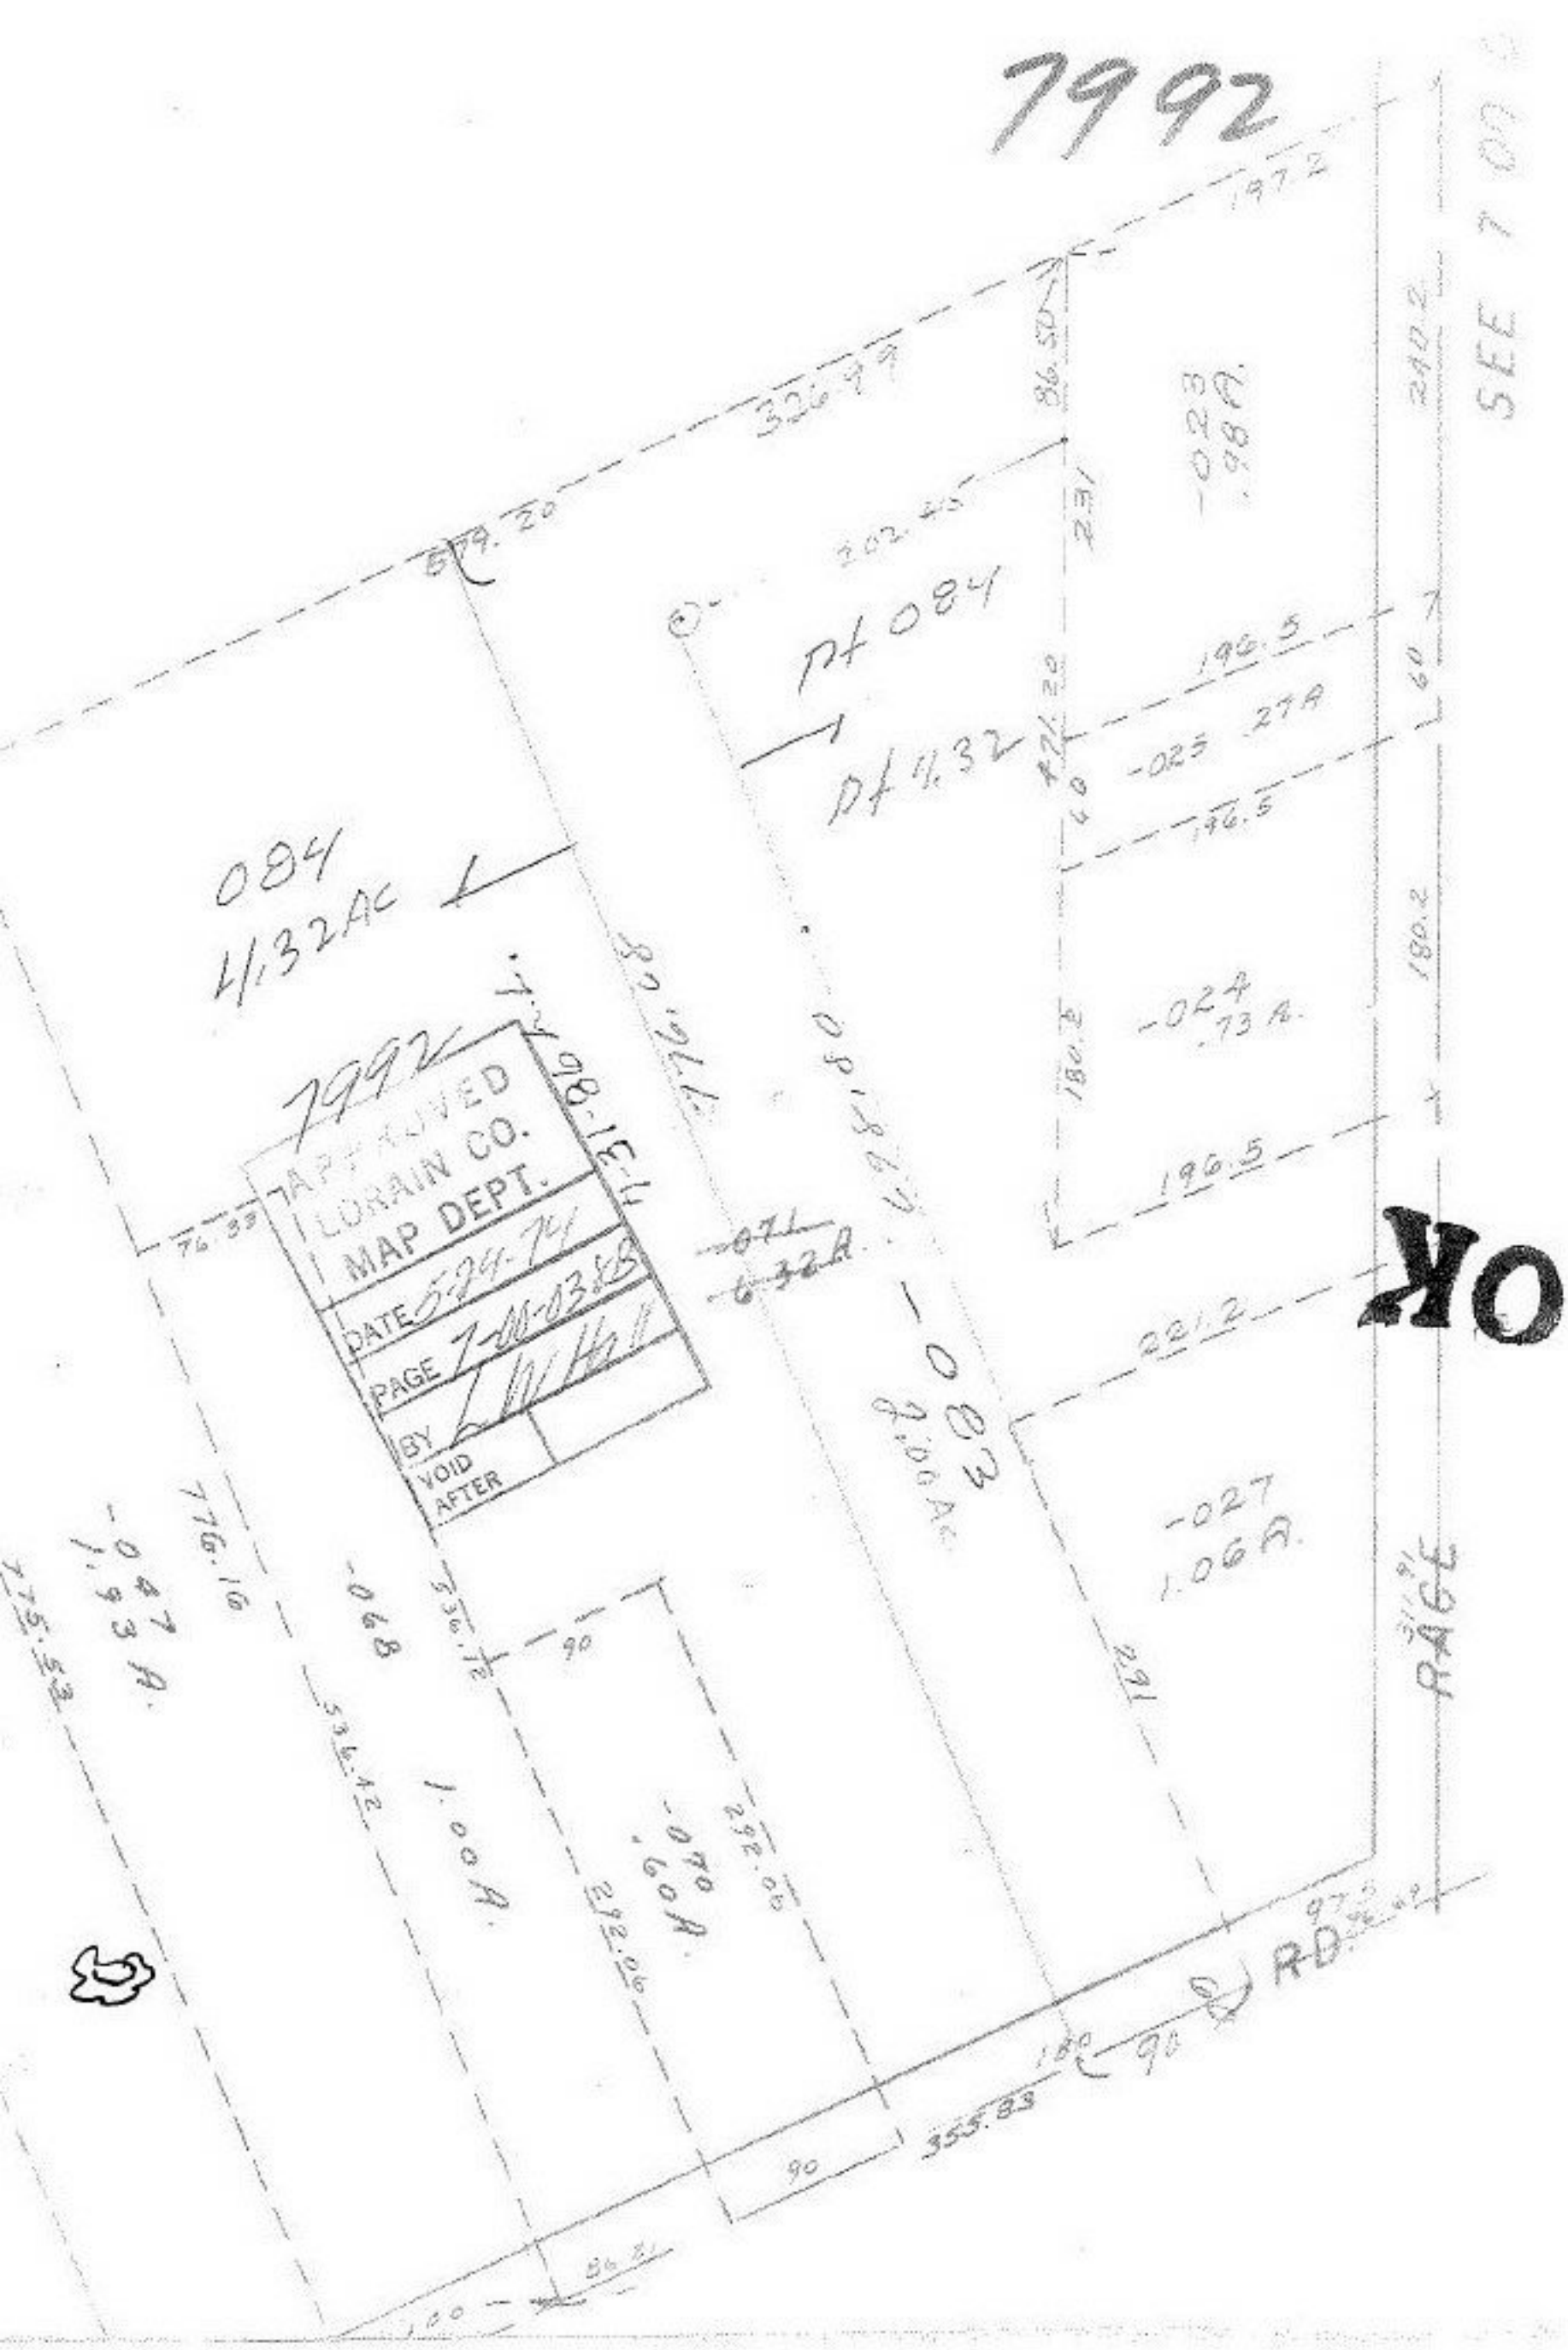
7992
SEE 7 00
197.2
326.99
86.50
-023
.98A.
240.2
579.20
202.45
231
Pt 084
196.5
Pt 4.32
-025 .27A
60
196.5
084
4.32AC
180.2
-024
.73A.
180.2
196.5
7992
APPROVED
LORAIN CO.
MAP DEPT.
DATE 5-24-74
PAGE 7-00-038B
BY
VOID AFTER
76.33
-071
6.32A.
-083
2.00AC
221.2
OK
-027
1.06A.
776.16
-047
1.93A.
775.53
-068
536.12
90
291
RAGE
536.42
1.00A.
-070
.60A.
292.06
292.06
RD.
90
180
355.83
90
86.81
100