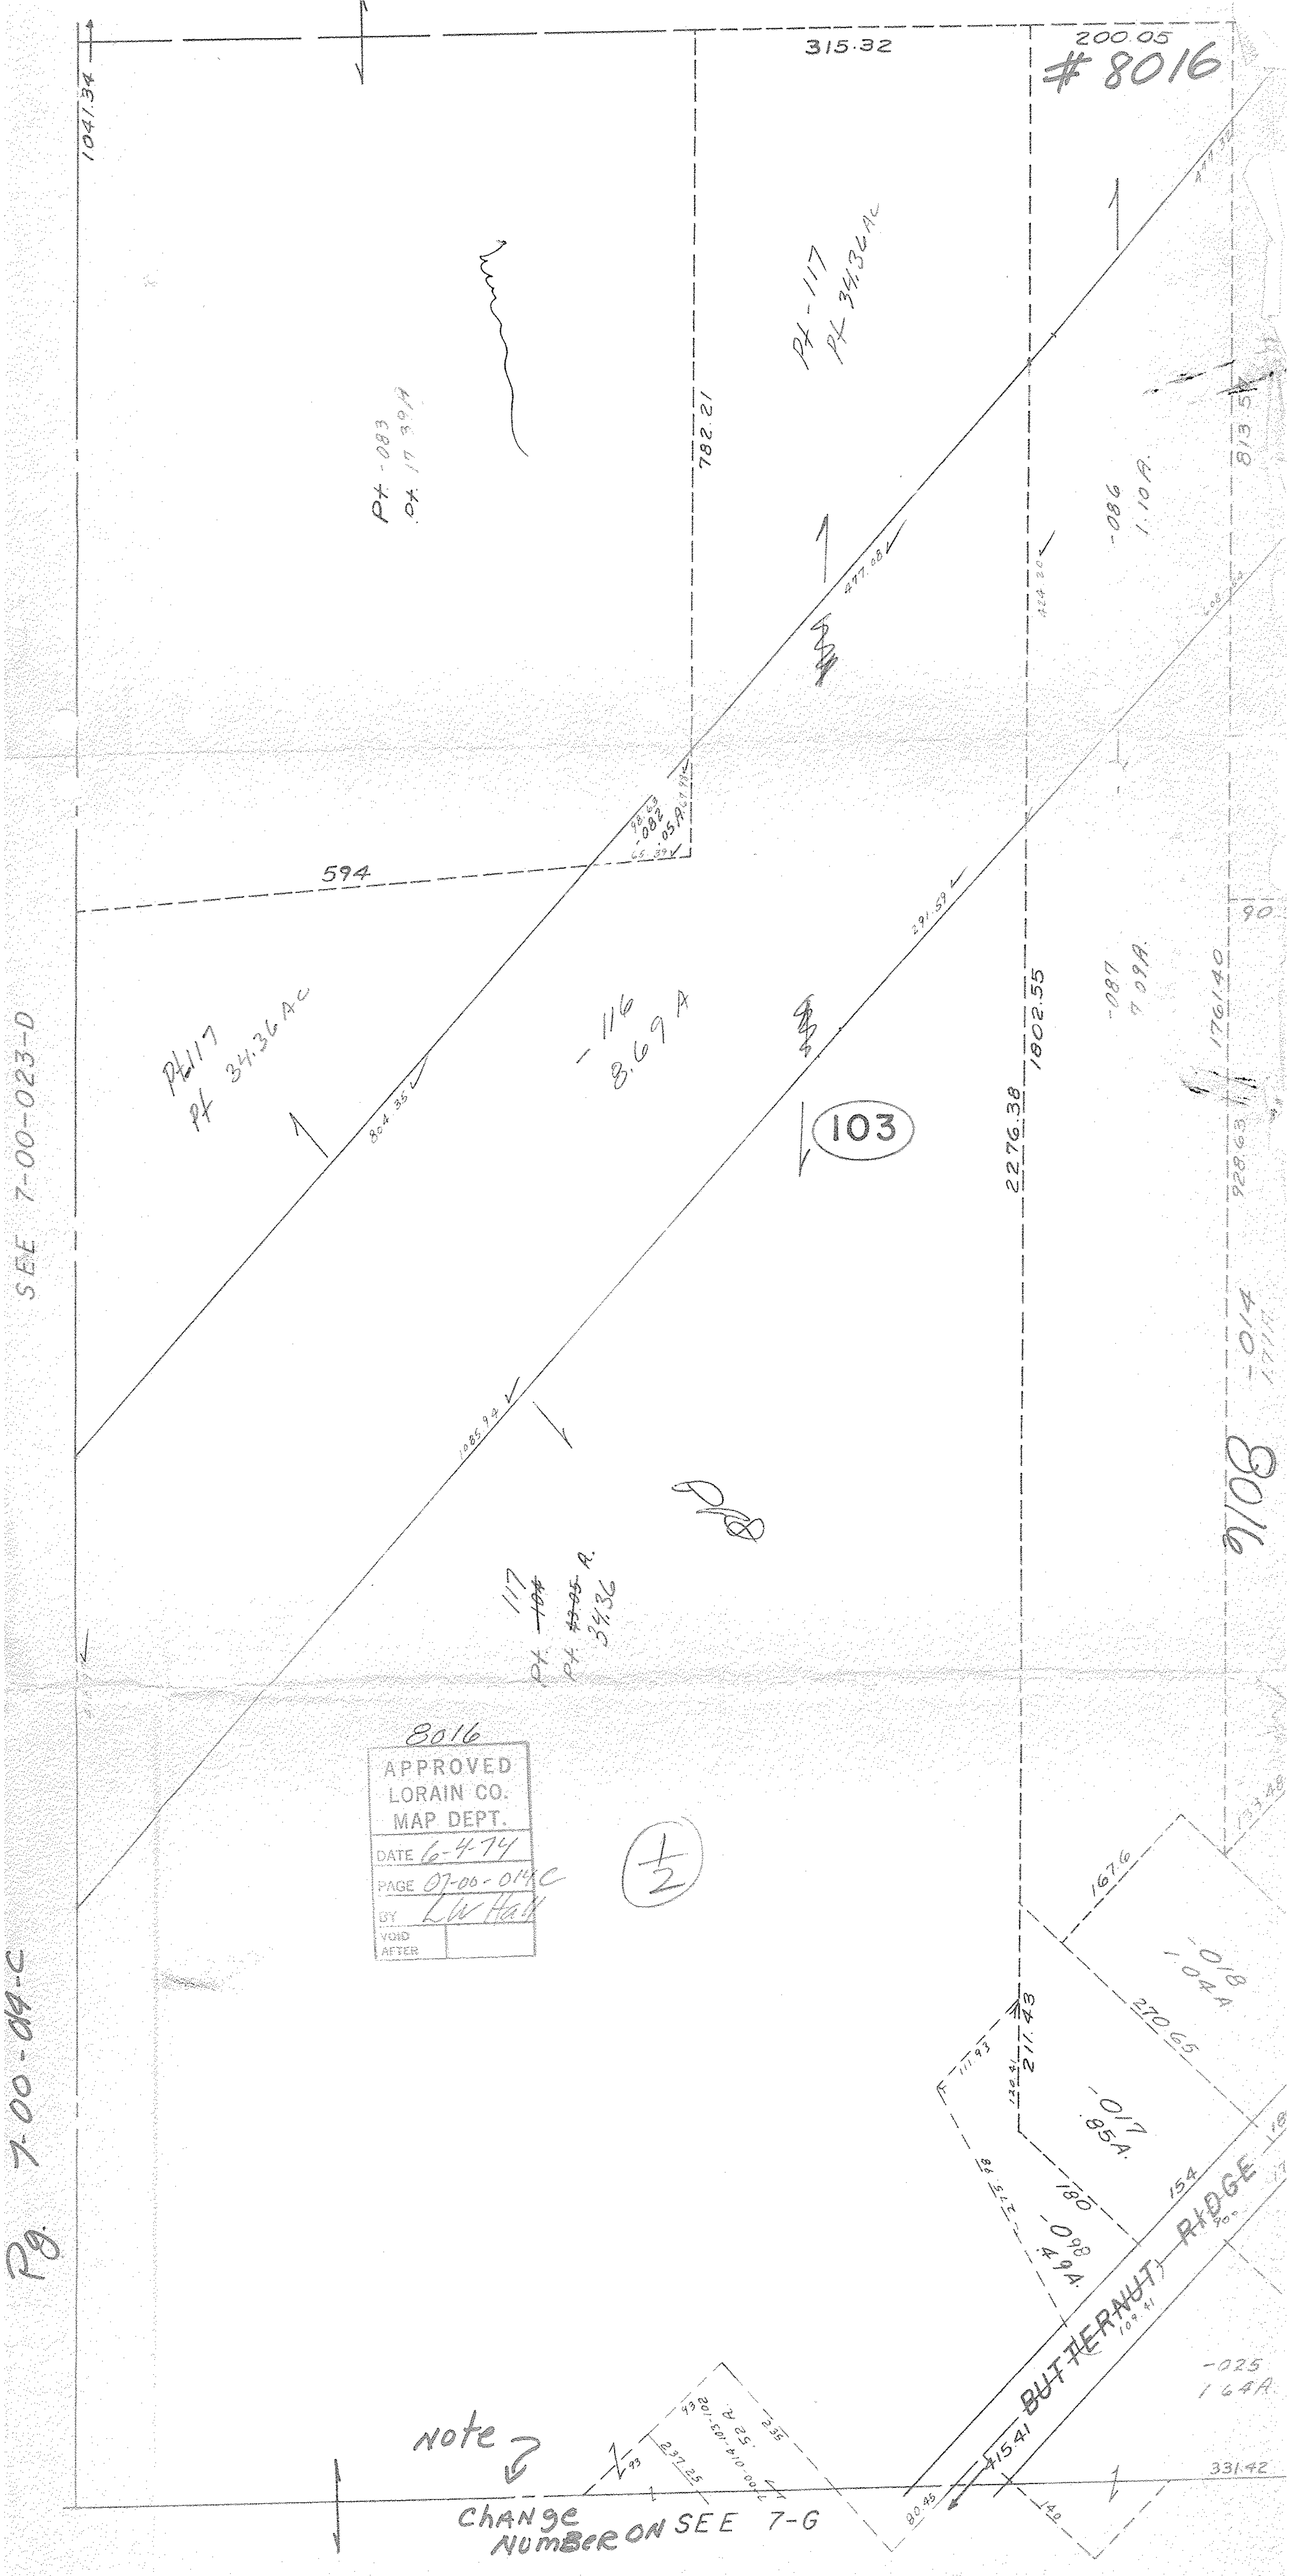

315.32
200.05
8016
1041.34
Pt -117
Pt 34.36 Ac
Pt -083
Pt 17.39 A
782.21
813.5
-086
1.10 A.
477.08
594
291.59
Pt 117
Pt 34.36 Ac
-116
8.69 A
804.35
103
2276.38
1802.55
-087
7.09 A.
1761.40
928.63
SEE 7-00-023-D
-014
8016
1085.94
117
Pt. 34.36 A.
8016
APPROVED
LORAIN CO.
MAP DEPT.
DATE 6-4-74
PAGE 07-00-014C
BY LW Hall
VOID
AFTER
1/2
167.6
-018
1.04 A
270.65
211.43
-017
.85 A.
180
-098
.49 A.
154
BUTTERNUT RIDGE
-025
1.64 A.
415.41
331.42
Note
Change
Number ON SEE 7-G
Pg. 7-00-014-C