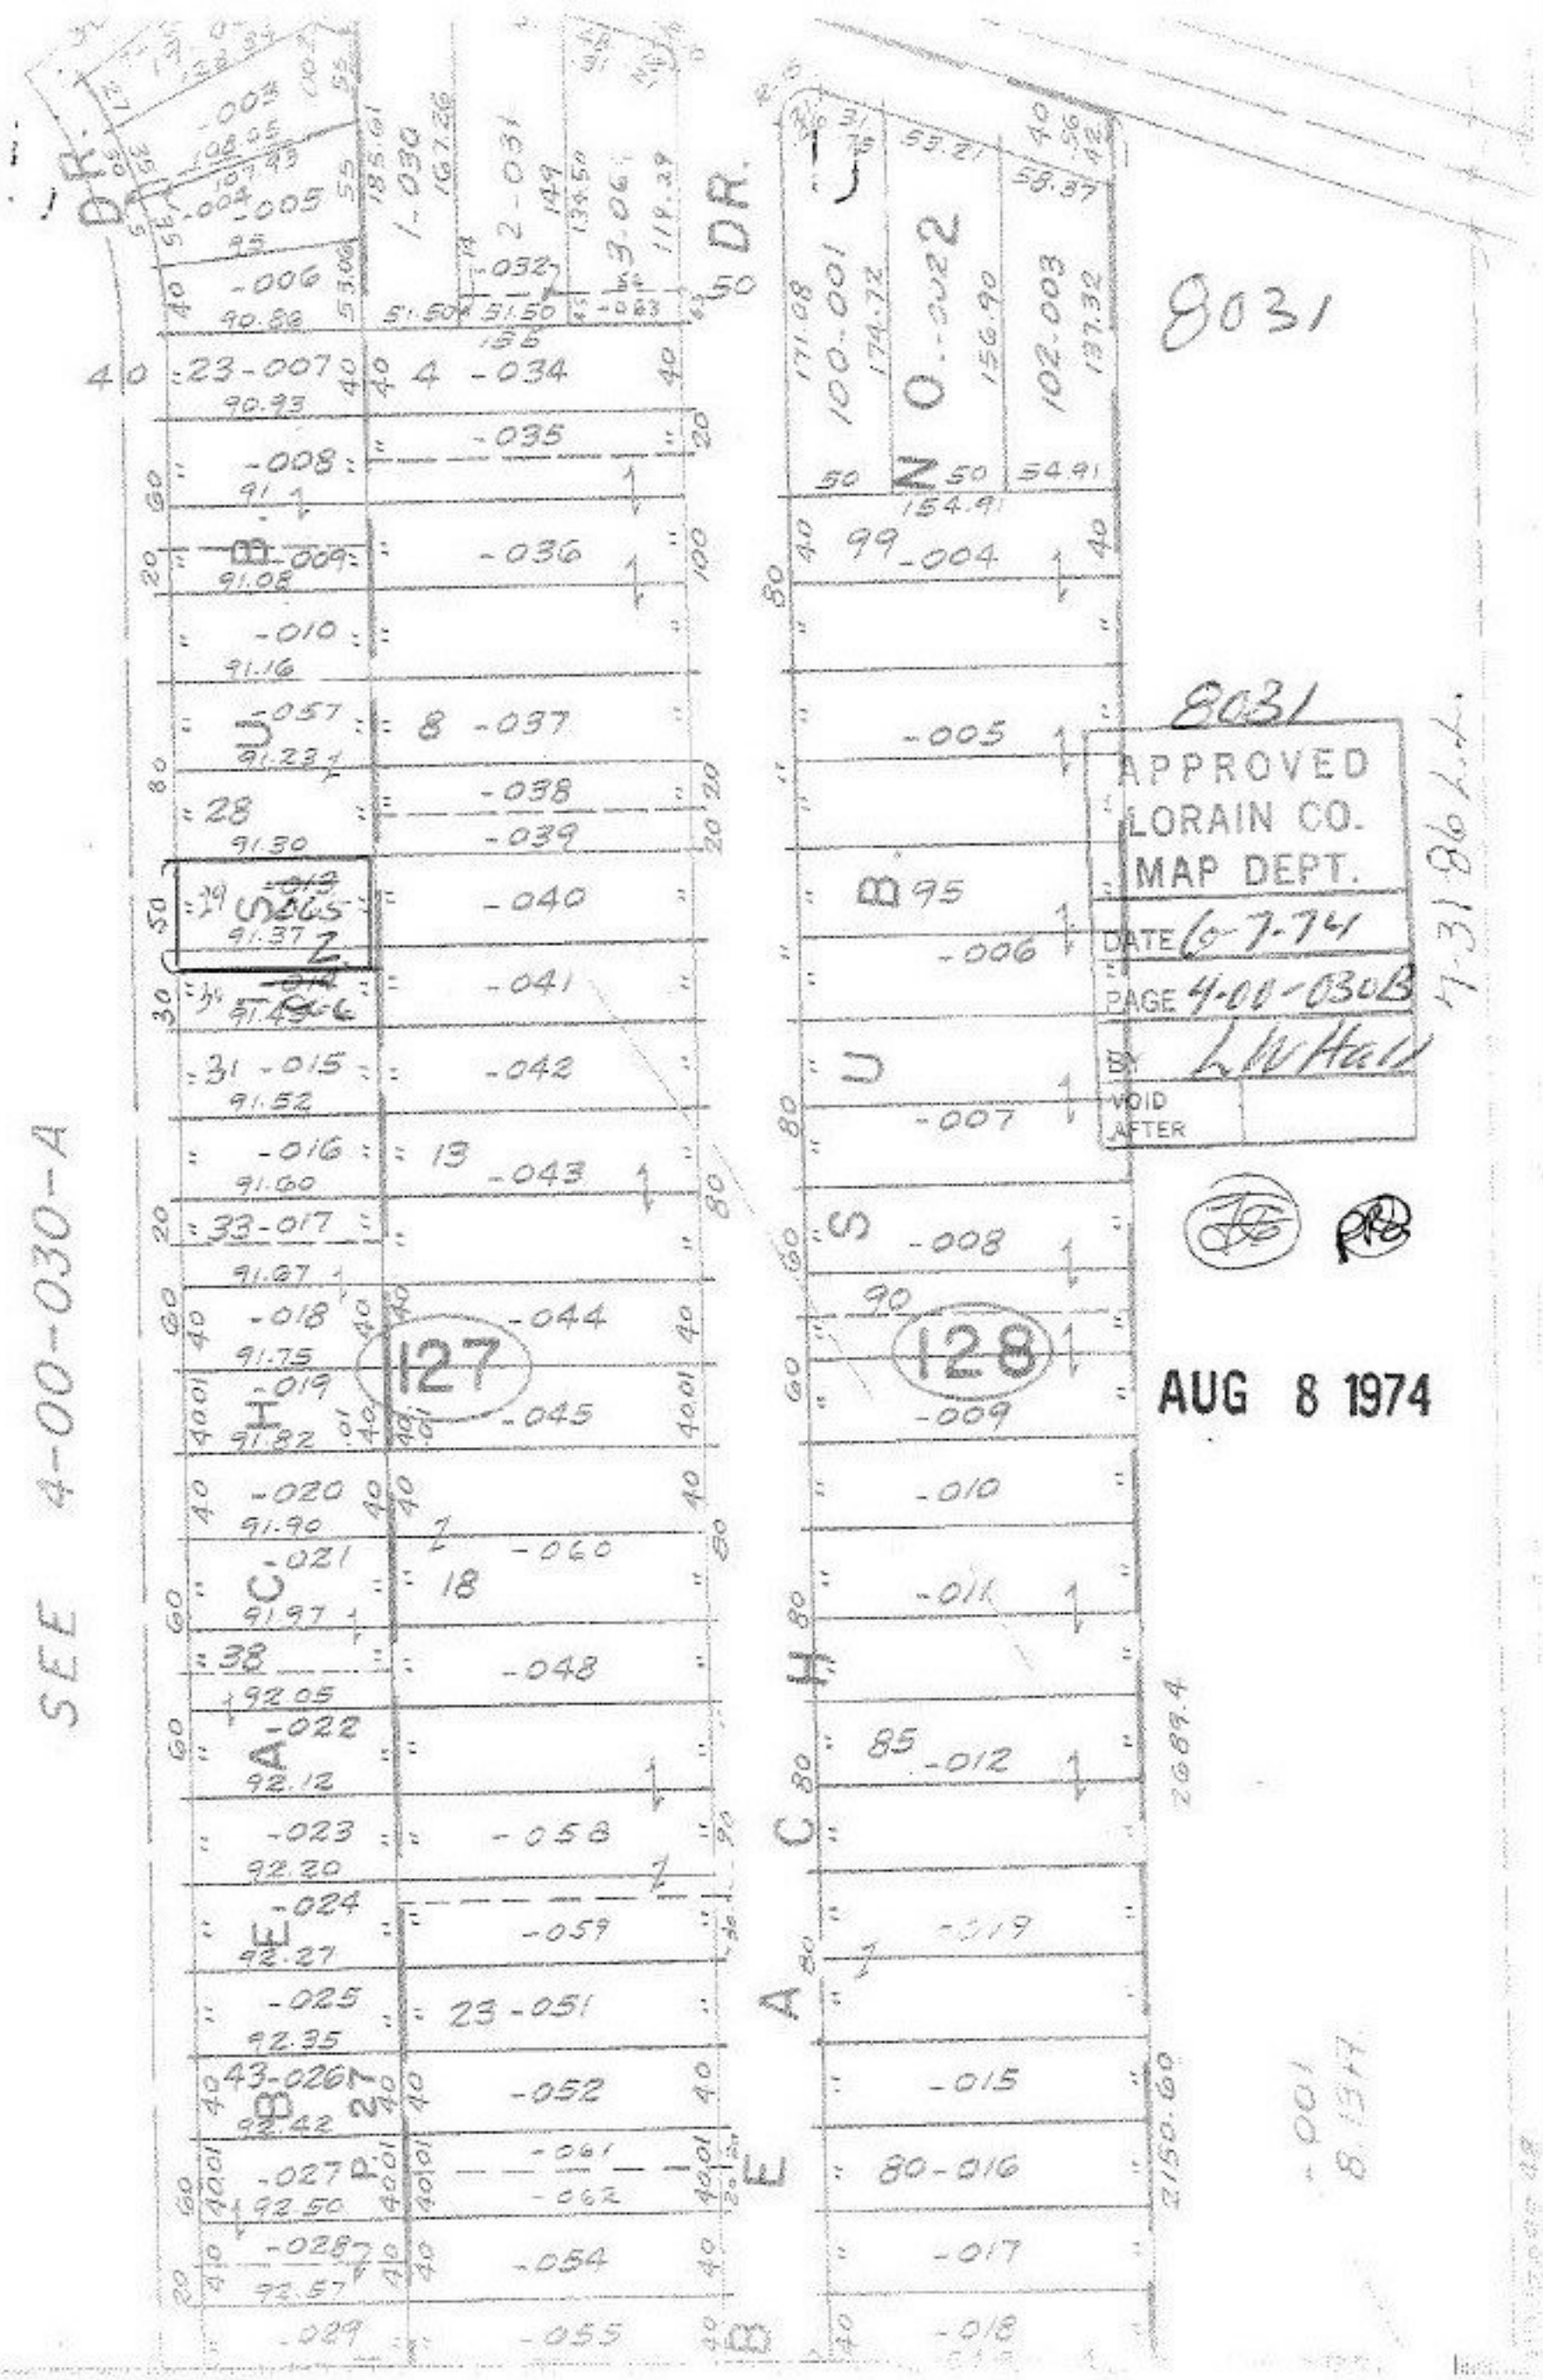

8031
8031
APPROVED
LORAIN CO.
MAP DEPT.
DATE 6-7-74
PAGE 4-00-030B
BY L.W. Hall
VOID AFTER
AUG 8 1974
SEE 4-00-030-A
127
128
DR.
DR.