8038/1

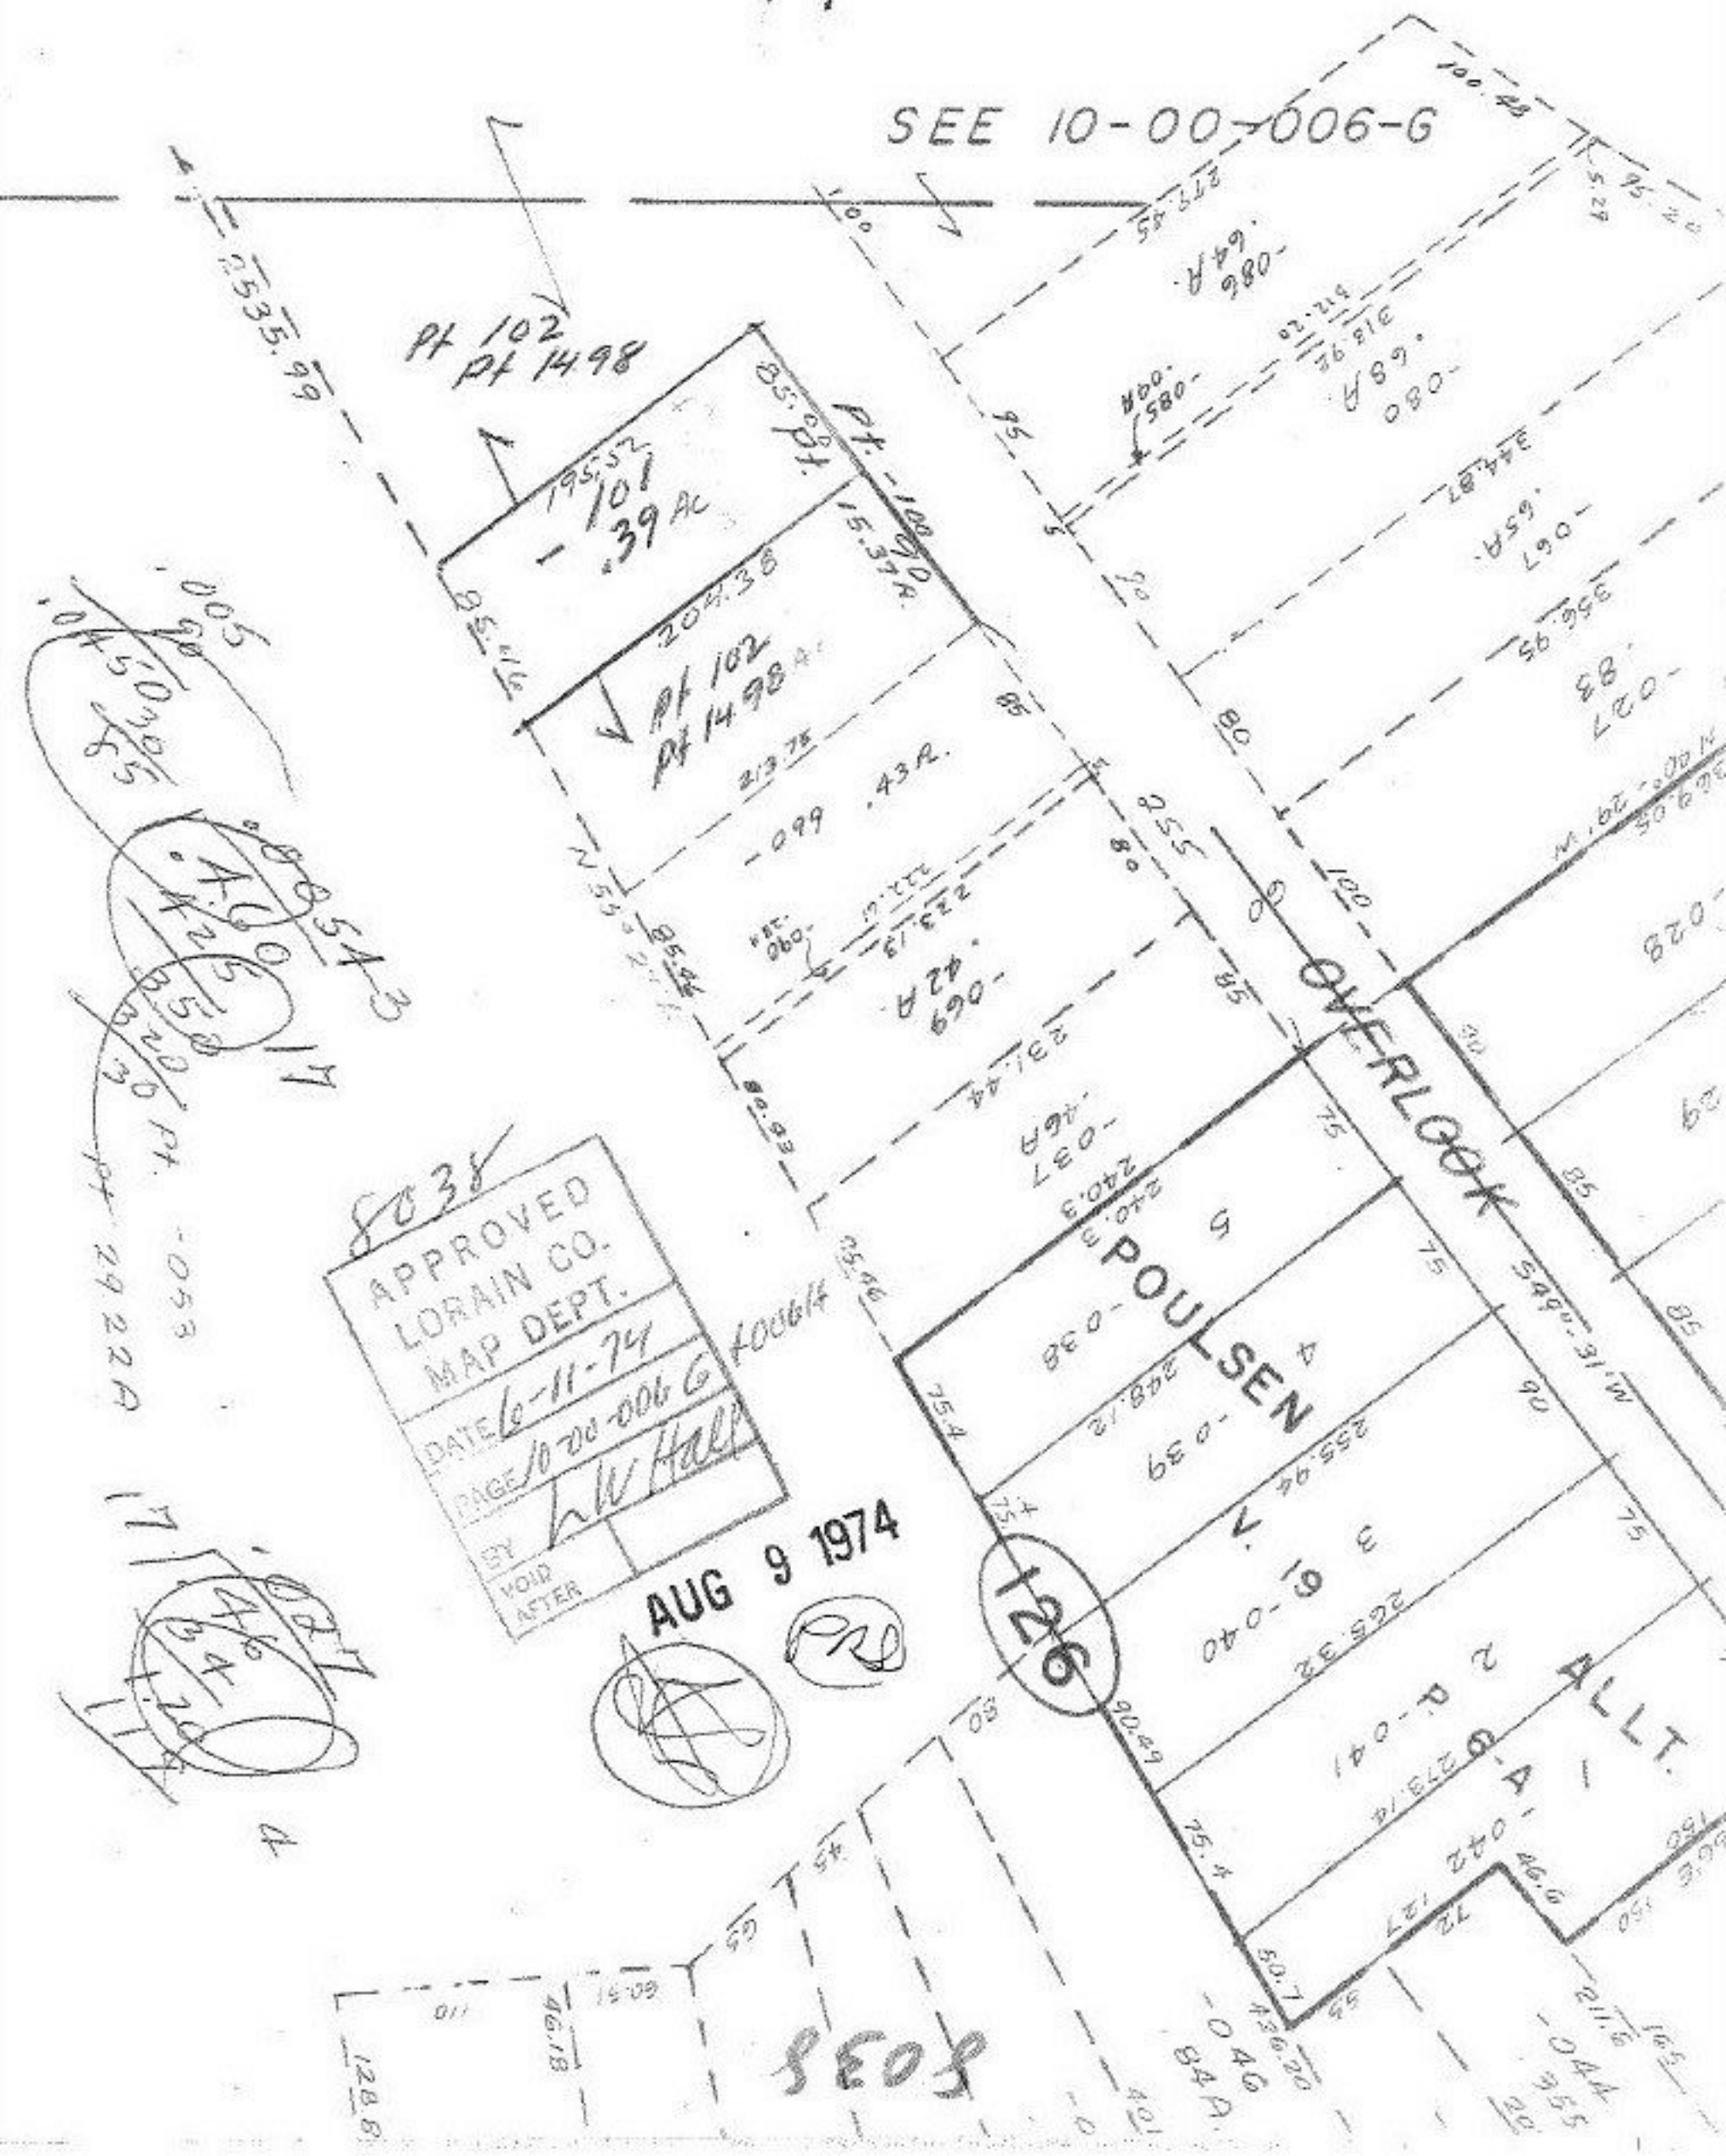
SEE 10-00-006-G
Pt 102
Pt 1498
2535.99
195.52
101
.39 Ac
204.38
Pt 102
Pt 1498
213.75
.43 A.
.069
.42 A
OVERLOOK
POULSEN
ALLT.
126
APPROVED
LORAIN CO.
MAP DEPT.
DATE 6-11-74
PAGE 10-00-006 G
BY LW Hall
VOID AFTER
AUG 9 1974
8038