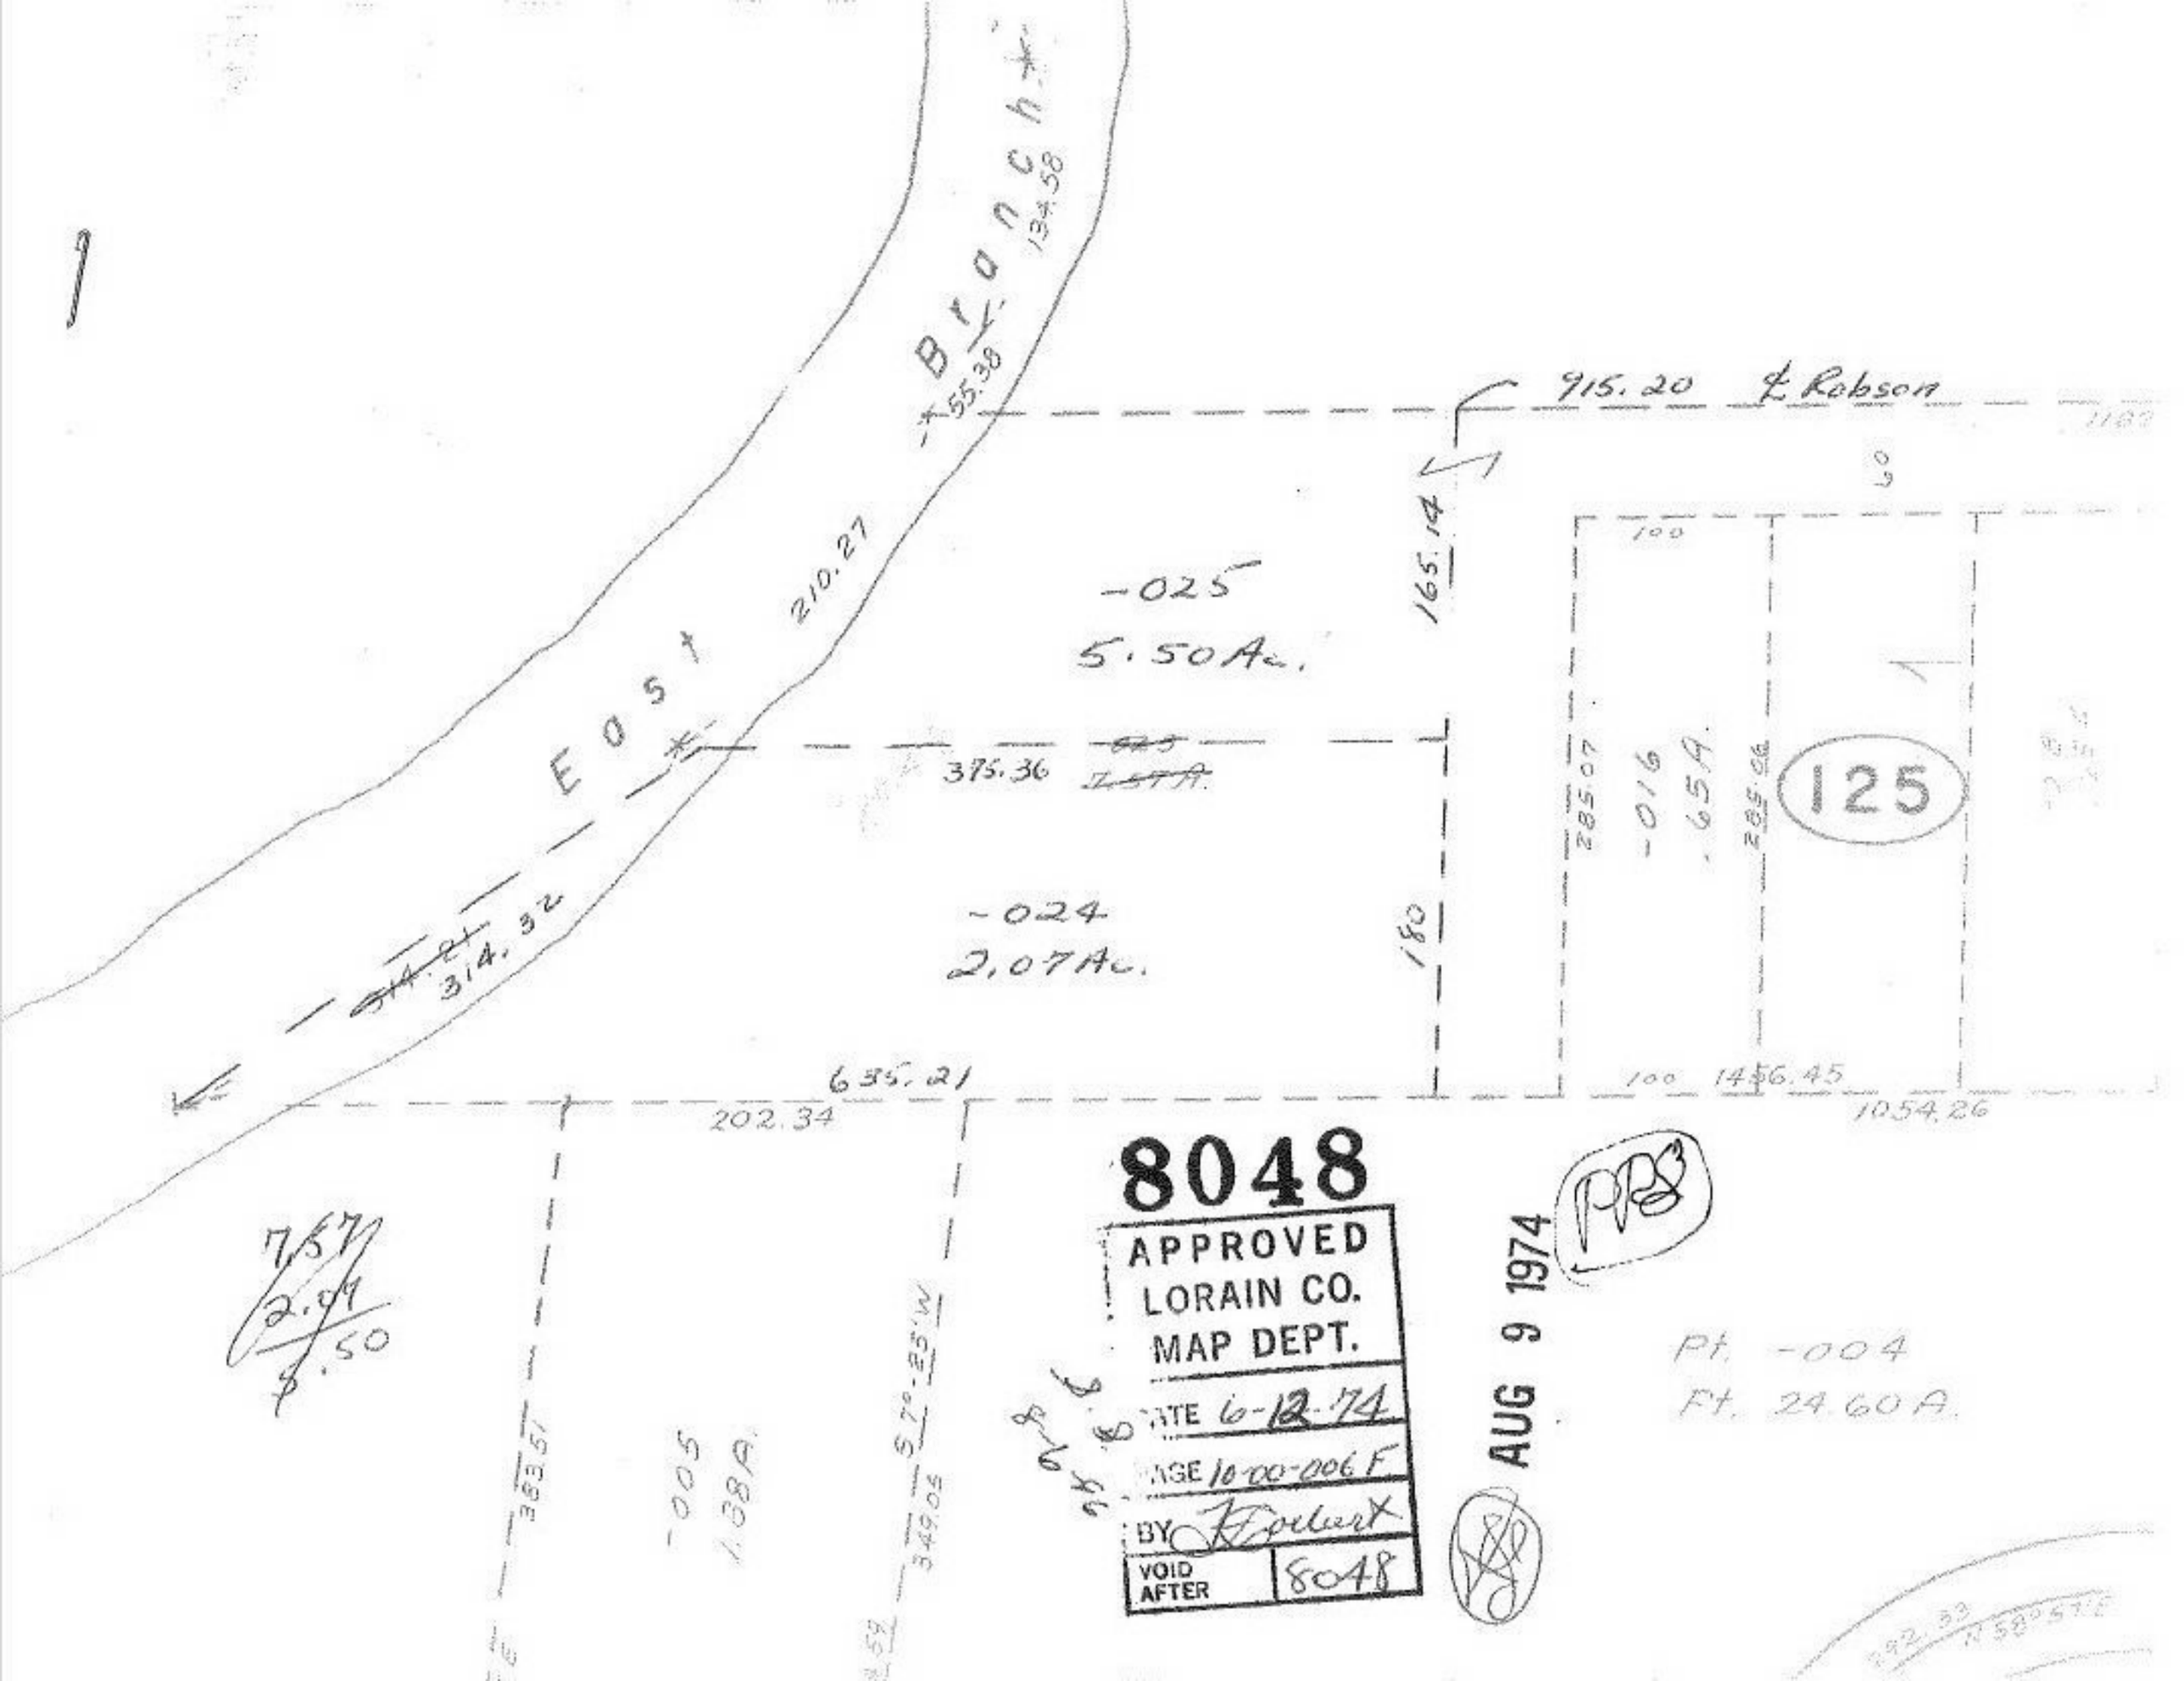

8048

APPROVED
LORAIN CO.
MAP DEPT.
DATE 6-12-74
PAGE 10-00-006 F
BY [signature]
VOID AFTER 8048

AUG 9 1974

PPS