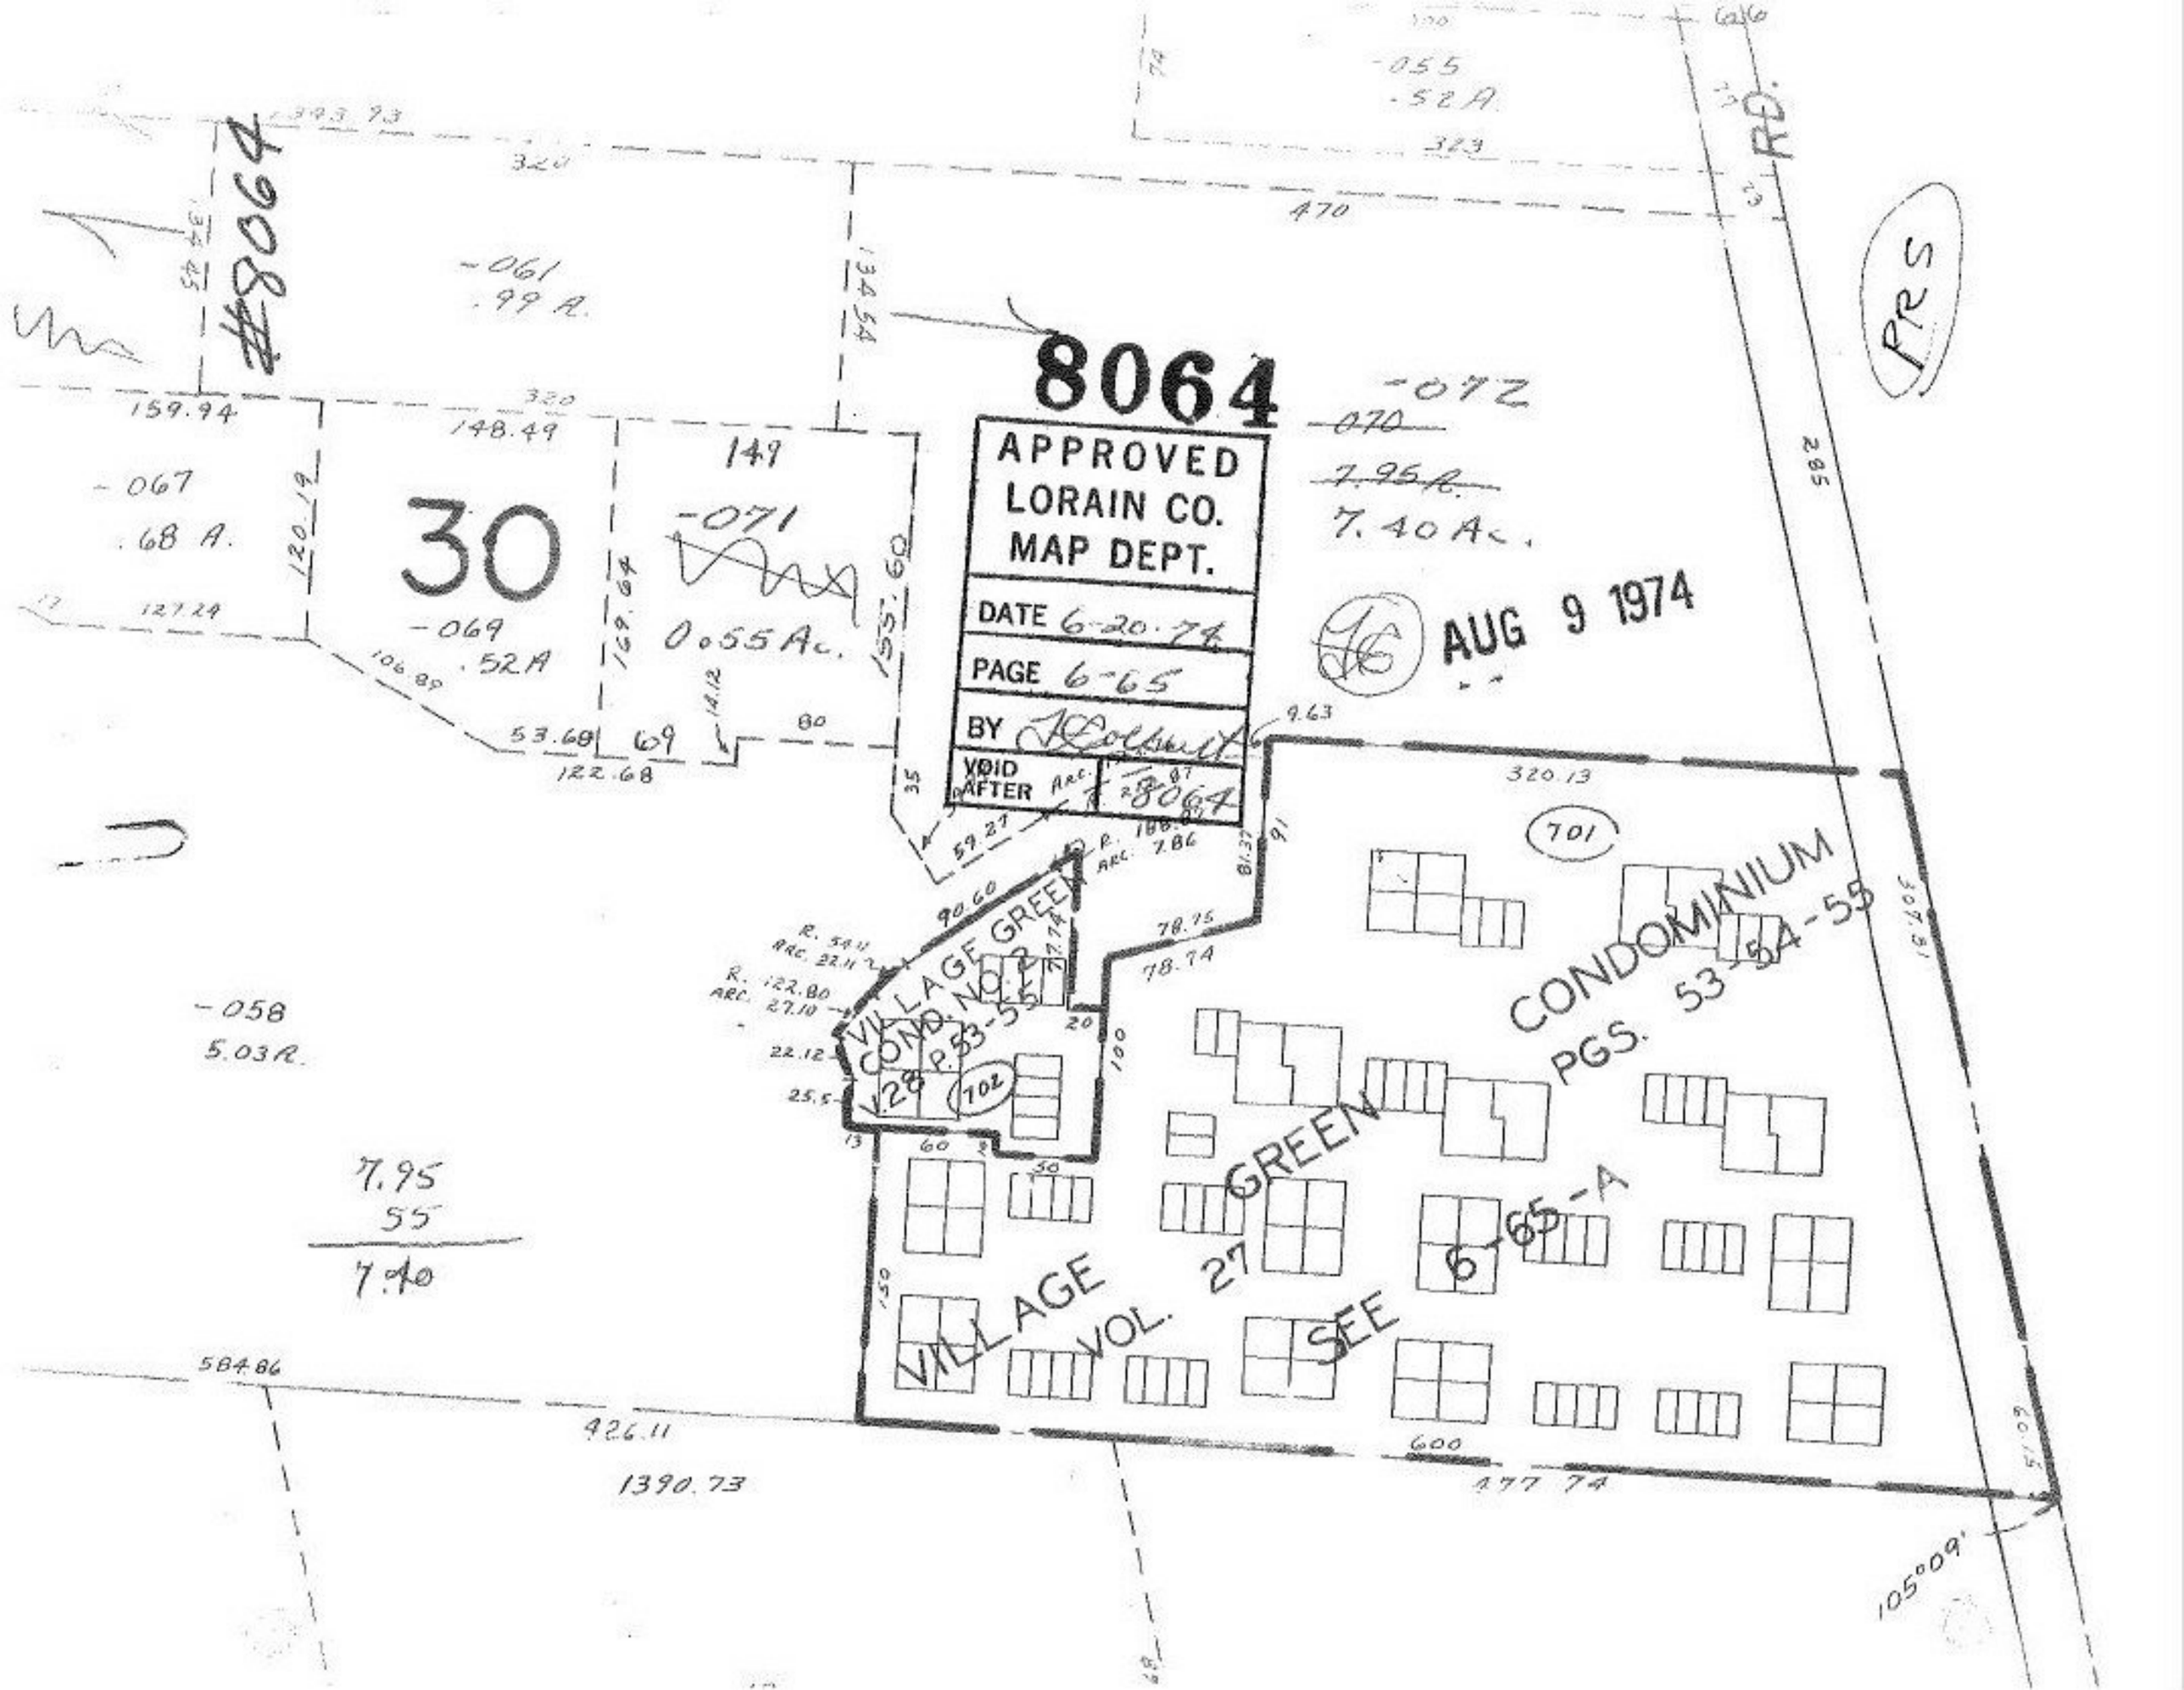

8064
APPROVED
LORAIN CO.
MAP DEPT.
DATE 6-20-74
PAGE 6-65
BY
VOID AFTER
AUG 9 1974
PRS
RD.
#8064
30
-061
.99 A.
-067
.68 A.
-069
.52A
-071
0.55 Ac.
-072
~~.070~~
~~7.95 A.~~
7.40 Ac.
-055
.52A
-058
5.03A.
7.95
55
7.40
VILLAGE GREEN
COND. NO. 2
V.28 P.53-55
VILLAGE GREEN
VOL. 27
CONDOMINIUM
PGS. 53-54-55
SEE 6-65-A
701
702