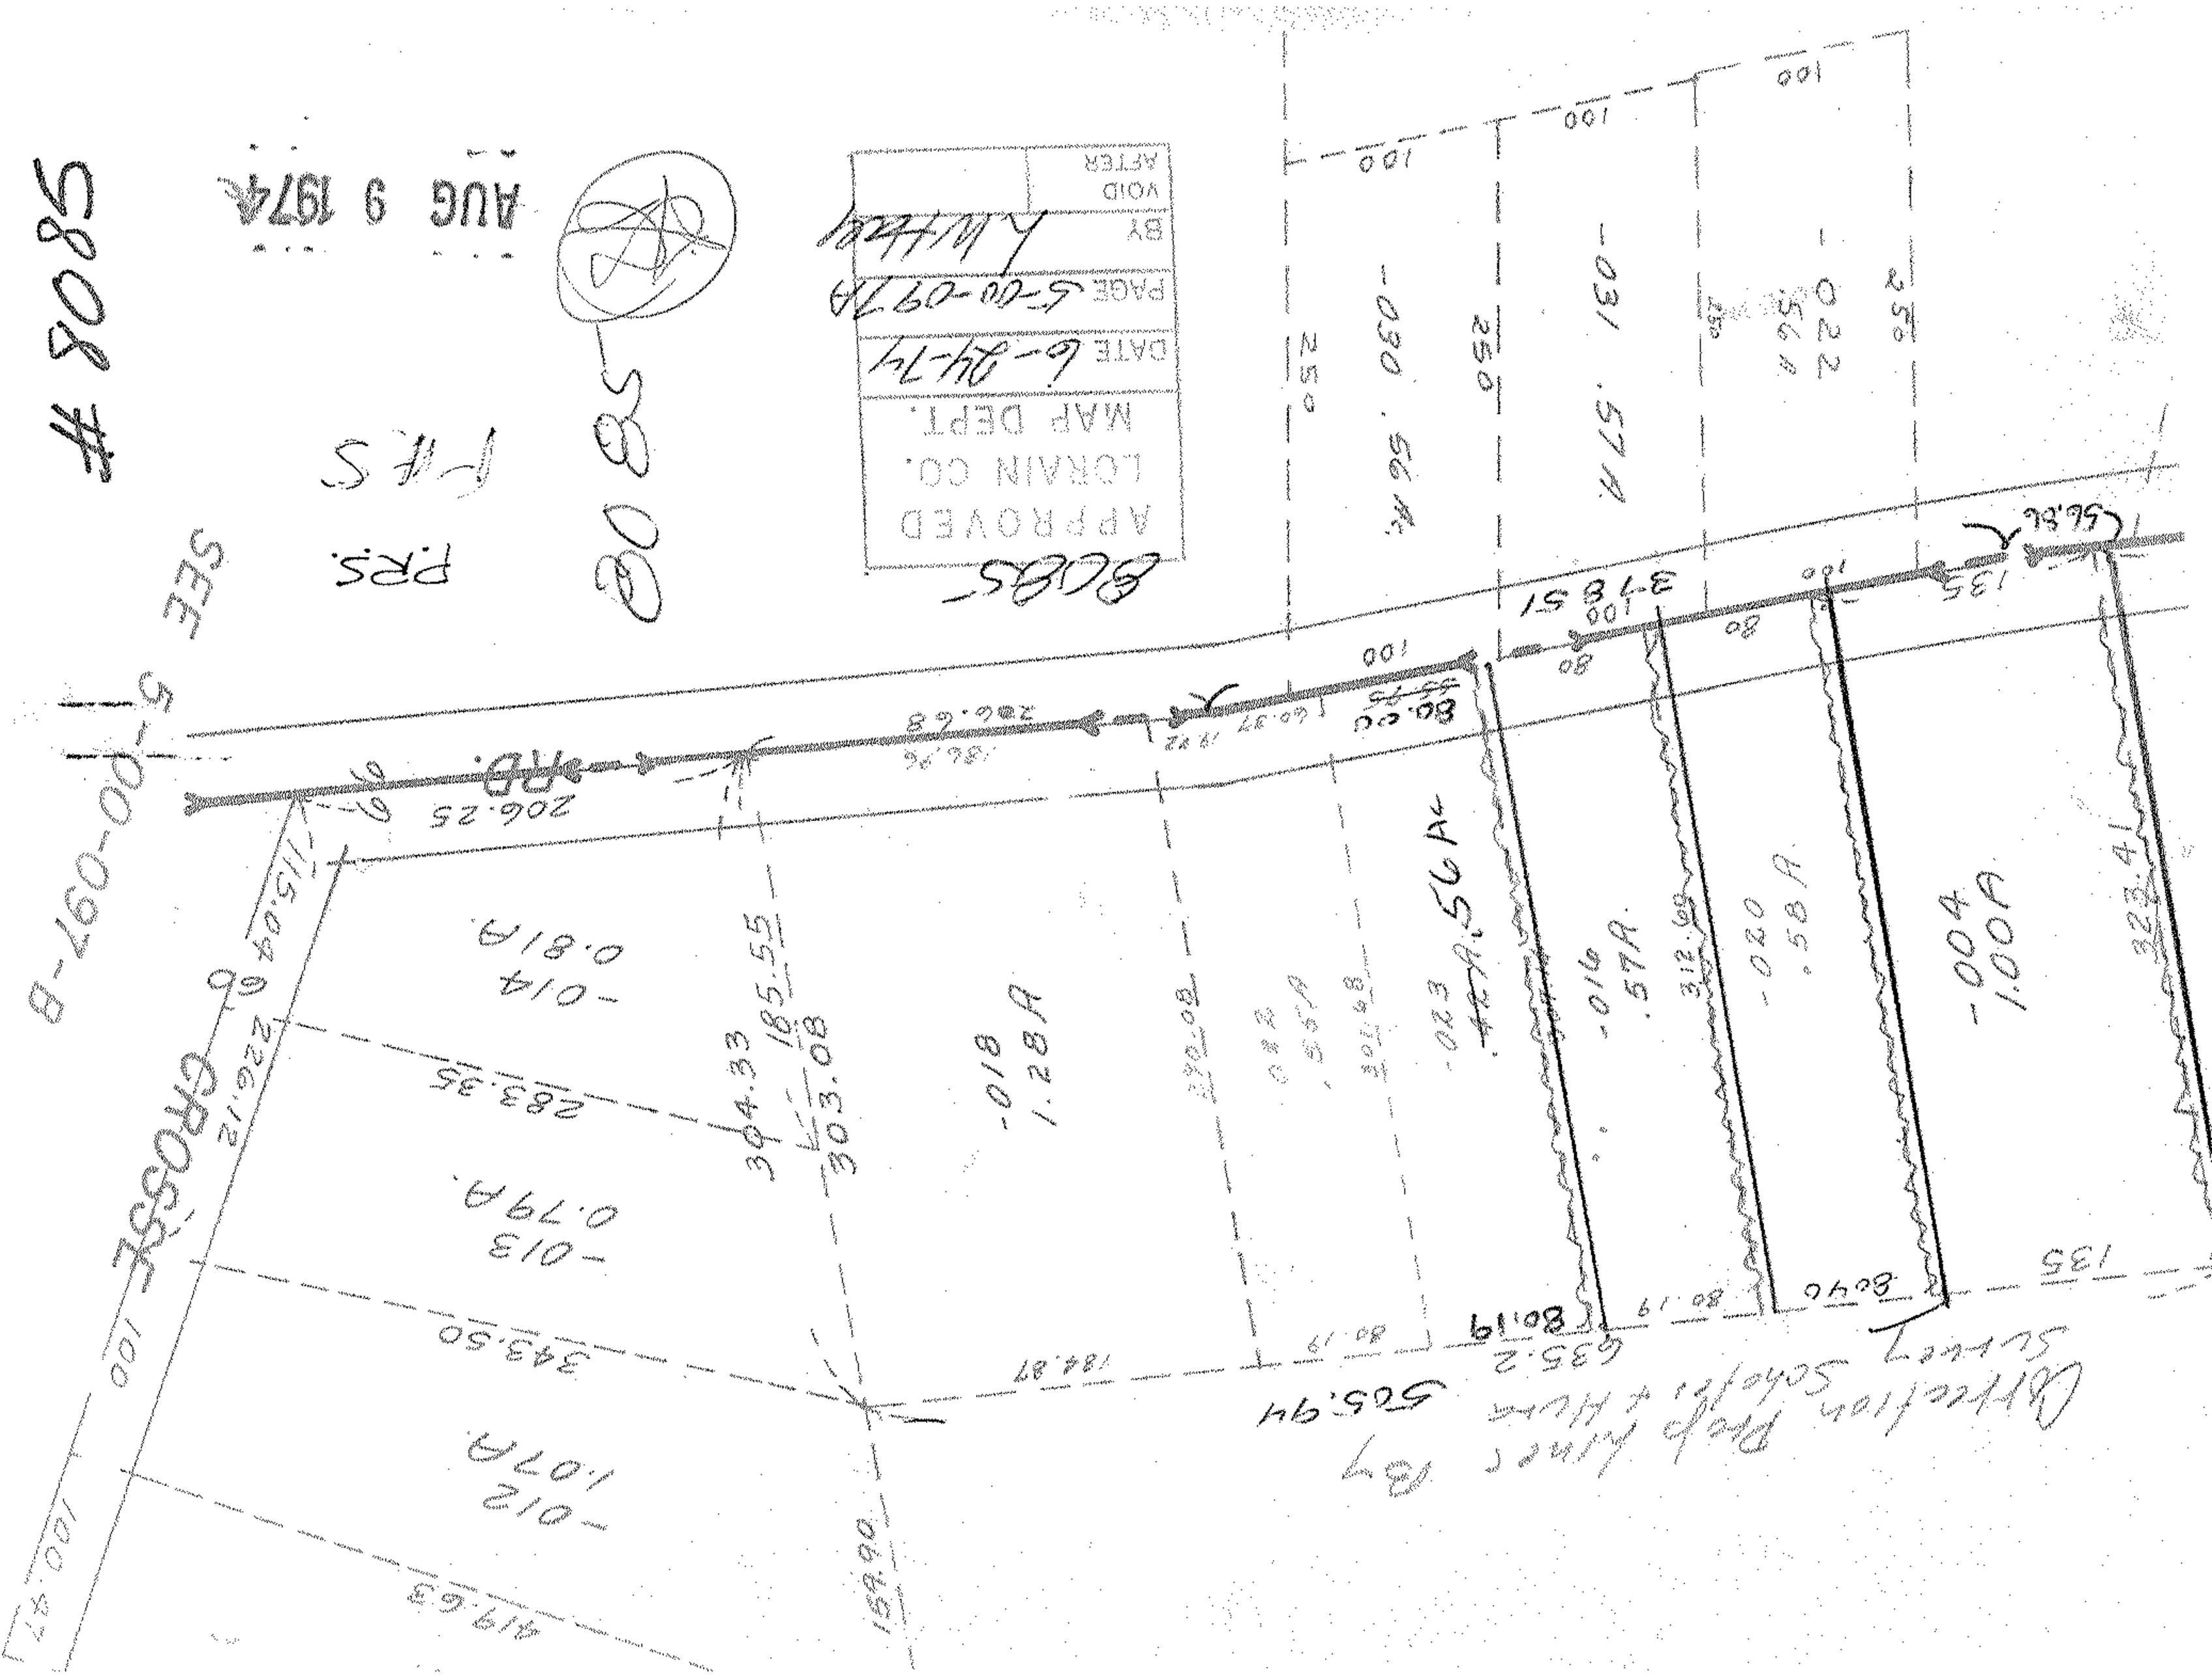

#8085
AUG 9 1974
8085
APPROVED
LORAIN CO.
MAP DEPT.
DATE 6-24-74
PAGE 5-00-097A
BY
VOID
AFTER
P.R.S.
SEE 5-00-097-B
GROSSE
RD.
206.25
206.68
186.96
115.04
226.12
283.35
343.50
419.63
304.33
185.55
303.08
-014
0.81A
-013
0.79A
-012
1.07A
-018
1.28A
-023
.56A
-016
.57A
-020
.58A
-004
1.00A
-030
.56A
-031
.57A
-022
.56A
80.19
635.2
505.94
184.87
159.90
80.19
80.40
135
Correction Prop Lines By Survey
Schafer & Hurst