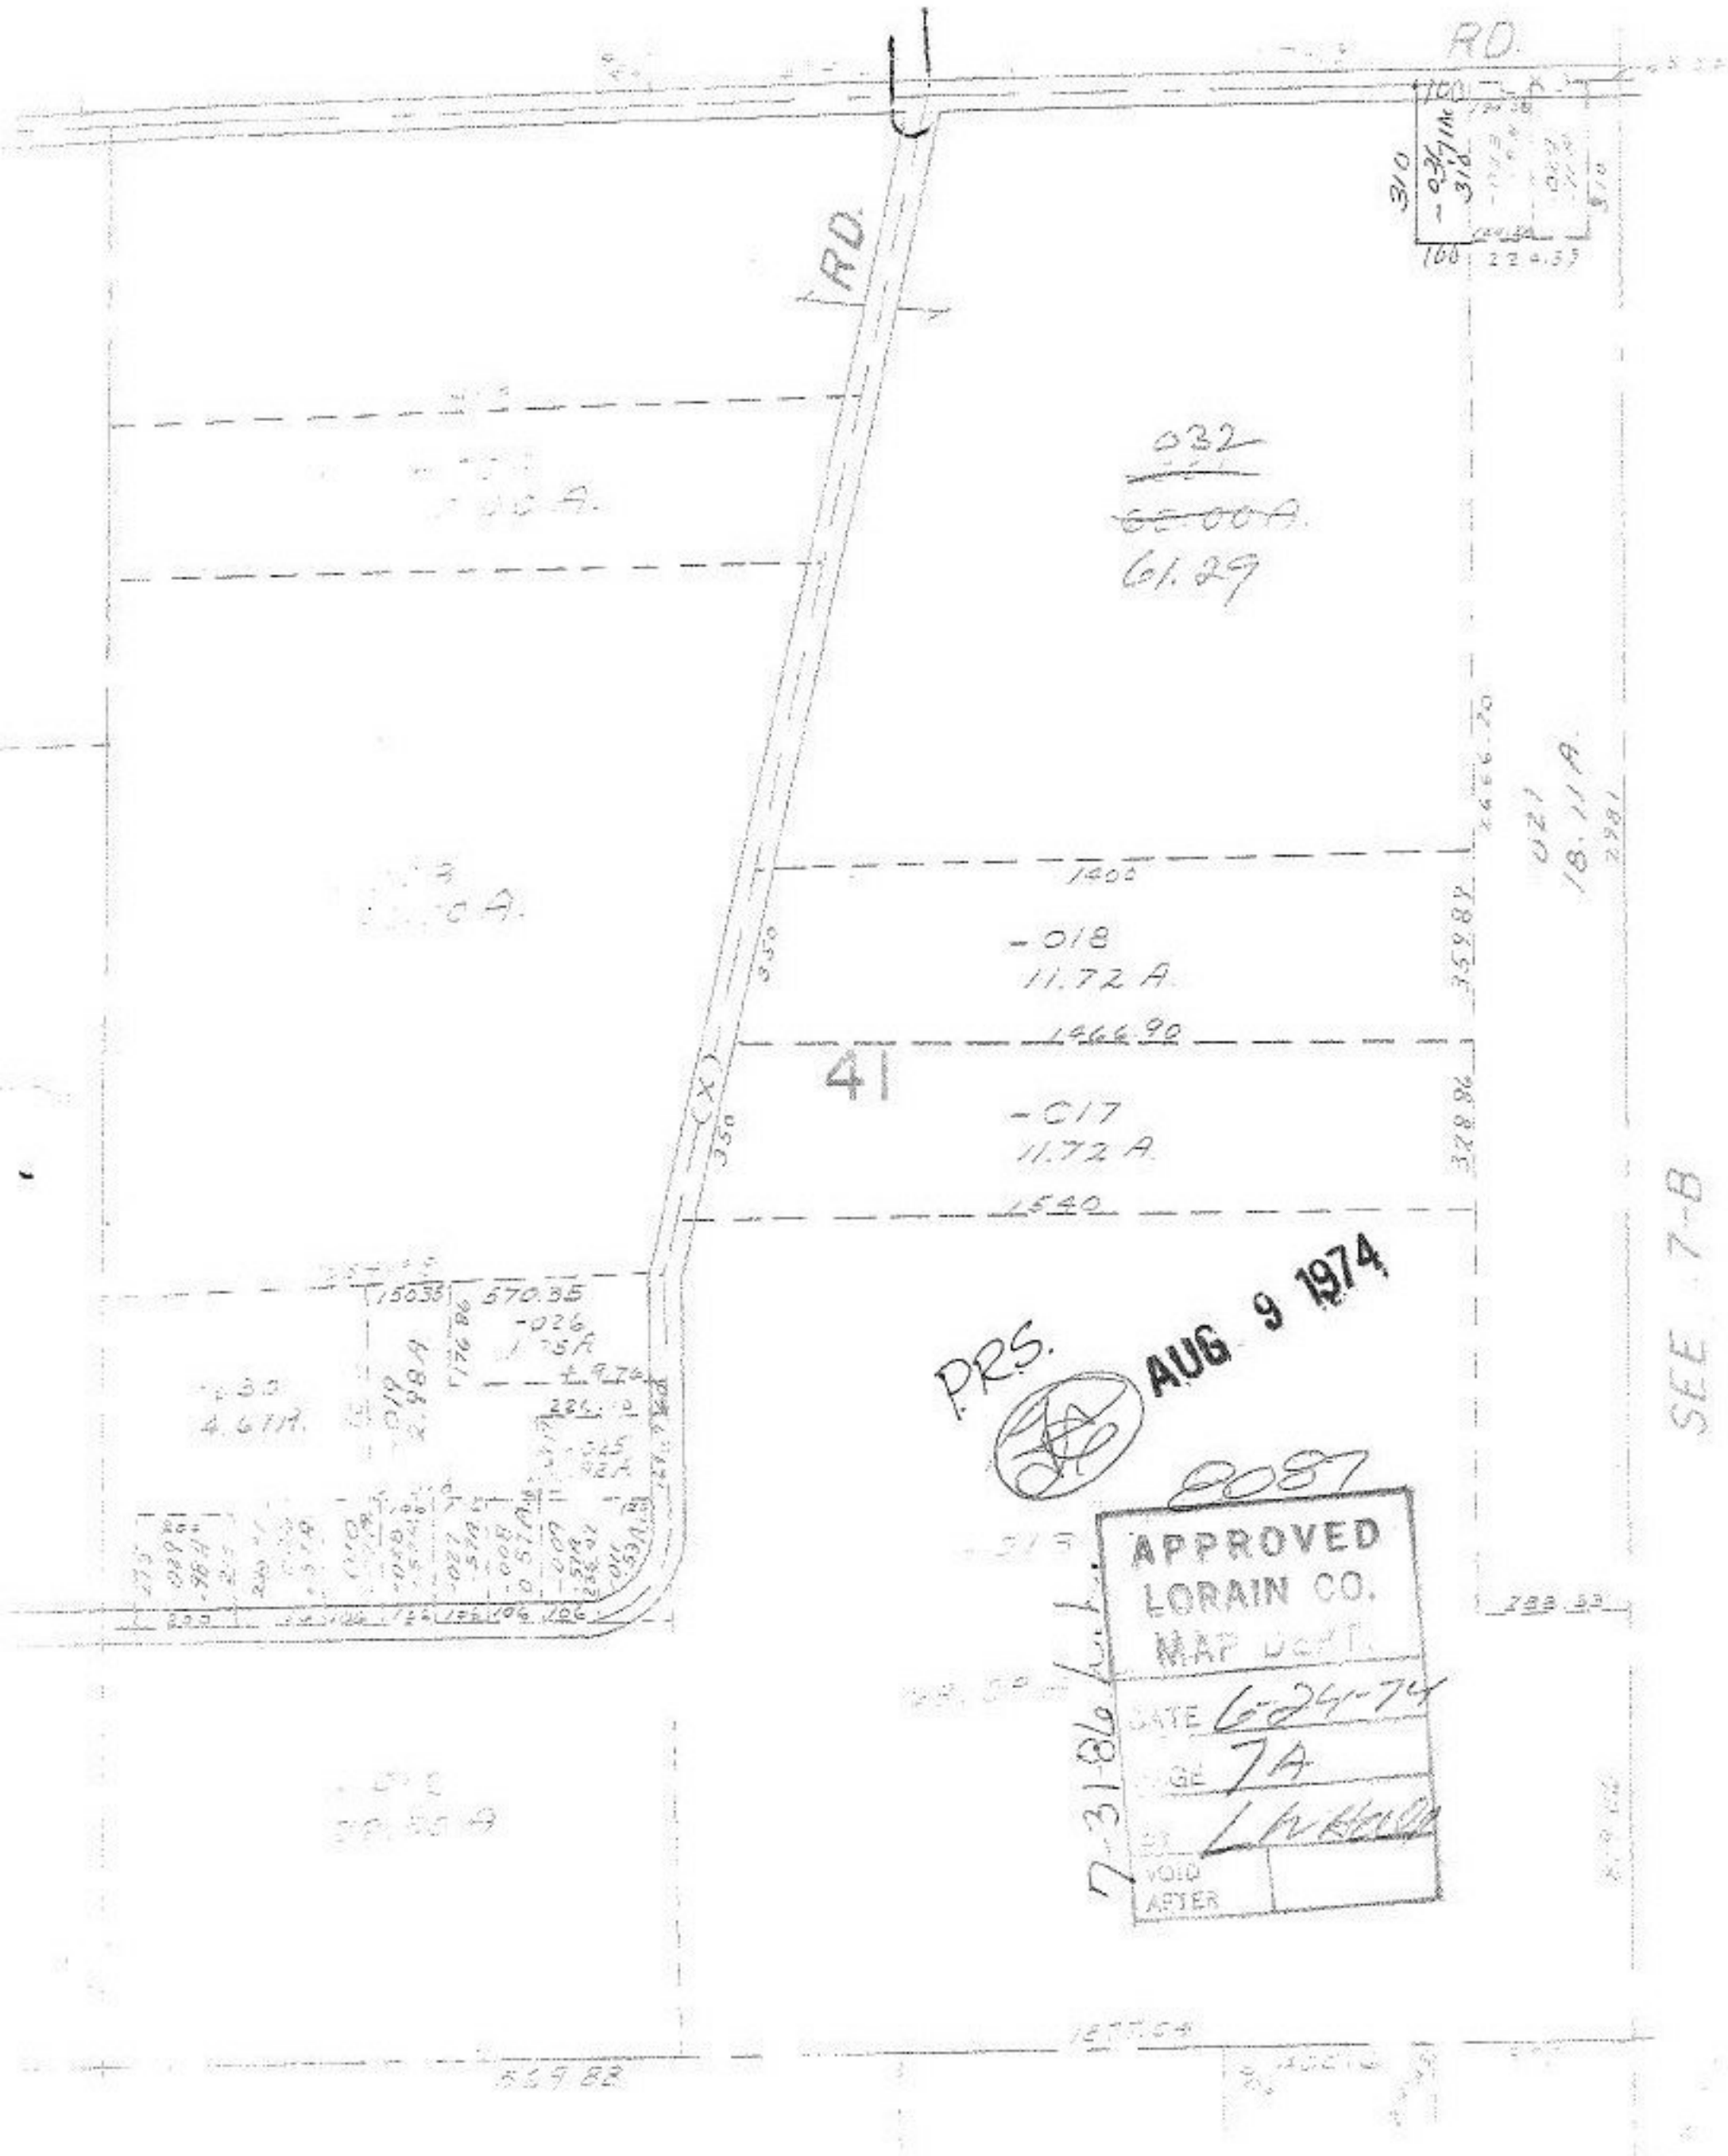
RD.
RD.
032
61.29
1400
-018
11.72 A.
1466.90
41
-017
11.72 A.
1540
570.35
-026
4.67A.
SEE 7-B
PRS.
AUG 9 1974
8087
APPROVED
LORAIN CO.
MAP DEPT.
DATE 6-24-74
PAGE 7A
VOID
AFTER
7-31-86