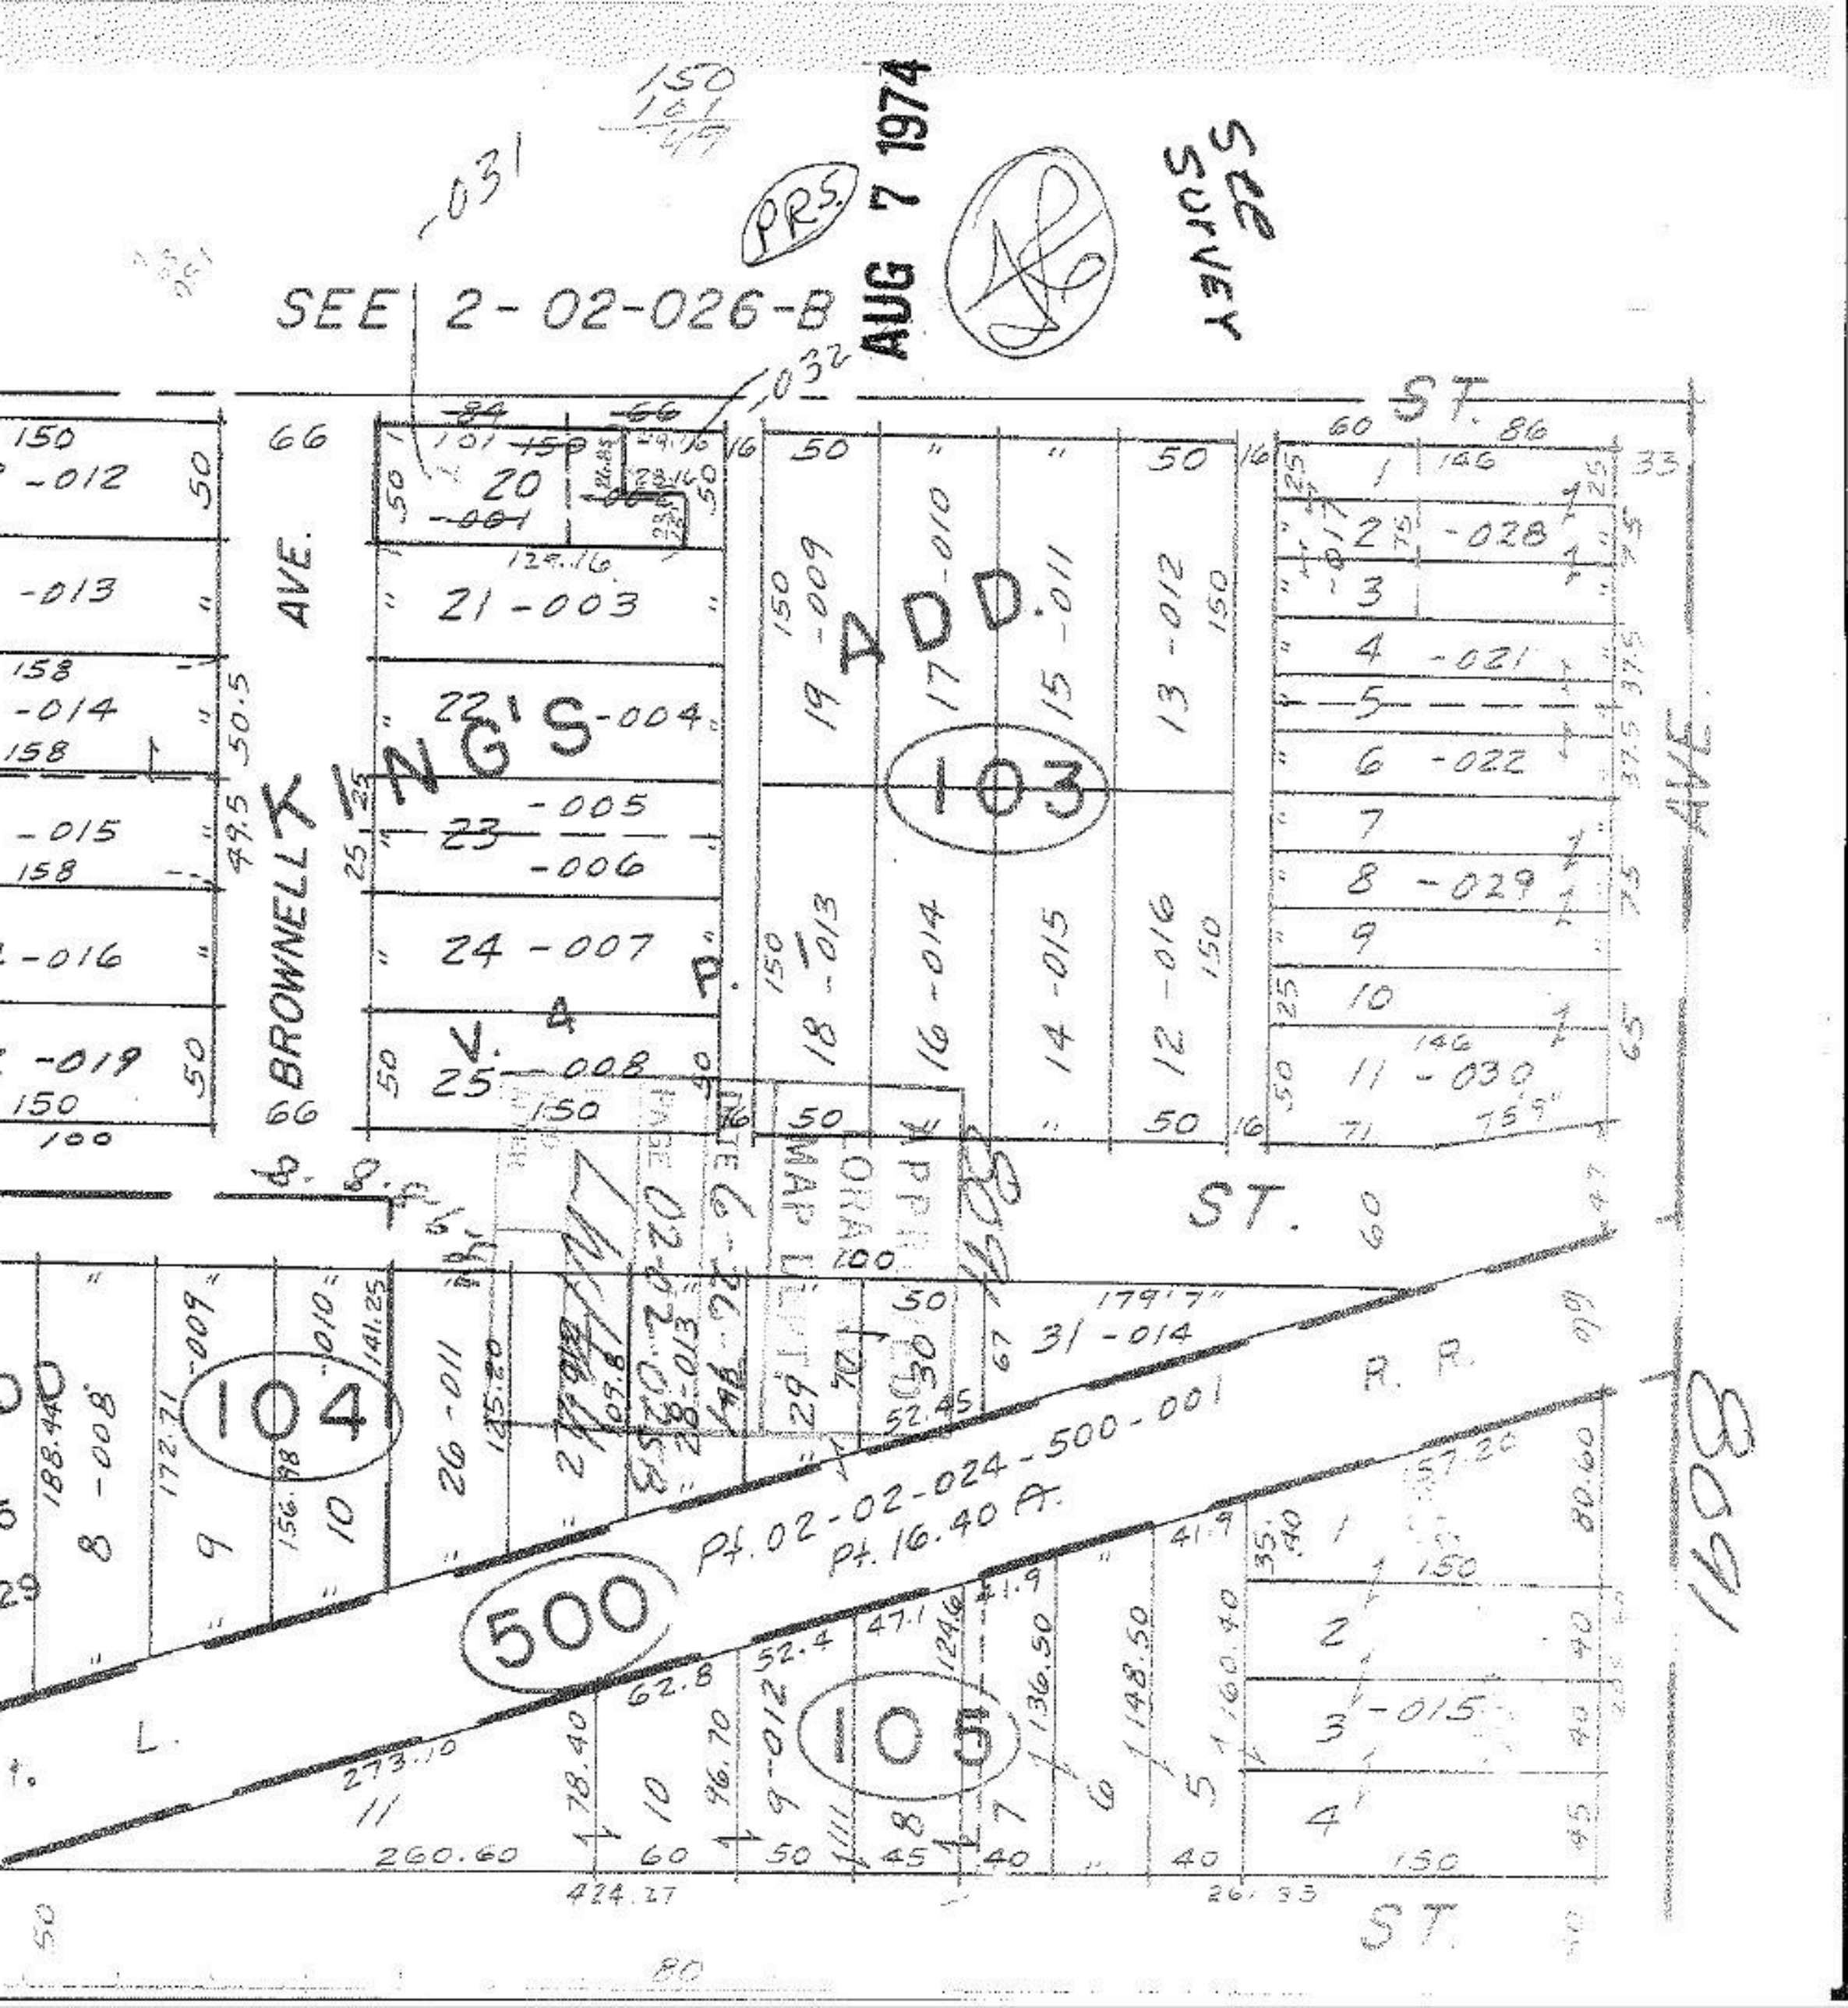

SEE 2-02-026-B
AUG 7 1974
PRS.
SEE SURVEY
-031
-032
KING'S ADD.
BROWNELL AVE.
103
104
500
105
Pt. 02-02-024-500-001
Pt. 16.40 A.
R. R.
ST.
AVE.