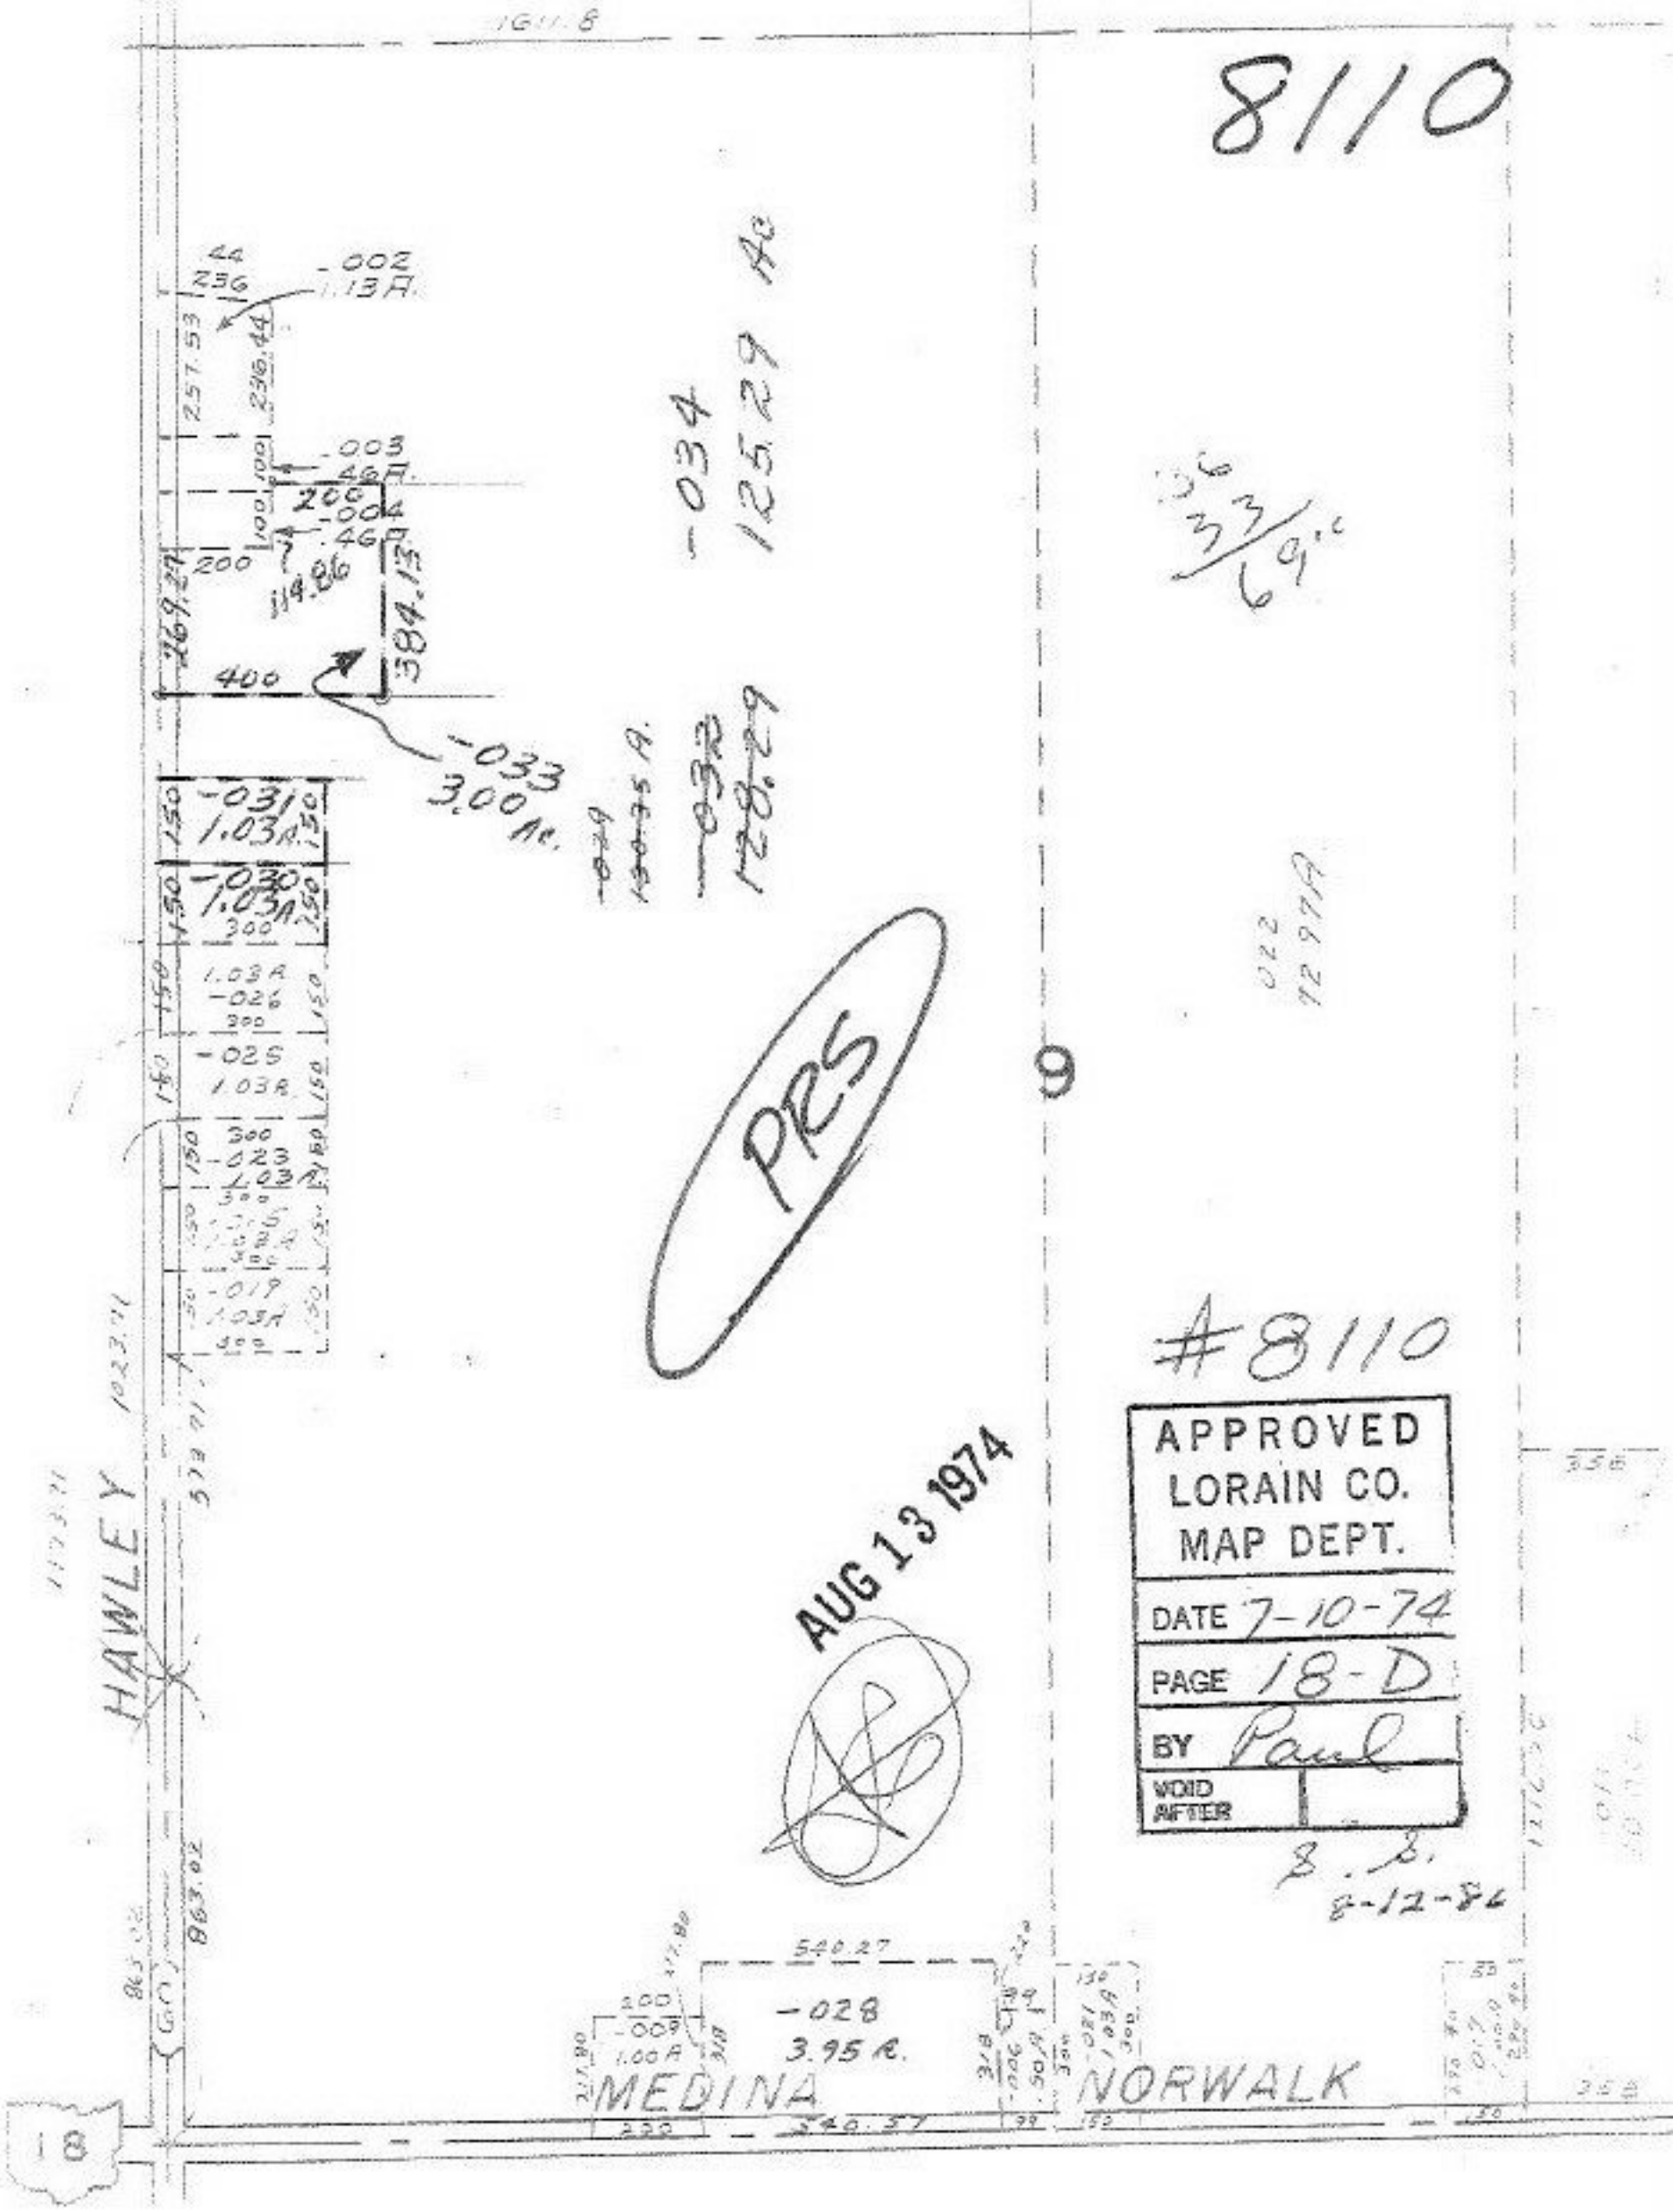
8110
-002
1.13A.
-003
.46A.
-004
.46A.
-034
125.29 Ac
-033
3.00 Ac.
-031
1.03A.
-030
1.03A.
-026
-025
1.03A.
-023
1.03A.
-019
1.03A.
PRS
9
#8110
APPROVED
LORAIN CO.
MAP DEPT.
DATE 7-10-74
PAGE 18-D
BY Paul
VOID AFTER
8-12-86
AUG 13 1974
HAWLEY
-028
3.95 A.
MEDINA
NORWALK
18