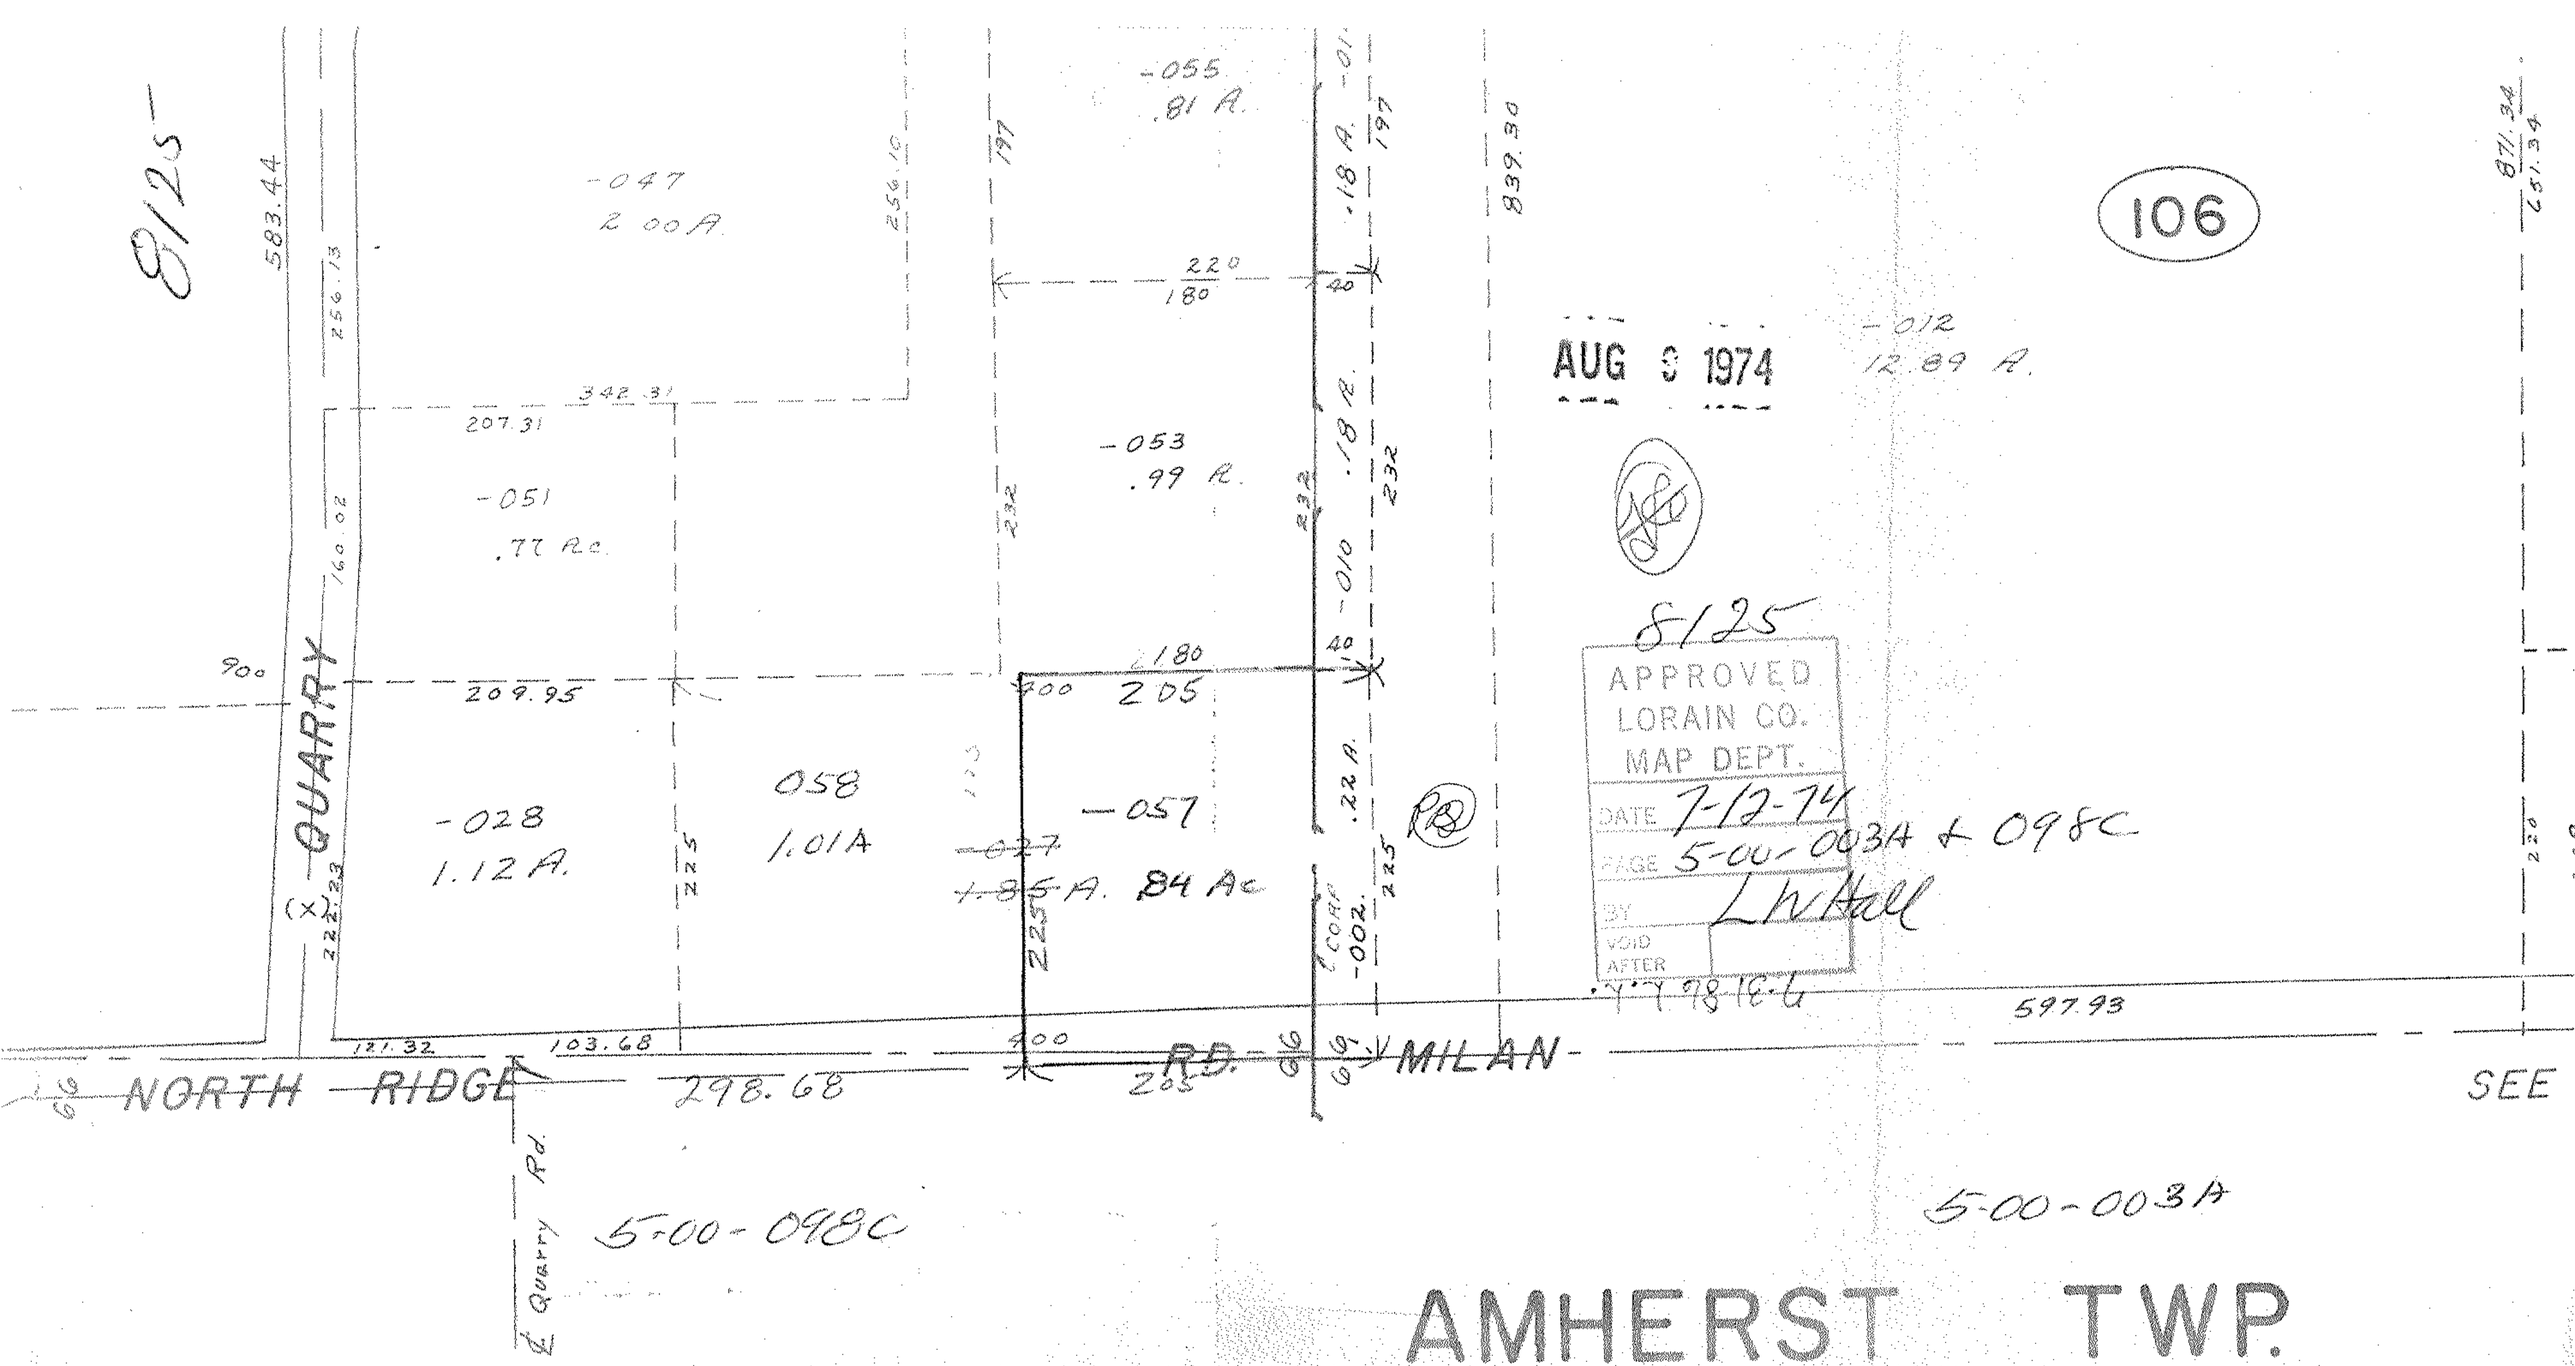
8125
583.44
256.13
342.31
207.31
160.02
900
209.95
QUARRY
(X)
222.23
-047
2.00A.
256.19
197
220
180
-055
.81 A.
-018 A.
-011
839.30
871.34
651.34
106
AUG 9 1974
-012
12.89 A.
-053
.99 A.
.18 A.
.18 A.
232
232
-010
40
180
205
900
-028
1.12 A.
058
1.01A
NZS
-057
-027
.84 Ac
.22 A.
225
1 CORR
-002.
8125
APPROVED
LORAIN CO.
MAP DEPT.
DATE 7-12-74
PAGE 5-00-003A & 098C
BY LWHall
VOID
AFTER
597.93
121.32
103.68
400
RD.
MILAN
NORTH RIDGE
298.68
205
SEE
Quarry Rd.
5-00-098C
5-00-003A
AMHERST TWP.
SCALE: 1" = 100'