8129

AUG 9 1974

~~014~~ 17.85 A.

~~016~~ 018

~~16.00~~ AC

15.40 AC

Pnd

8129

7-31-86 L.L.

APPROVED
LORAIN CO.
MAP DEPT.

DATE 7-15-74

PAGE 5-00-094A

BY L.W. Hall
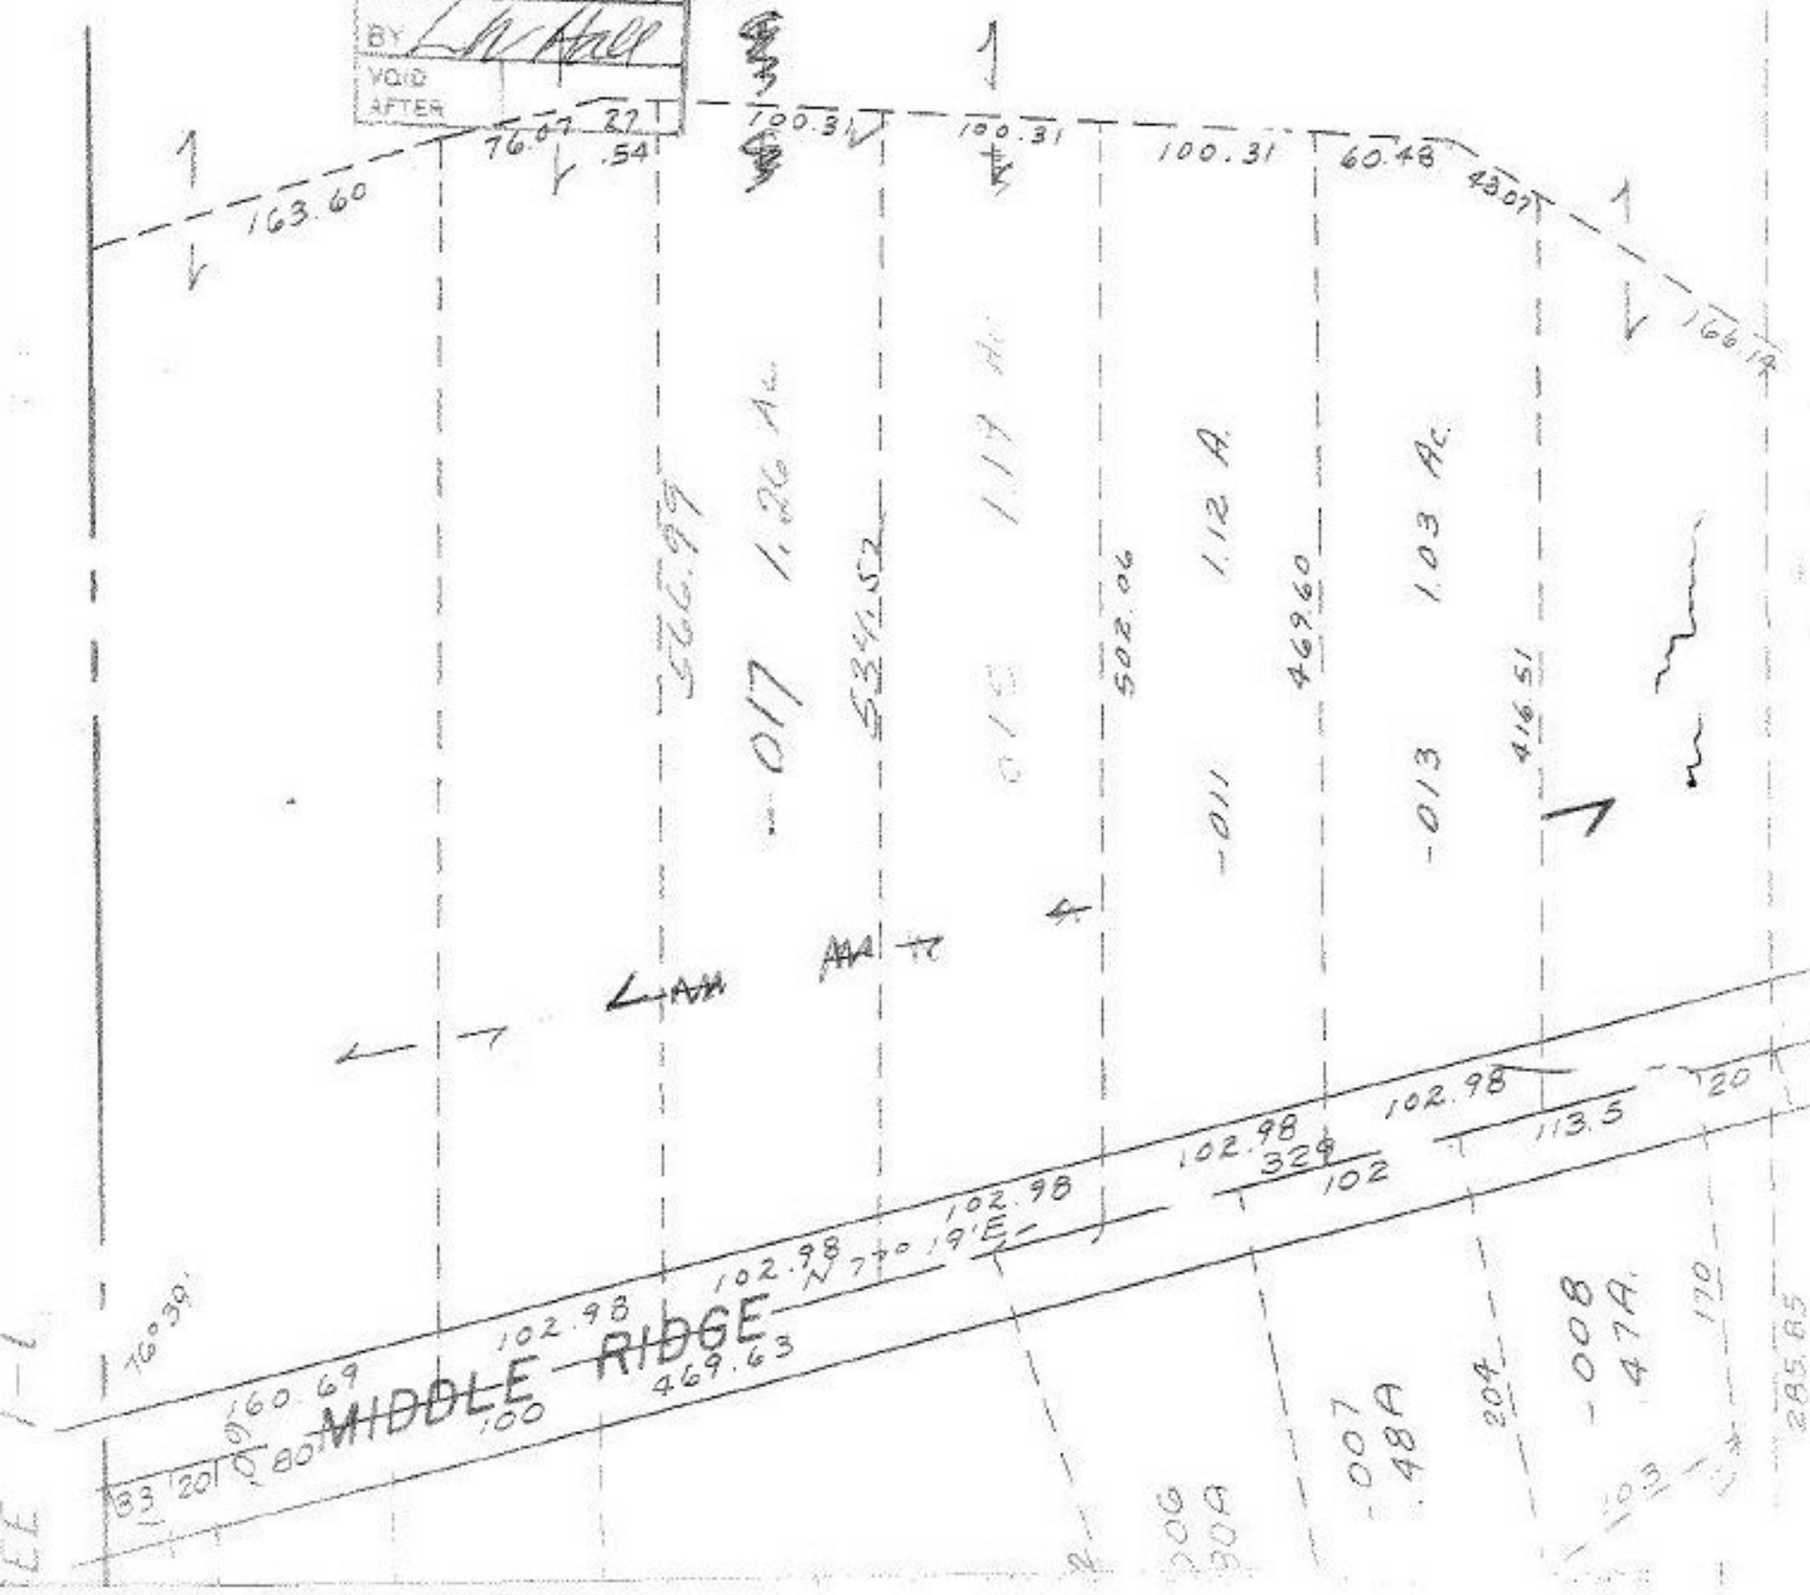
VOID AFTER