8131
2/2

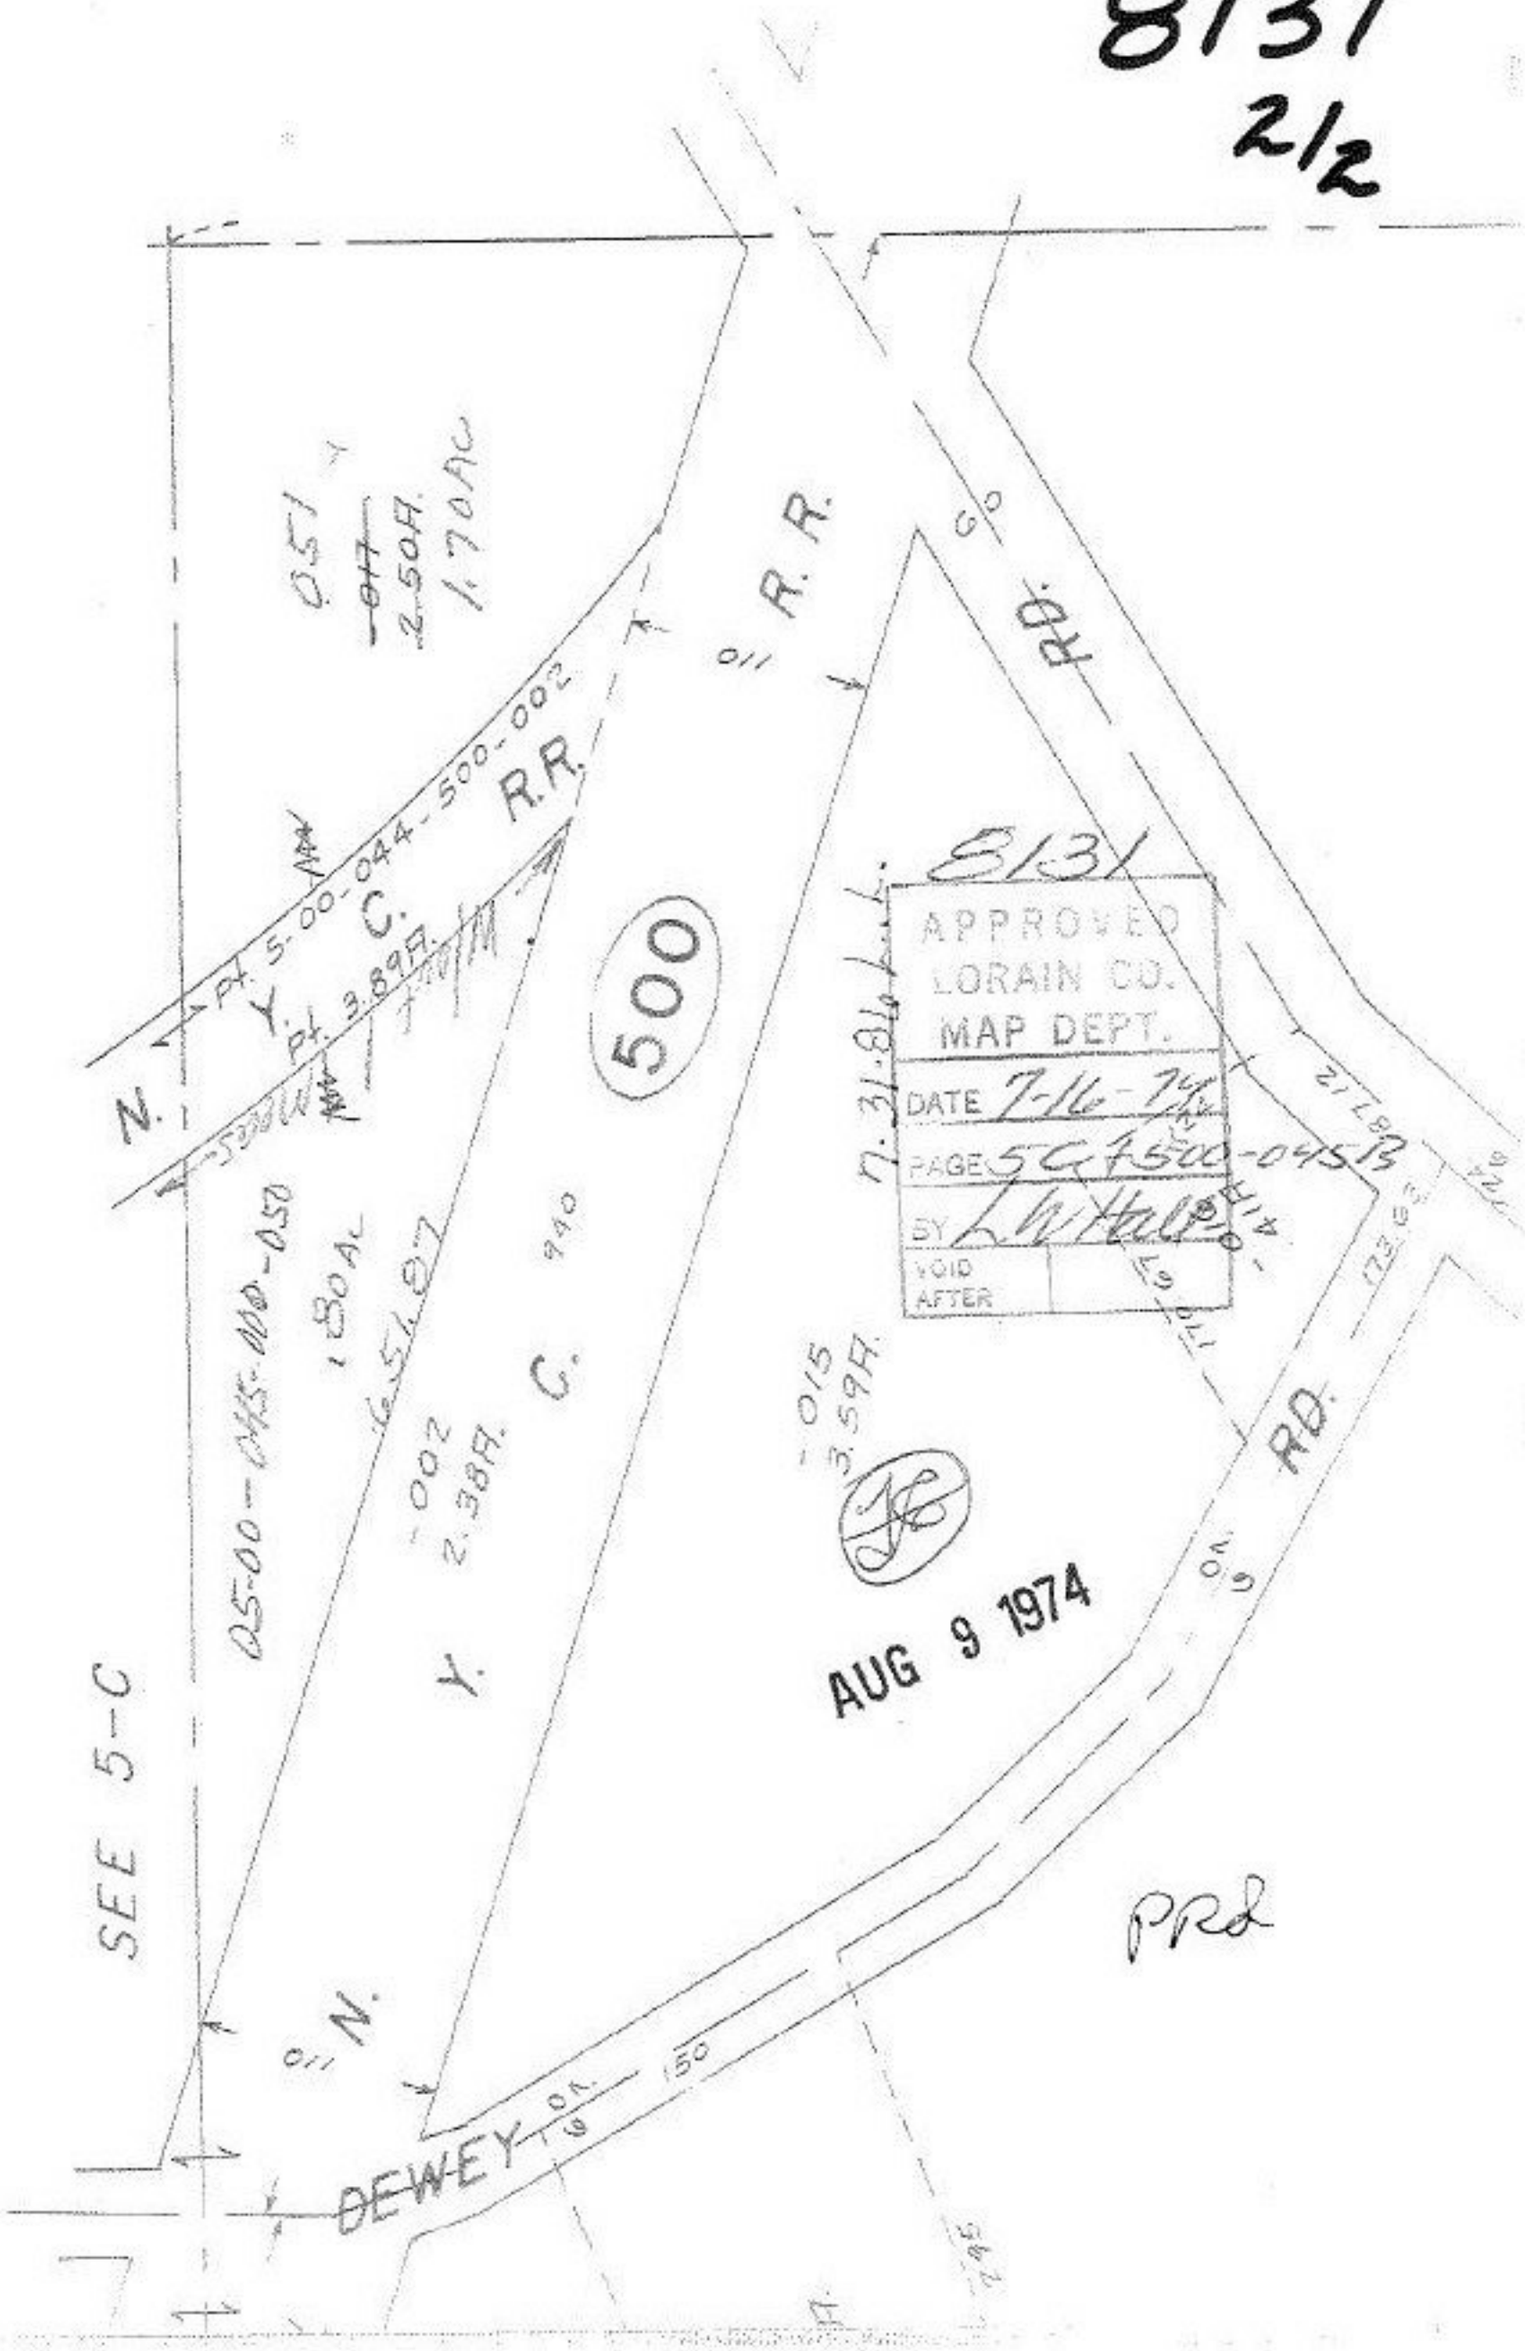
R. R.
RD.
500
8131
APPROVED
LORAIN CO.
MAP DEPT.
DATE 7-16-74
PAGE SG 4500-045
BY L. W. Hall
VOID
AFTER
7.31.84 Acs.
0.51
.047
2.504
1.70 AC
N.
Pt. 5.00-044-500-002
Y.
C.
Pt. 3.897
1.80 AC
1.654
-050
-002
2.38A.
-015
3.59A.
940
2178
1710
1745
SEE 5-C
25.00 - 044 - 500 - 002
0.51 N.
DEWEY
150
AUG 9 1974
PRD