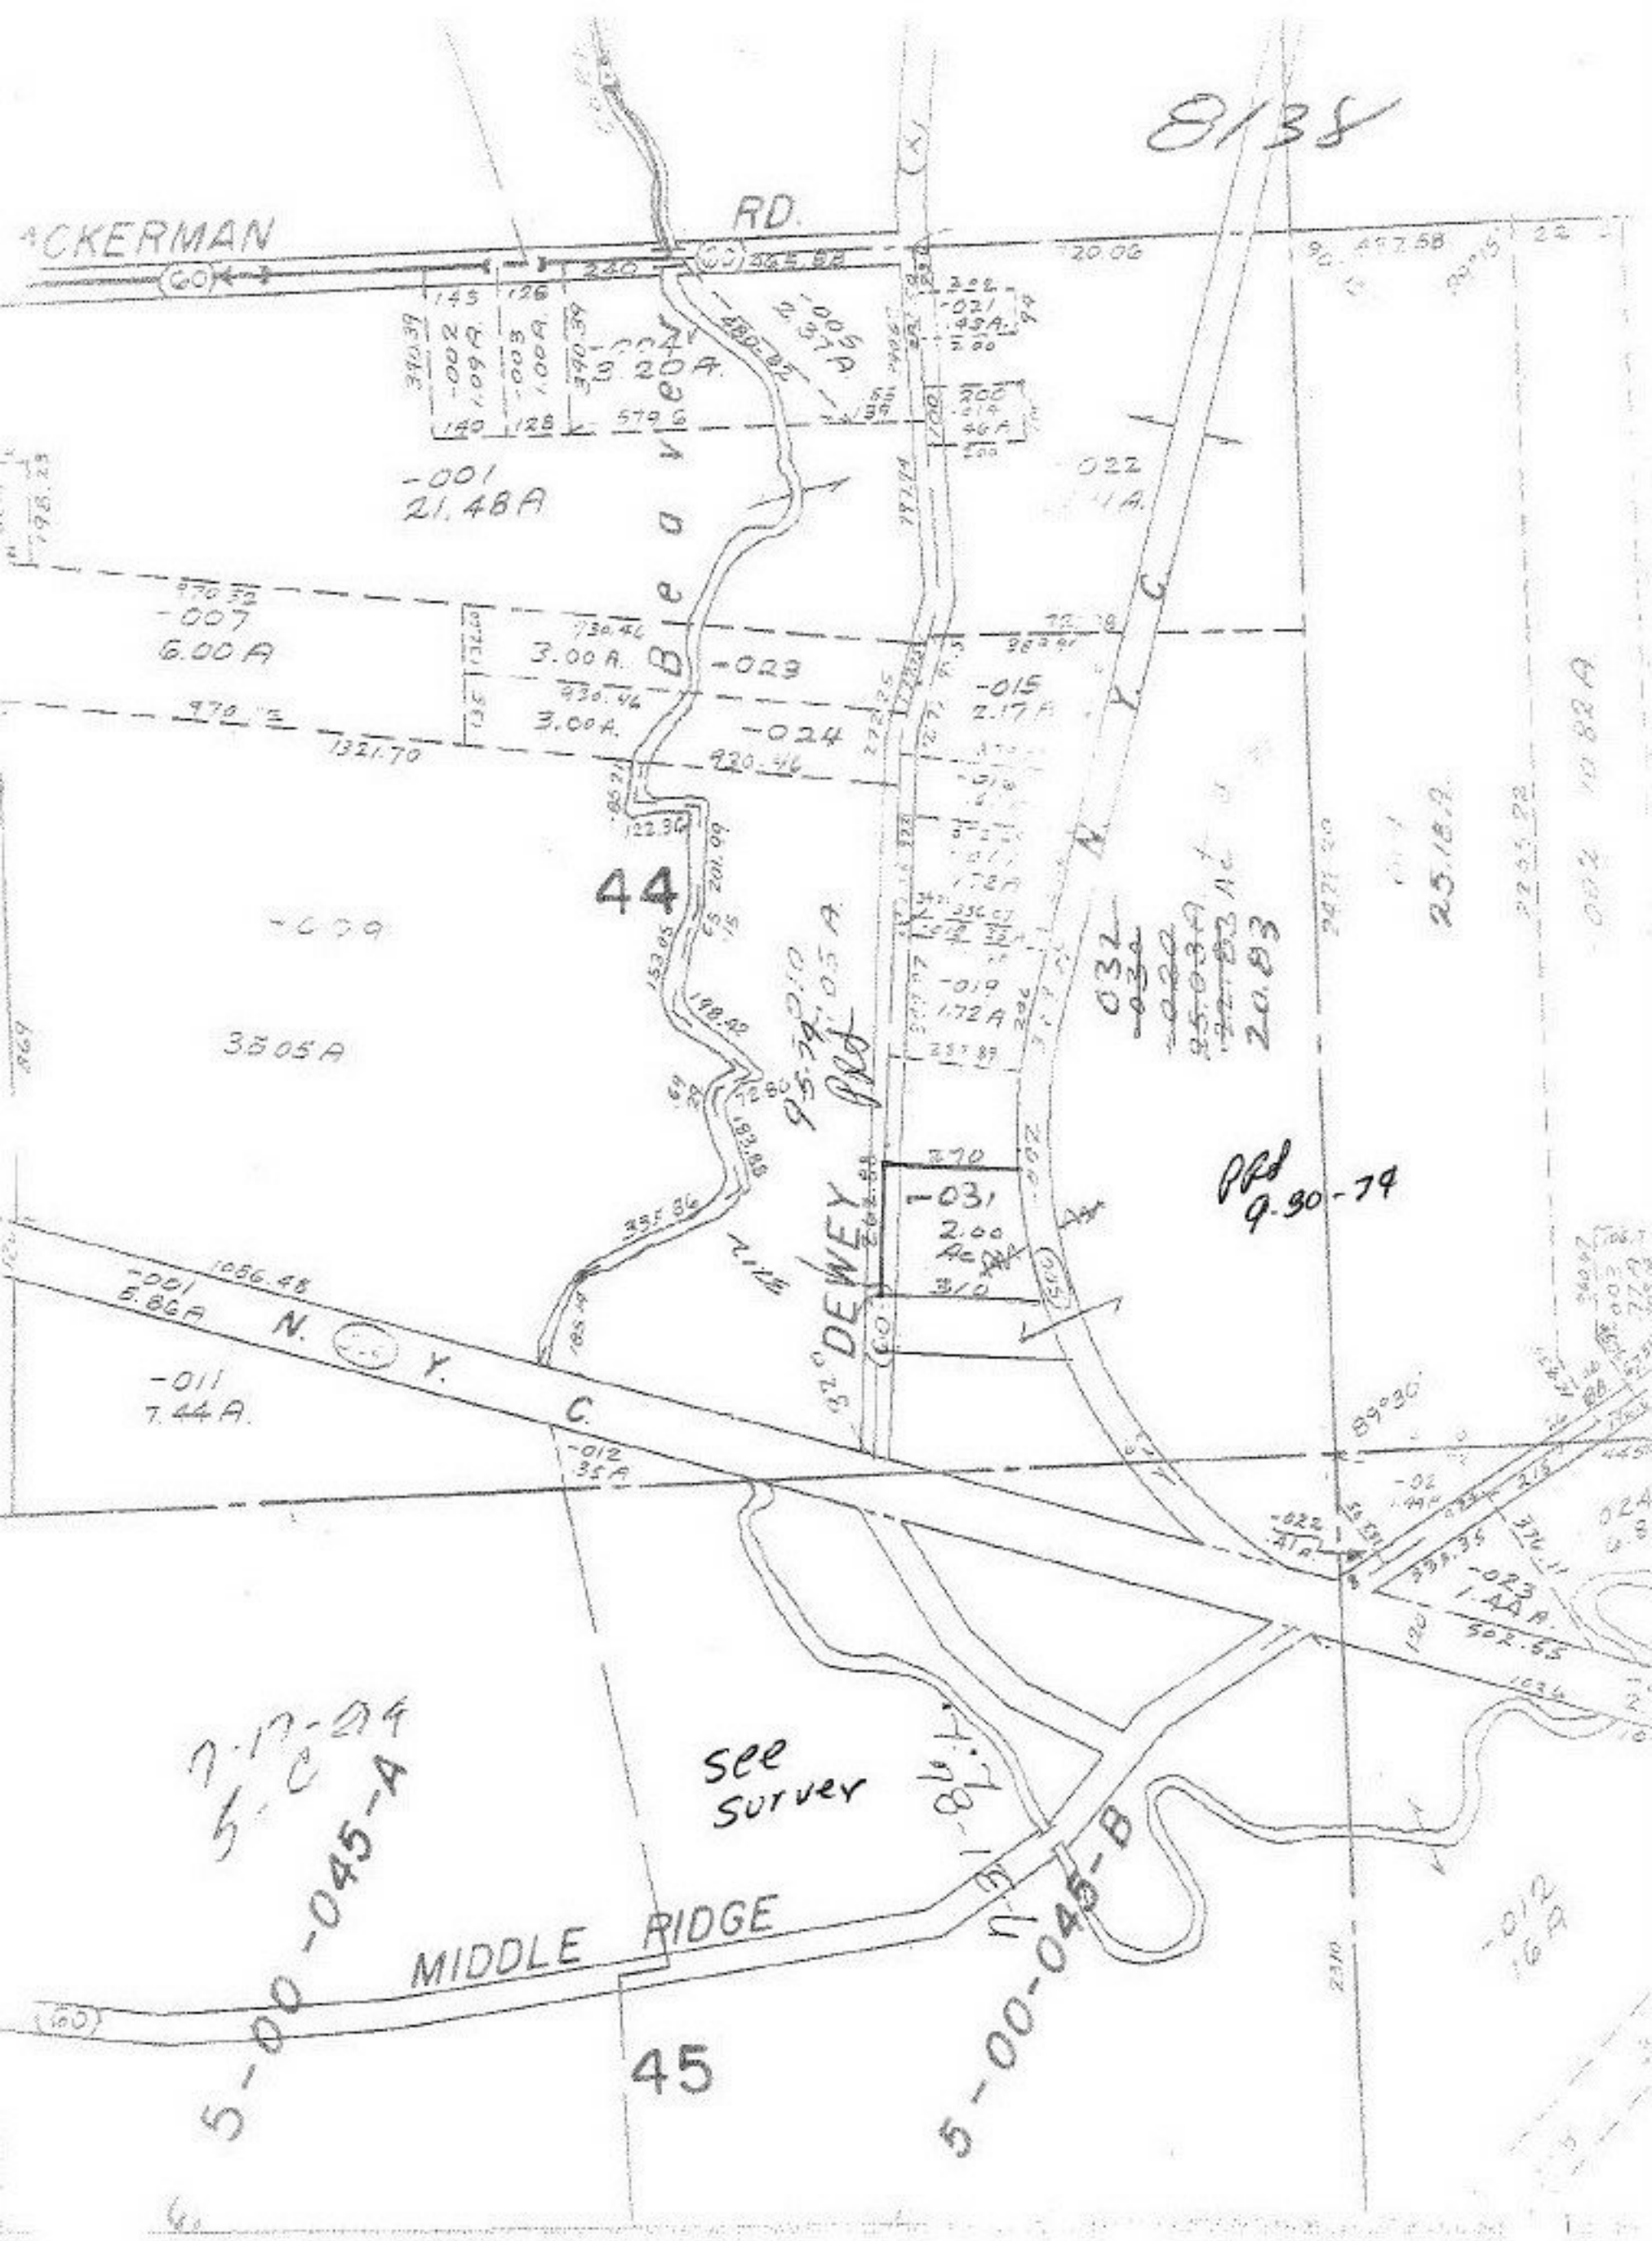
8138
ACKERMAN RD.
Beaver
DEWEY
N. Y. C.
44
45
-001
21.48A
-007
6.00A
3.00A.
-023
-024
-015
2.17A
-019
1.72A
-031
2.00
35.05A
-001
5.86A
-011
7.44A.
-012
.35A
-023
1.44A.
-012
16A
PRd
9-30-74
see
survey
5-00-045-A
5-00-045-B
MIDDLE RIDGE