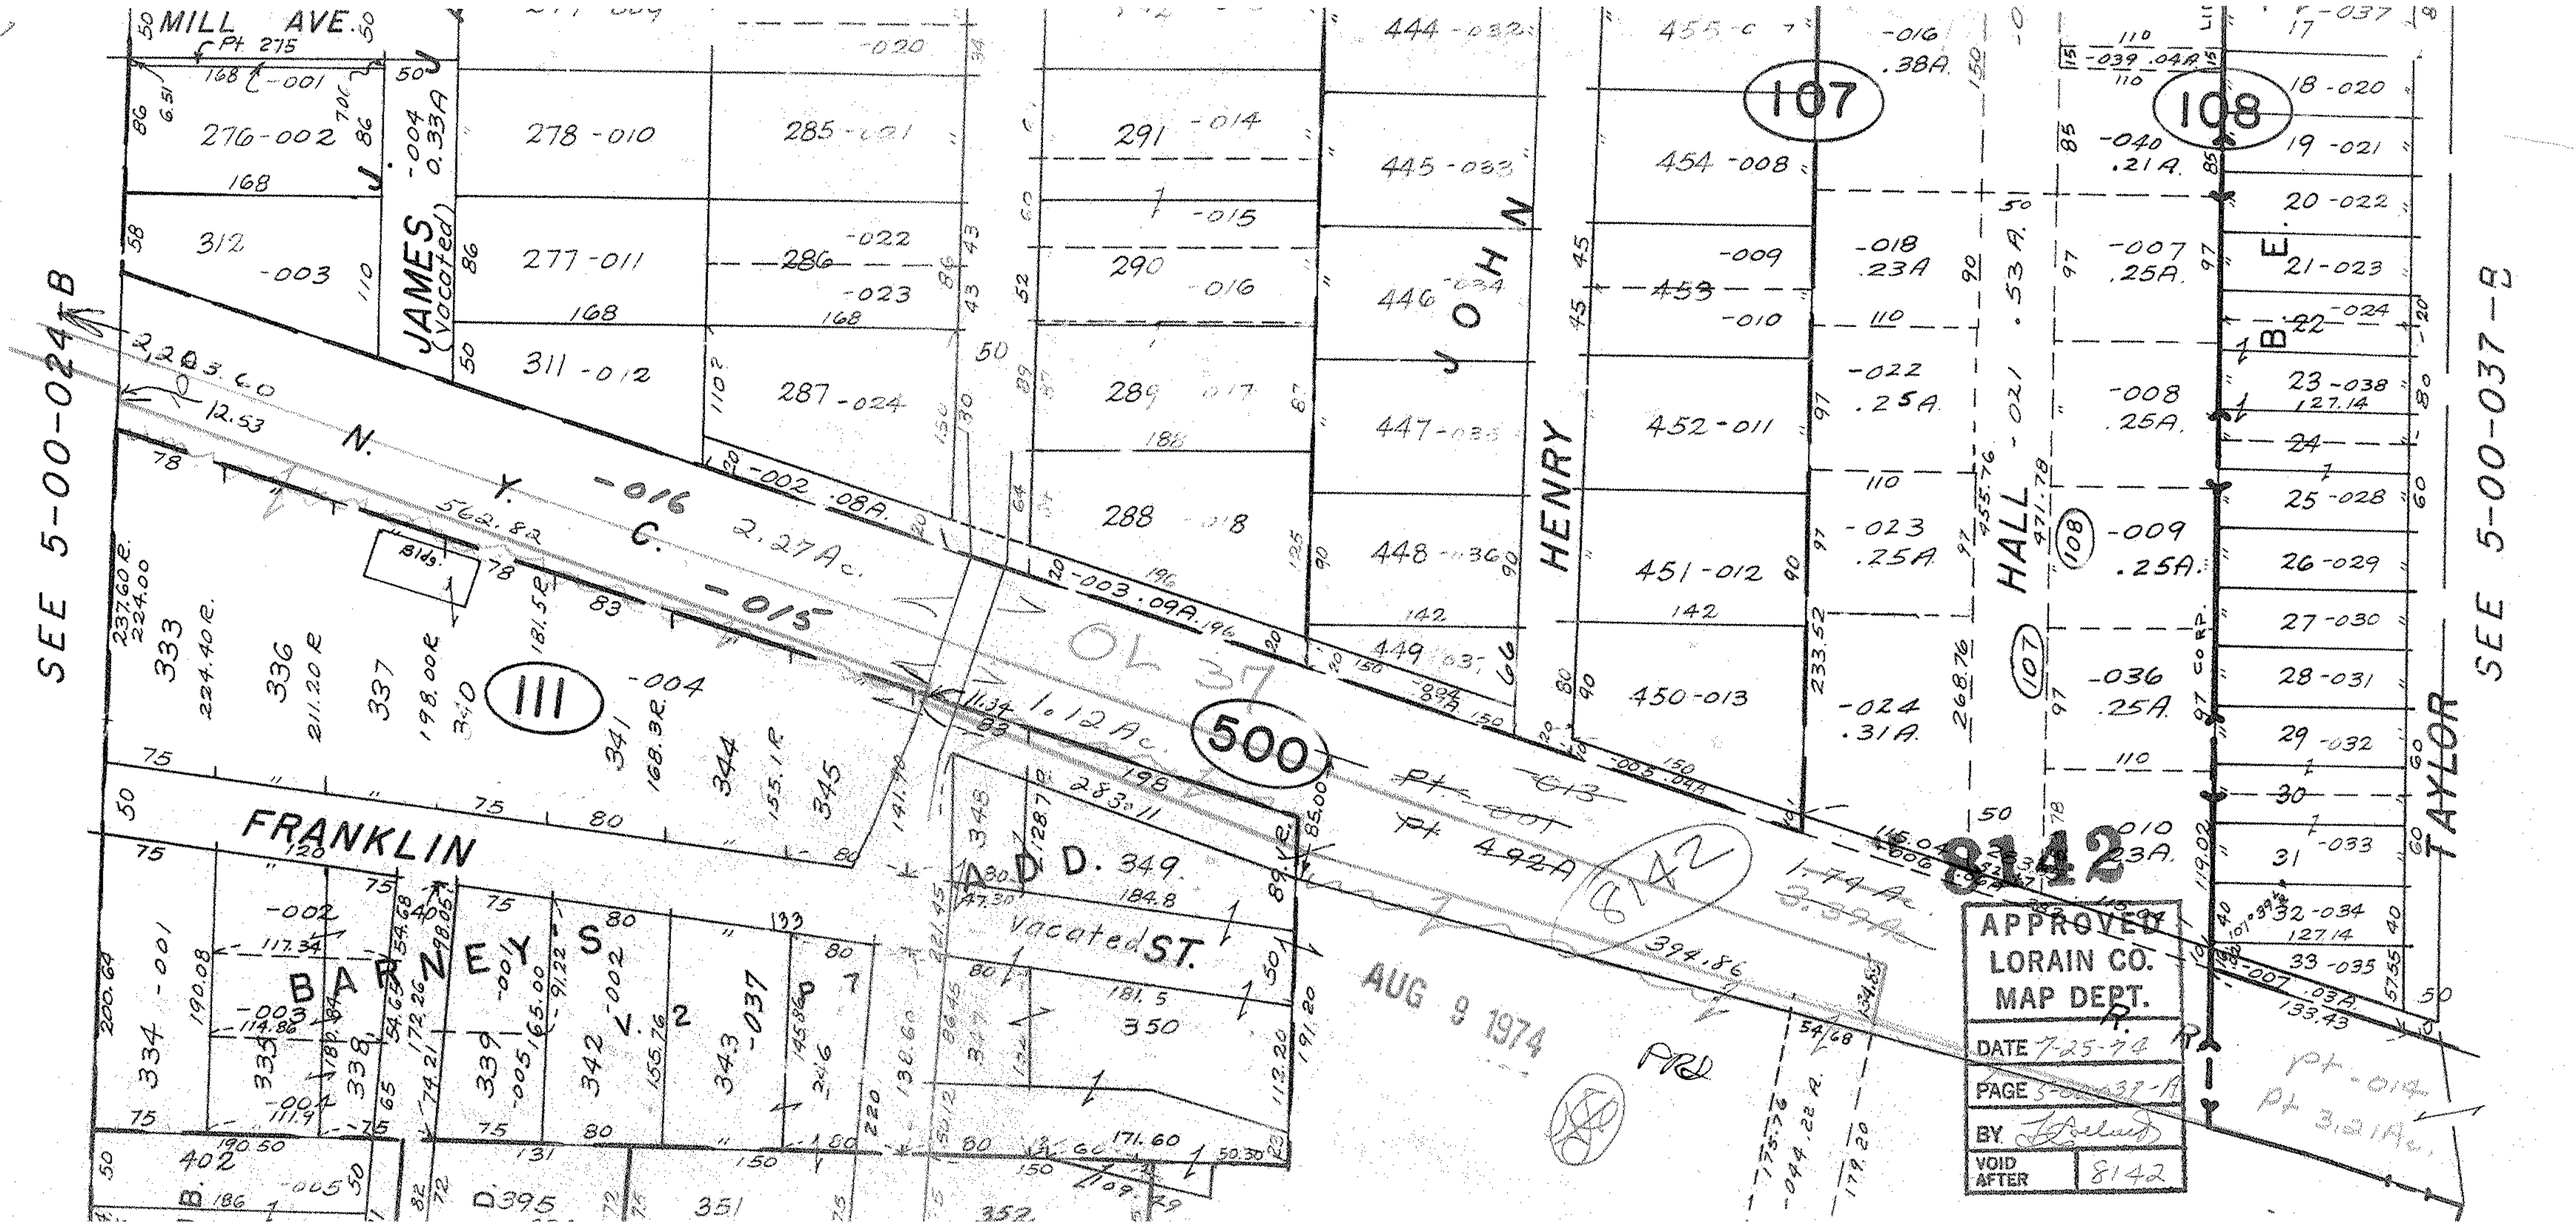
MILL AVE.
JAMES (vacated)
JOHN HENRY
HALL
TAYLOR
N. Y. C.
FRANKLIN
BARNEYS ADD.
Vacated ST.
SEE 5-00-024-B
111
500
107
108
8142
APPROVED
LORAIN CO.
MAP DEPT.
DATE 7-25-74
PAGE 37-A
BY
VOID AFTER 8142
AUG 9 1974
PRD