


ALL 3-00-024-A

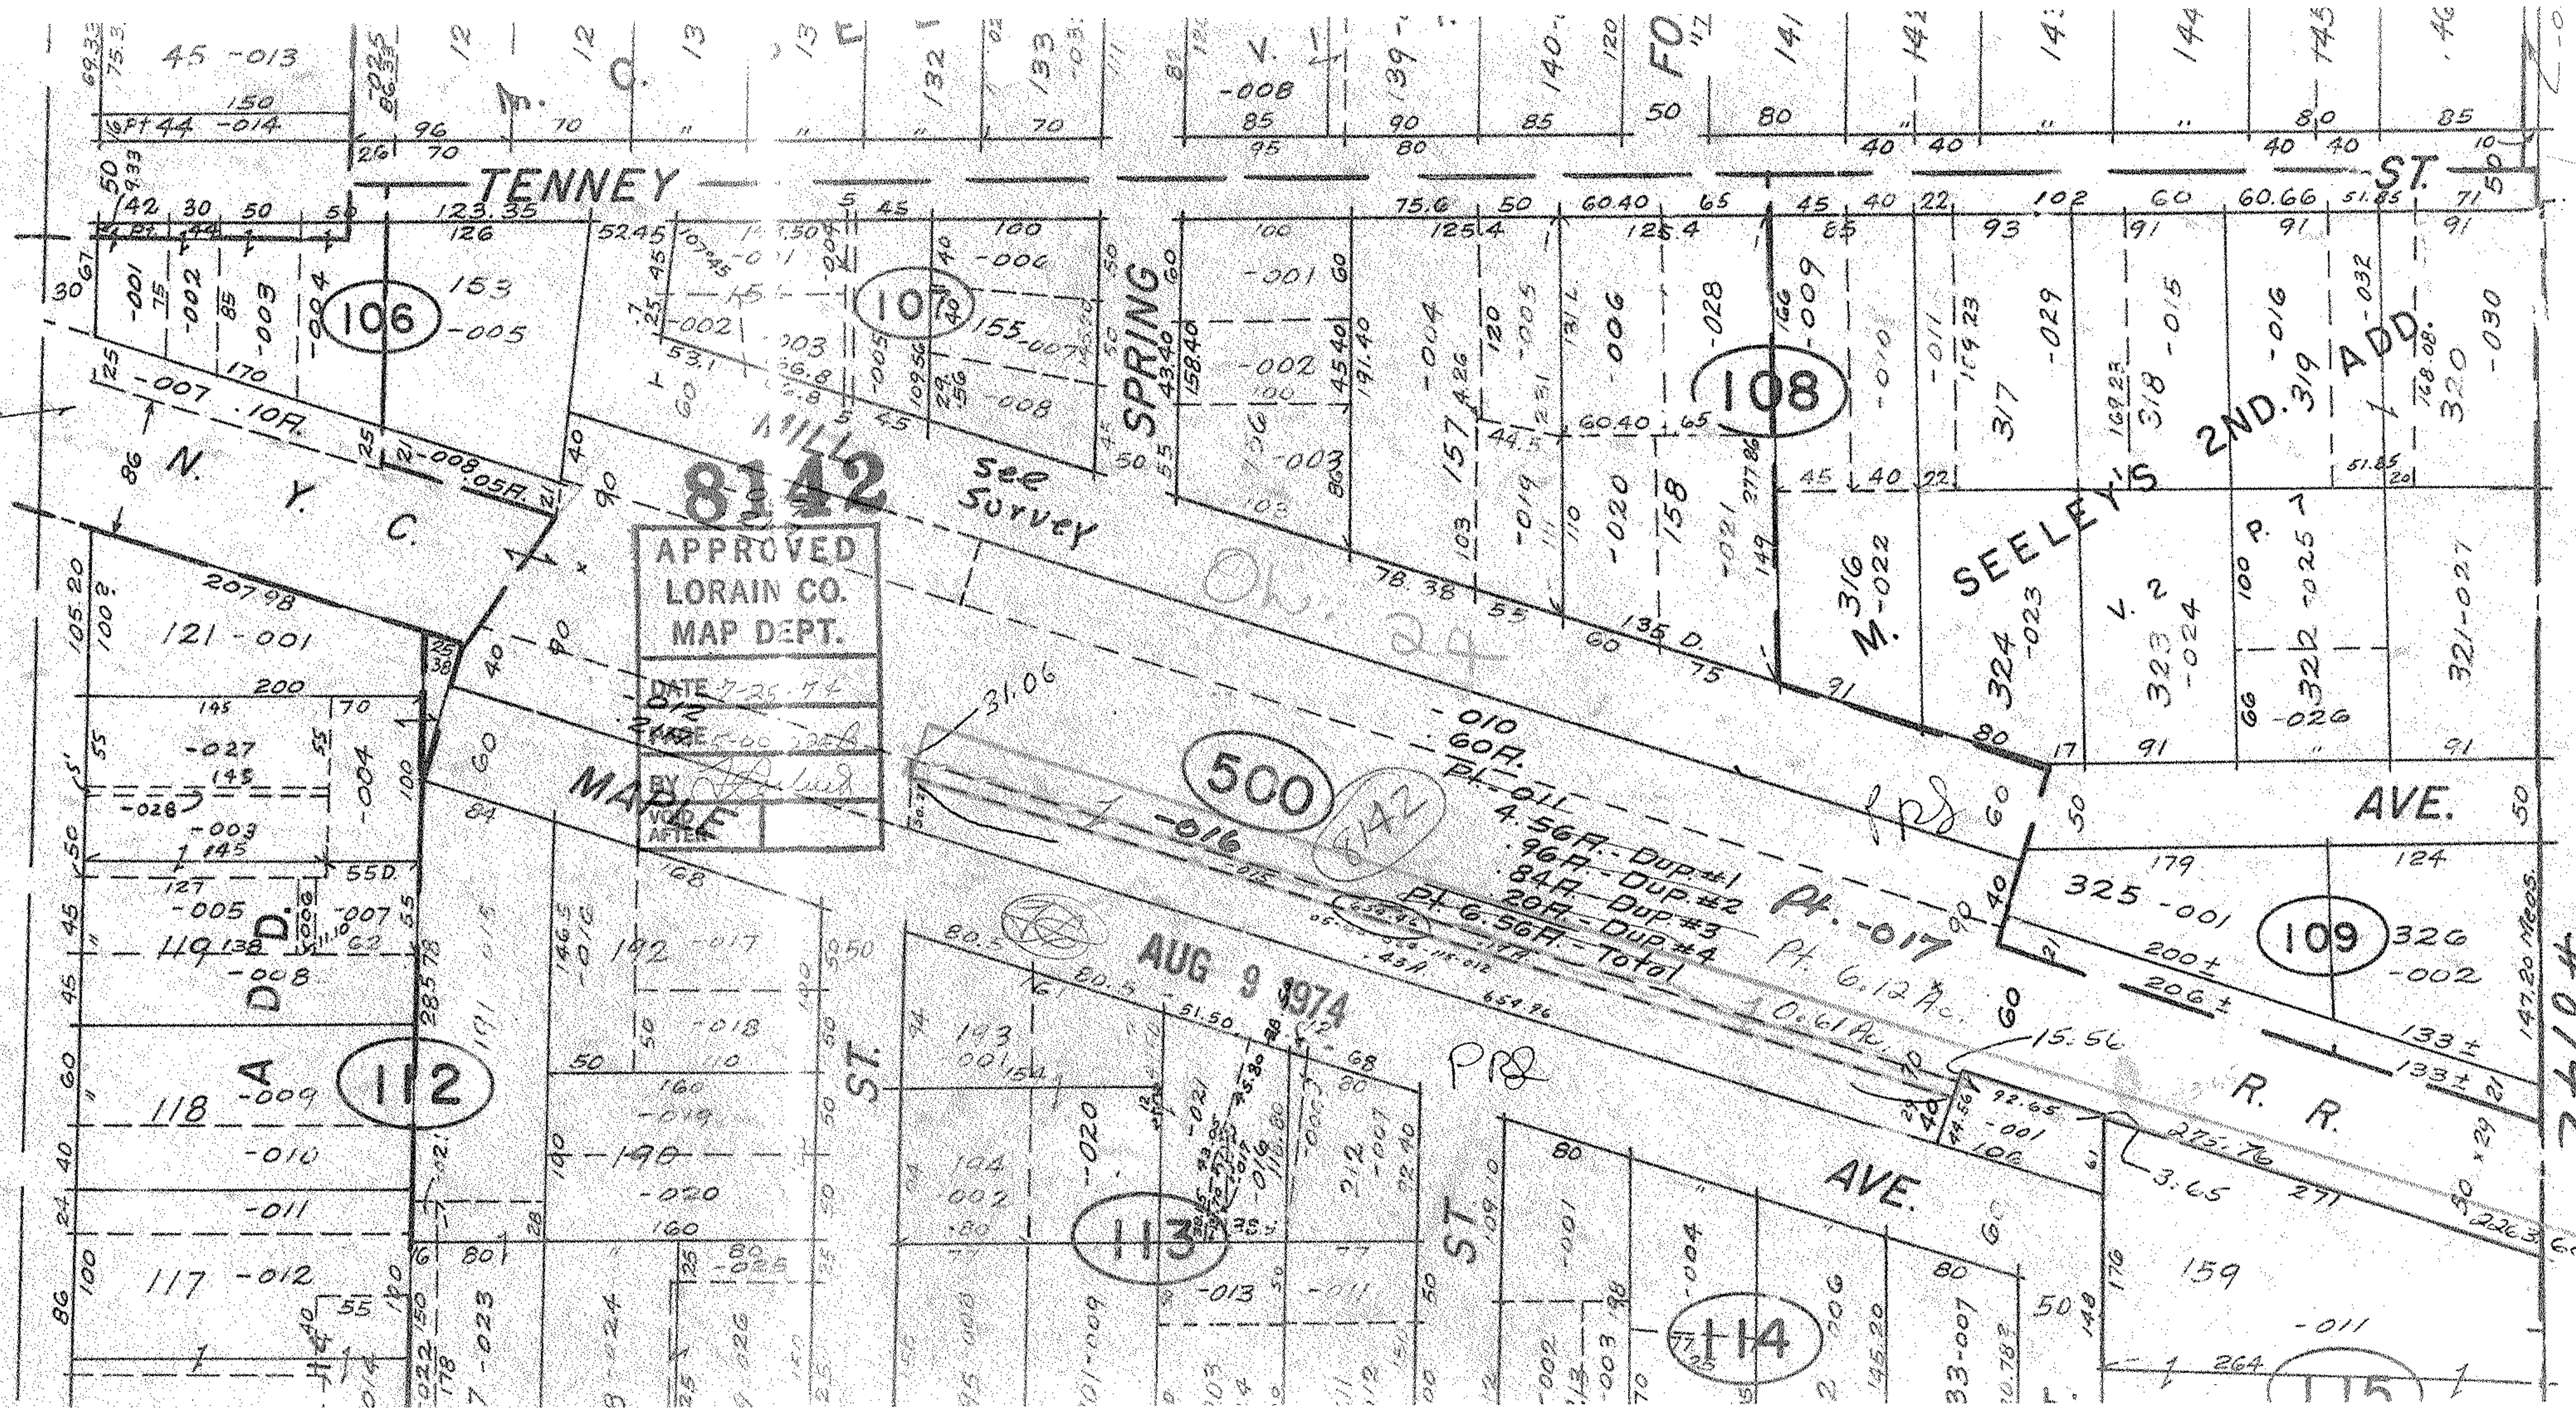

#8142