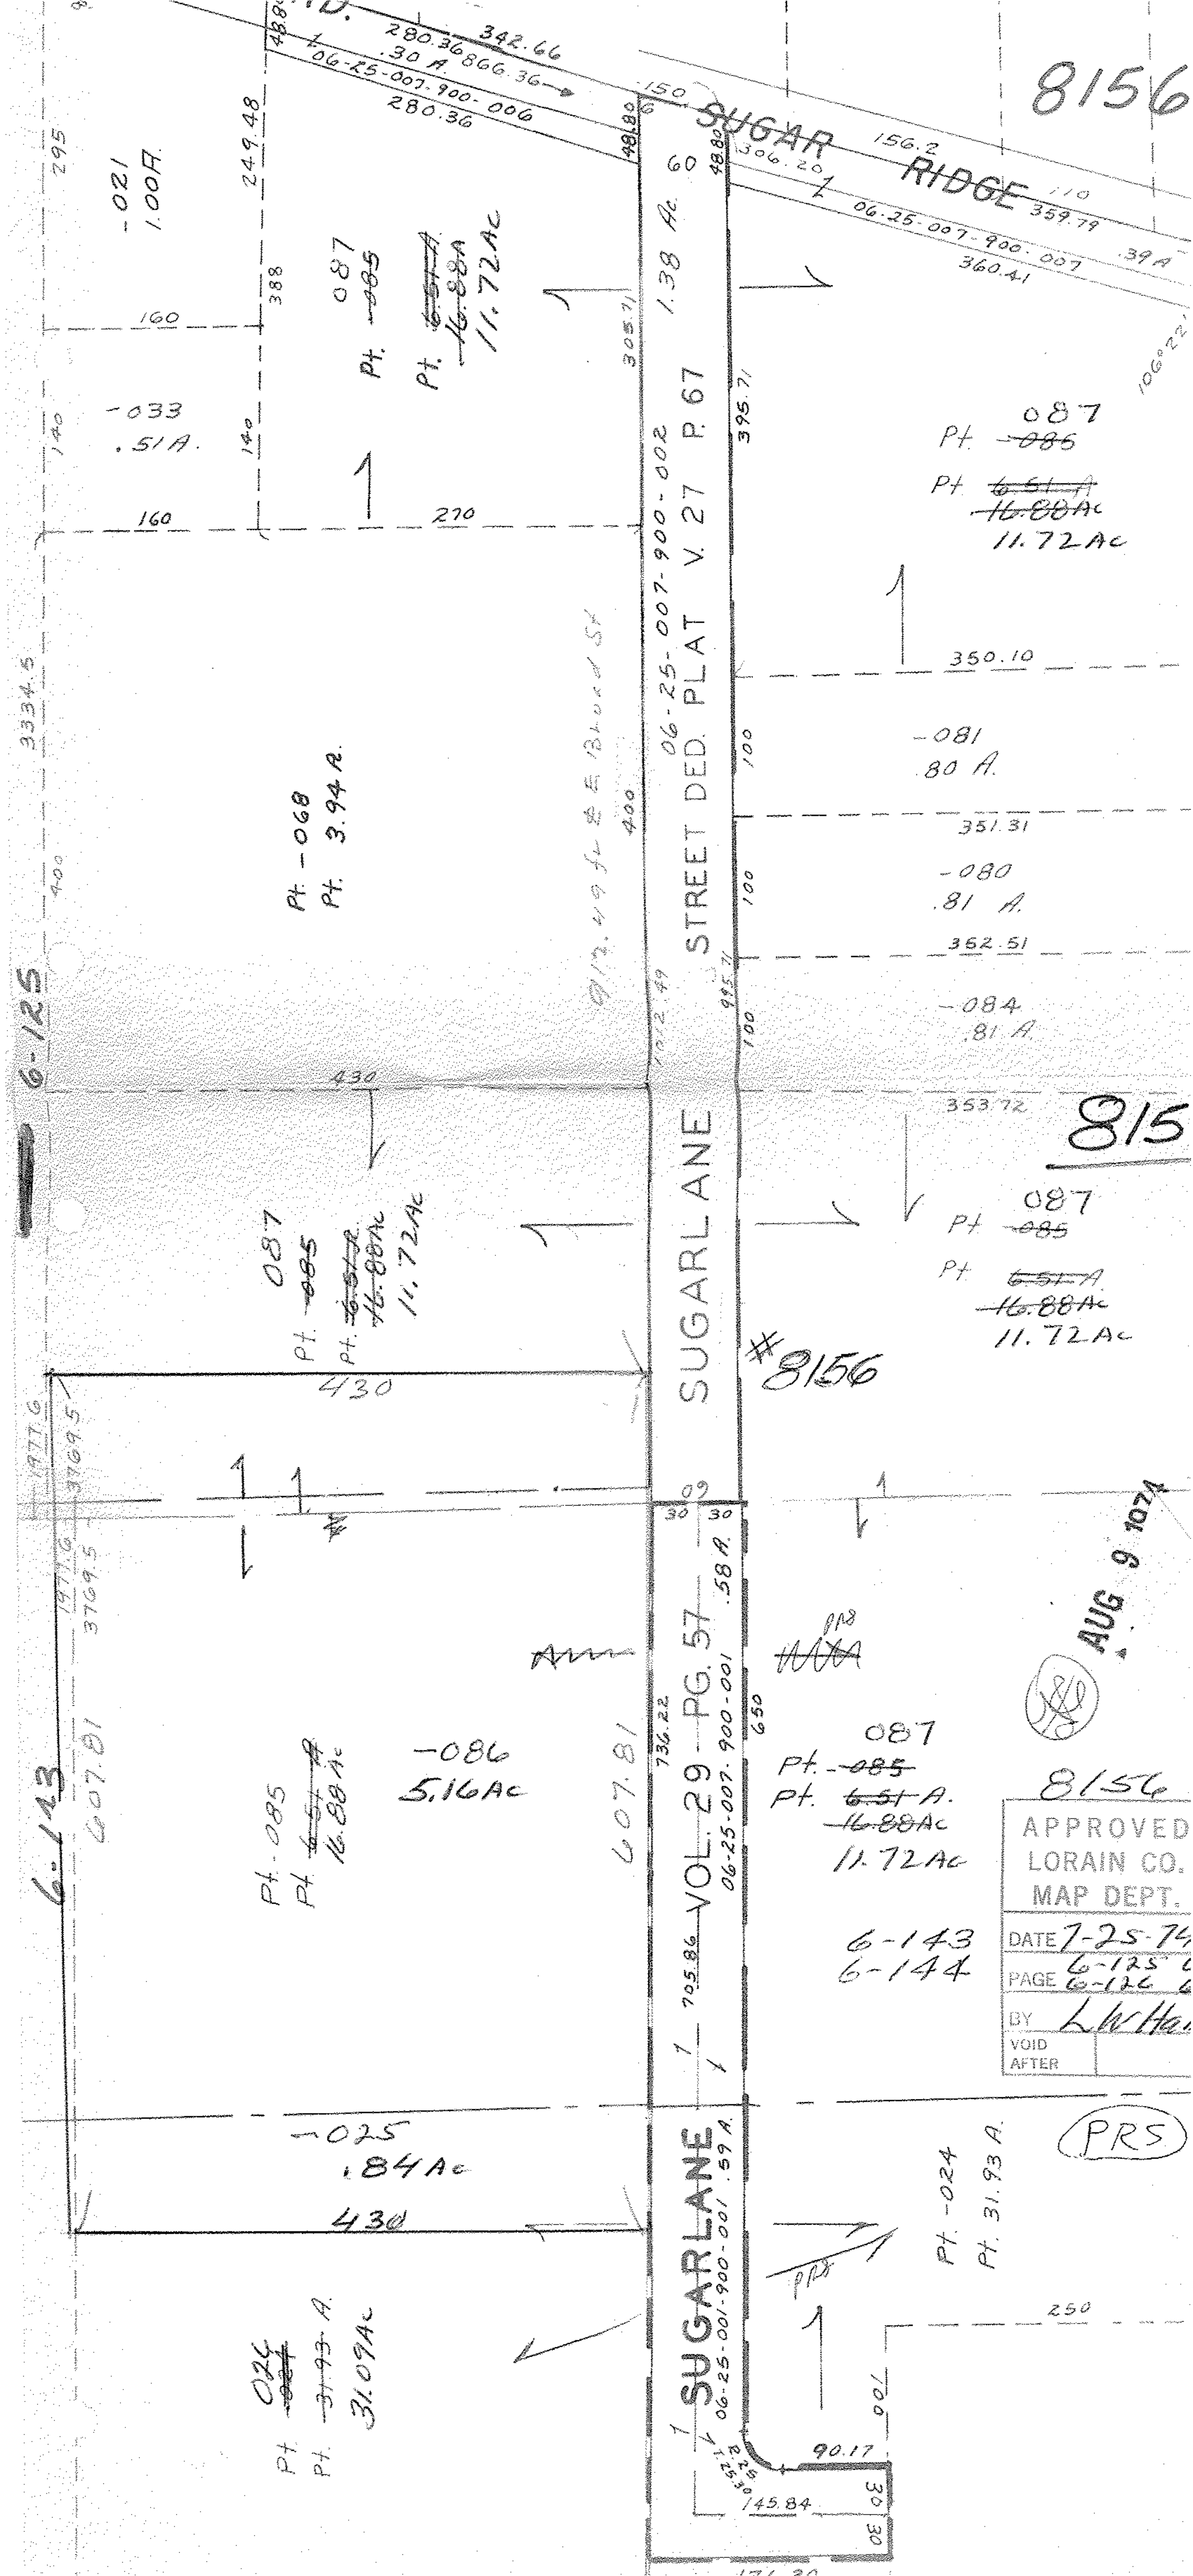
8156
SUGAR RIDGE
06-25-007-900-006
280.36
342.66
866.36
.30 A.
06-25-007-900-007
359.79
360.41
.39 A
-021
1.00 A.
249.48
087
Pt. -085
Pt. 6.51 A.
16.88 A
11.72 Ac
-033
.51 A.
160
270
1.38 Ac
305.71
395.71
06-25-007-900-002
STREET DED. PLAT V. 27 P. 67
087
Pt. -085
Pt. 6.51 A.
16.88 Ac
11.72 Ac
350.10
-081
.80 A.
351.31
-080
.81 A.
352.51
-084
.81 A.
353.72
815
Pt. -068
Pt. 3.94 A.
3334.5
6-125
430
SUGARLANE
087
Pt. -085
Pt. 6.51 A.
16.88 Ac
11.72 Ac
#8156
430
AUG 9 1974
VOL. 29 PG. 57
06-25-007-900-001
.58 A.
736.22
650
-086
5.16 Ac
607.81
Pt. -085
Pt. 6.51 A.
16.88 Ac
6-143
087
Pt. -085
Pt. 6.51 A.
16.88 Ac
11.72 Ac
6-143
6-144
705.86
8156
APPROVED
LORAIN CO.
MAP DEPT.
DATE 7-25-74
PAGE 6-125
6-126
BY LWHa
VOID AFTER
-025
.84 Ac
430
SUGARLANE
06-25-001-900-001
.59 A.
PRS
Pt. -024
Pt. 31.93 A.
250
Pt. 024
Pt. 31.93 A.
31.09 Ac
90.17
145.84