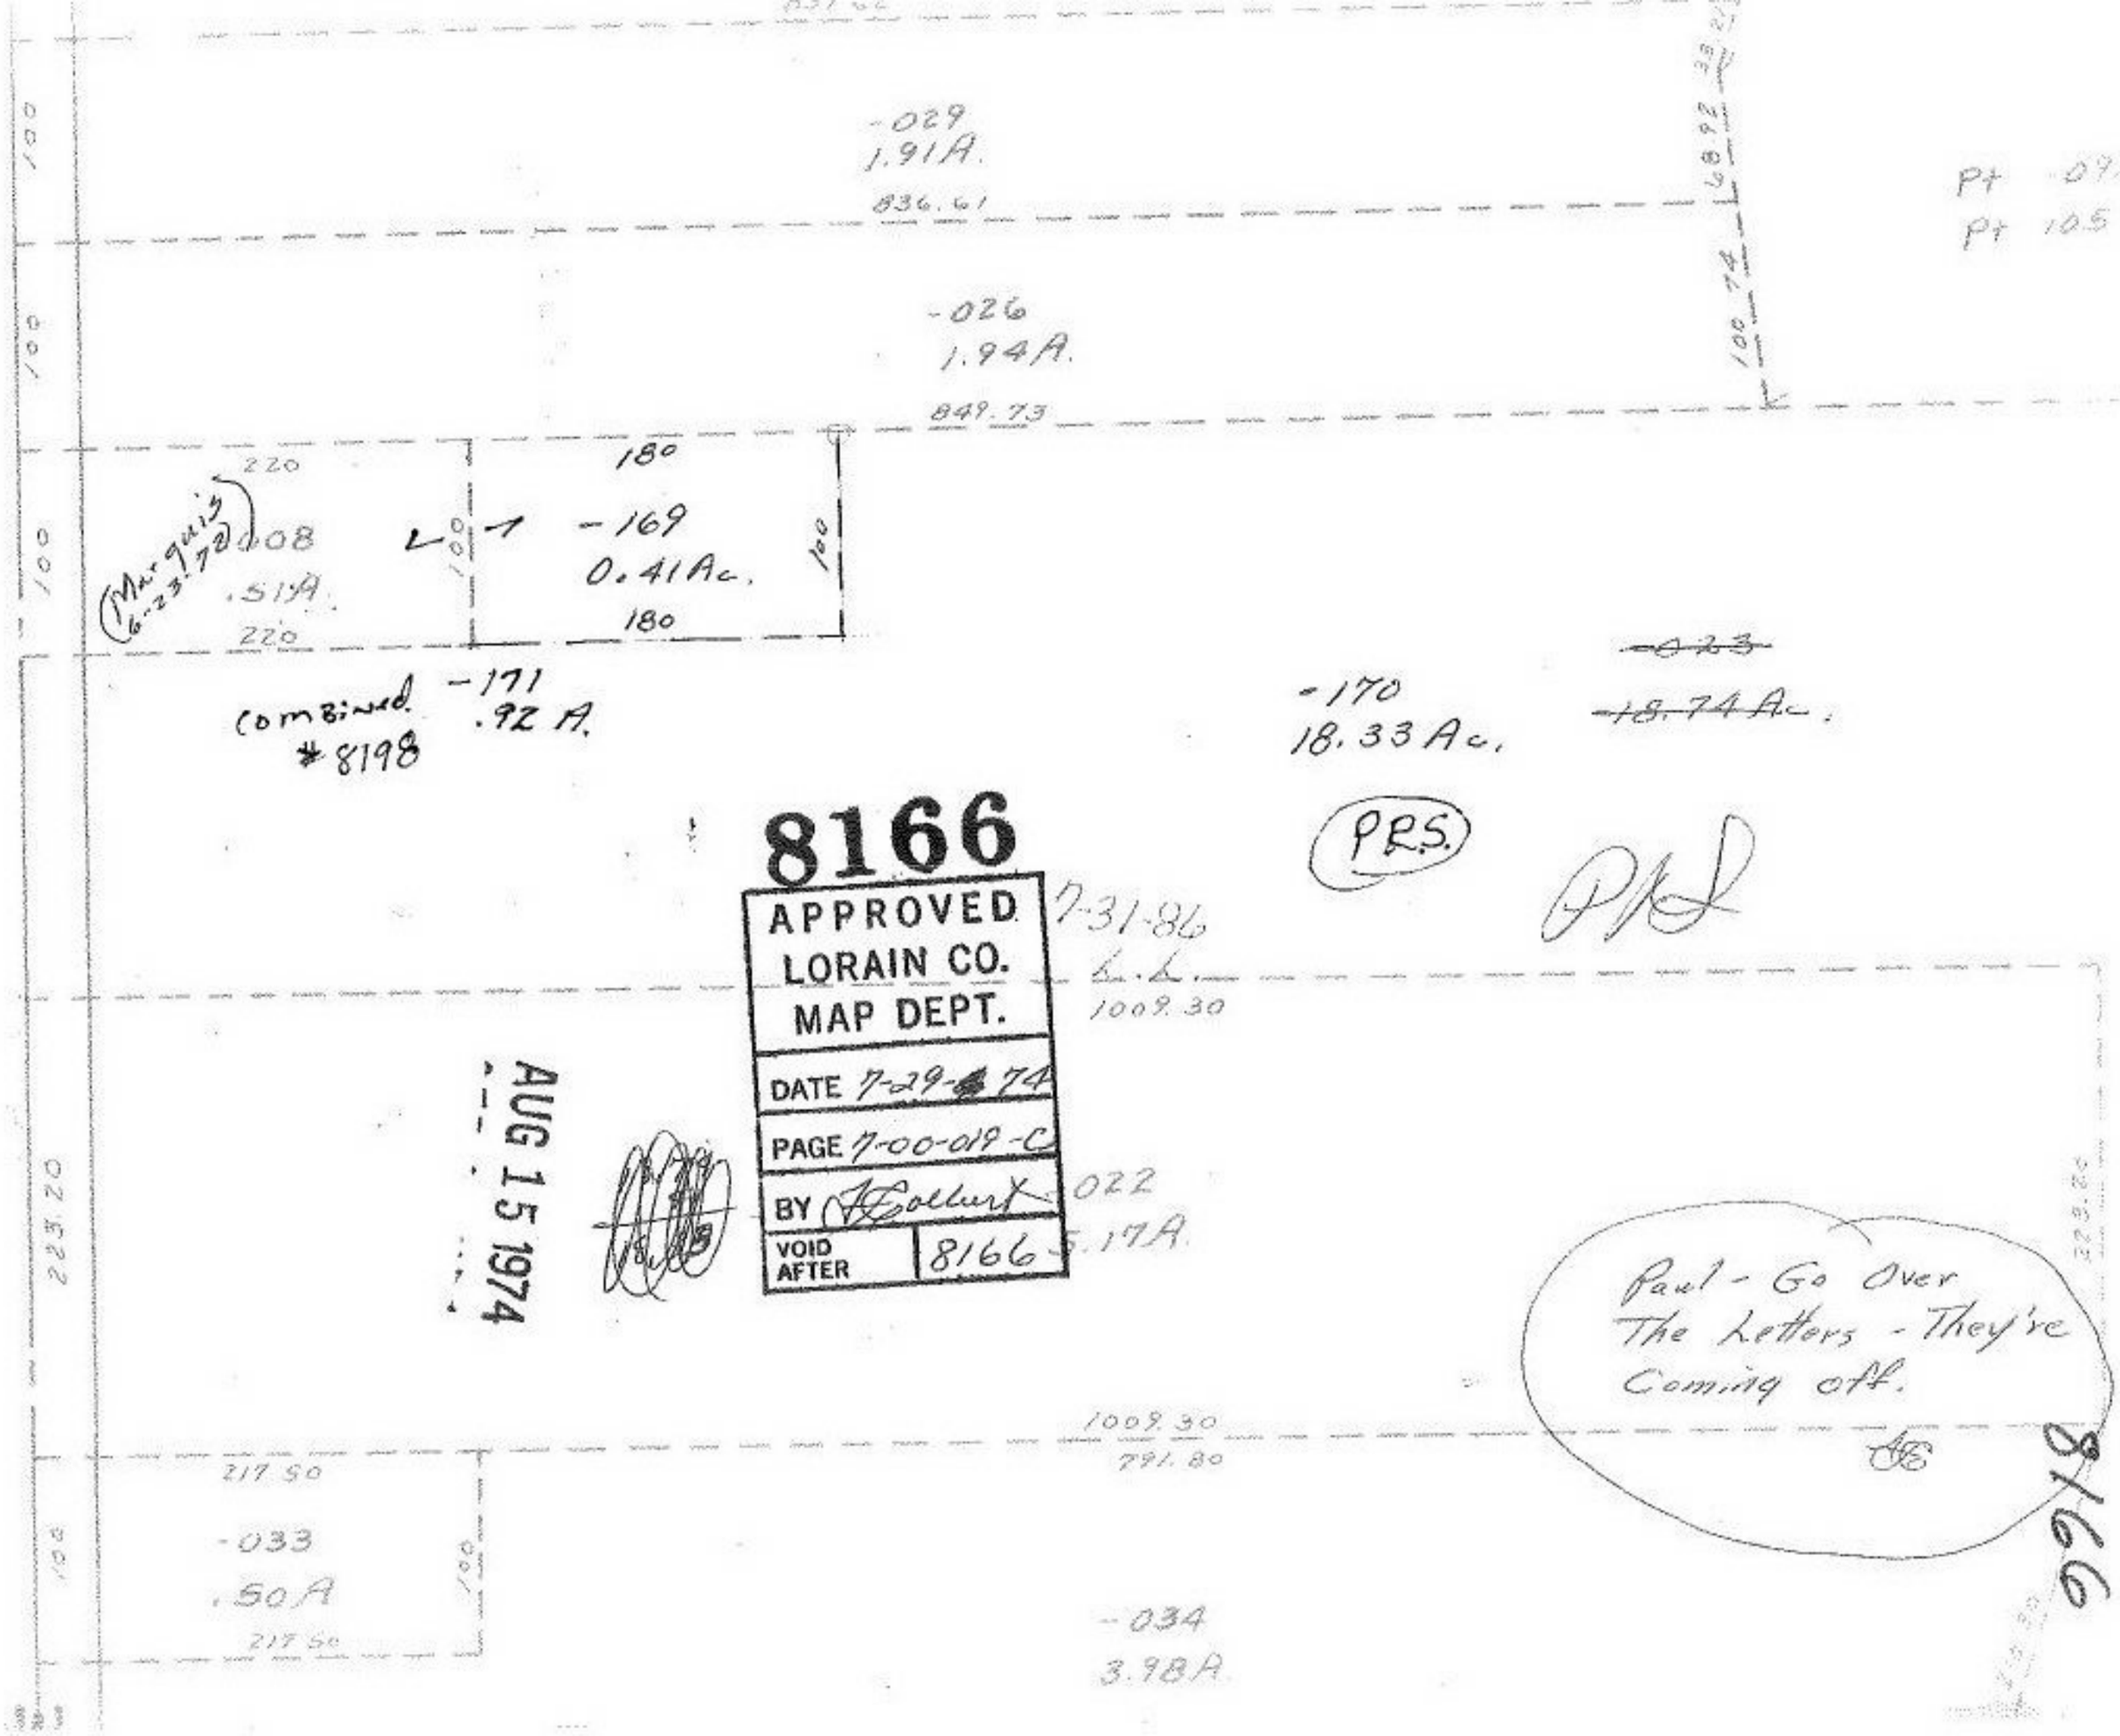

-029
1.91A.
836.61
-026
1.94A.
849.73
Pt -091
Pt 105
220
180
-169
0.41Ac.
180
(Marquis 6-23-72)
.008
.51A.
220
combined #8198
-171
.92 A.
-170
18.33 Ac.
~~-023~~
~~18.74 Ac.~~
PRS.
8166
APPROVED
LORAIN CO.
MAP DEPT.
DATE 7-29-74
PAGE 7-00-019-C
BY
VOID AFTER 8166
7-31-86
L.L.
1009.30
AUG 15 1974
-022
5.17A.
Paul - Go Over The Letters - They're Coming off.
1009.30
791.80
217.50
-033
.50A
217.50
-034
3.98A
8166