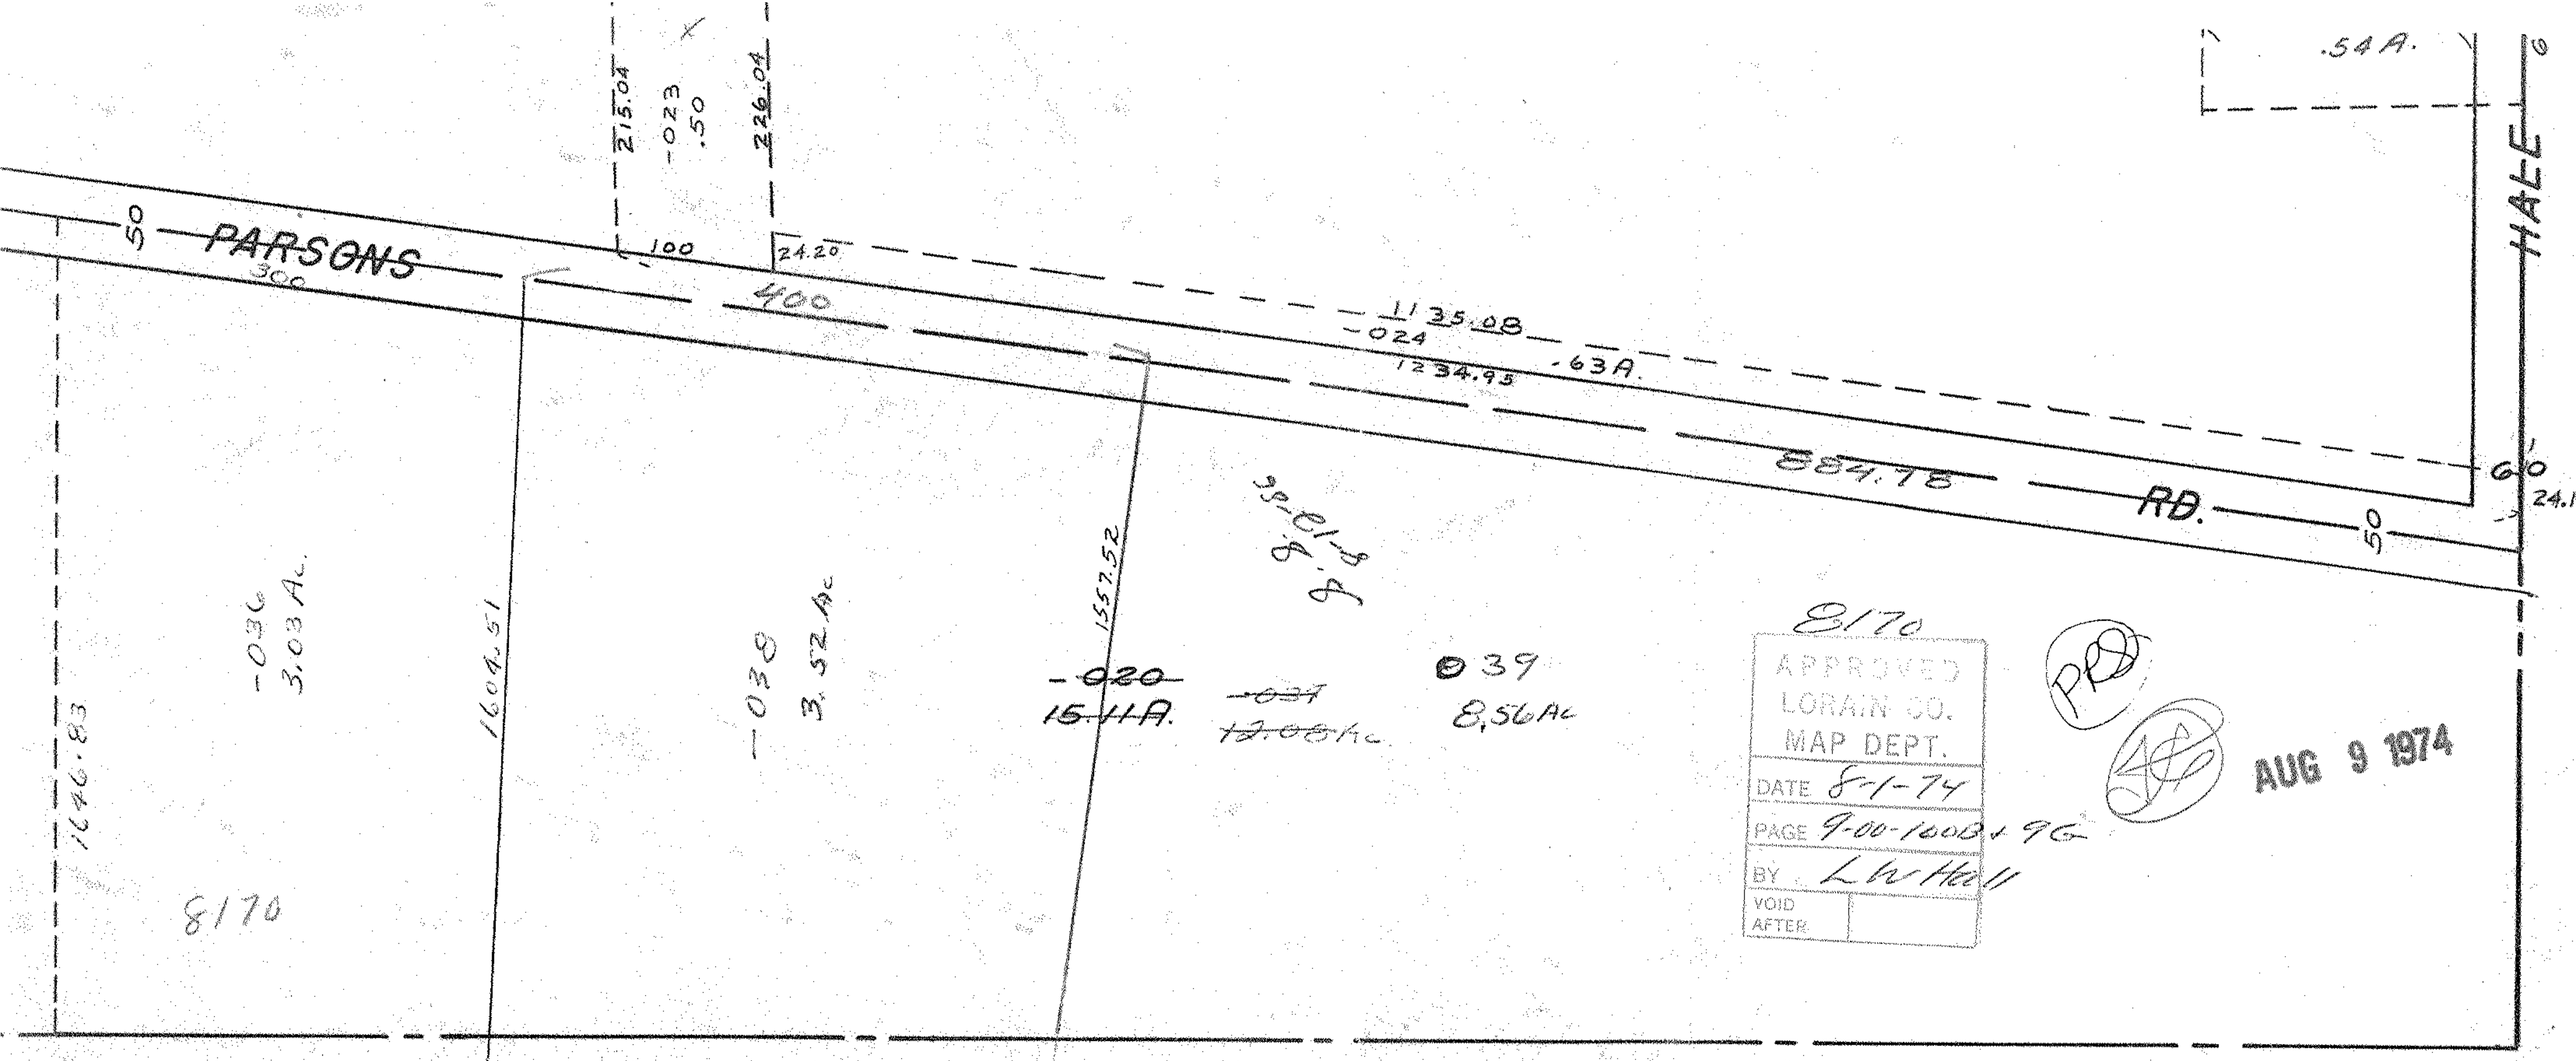
.54A.
HALE
215.04
-023
.50
226.04
50
PARSONS
300
100
24.20
400
1135.08
-024
1234.93
.63A.
884.78
RD.
50
60
24.1
1646.83
-036
3.03 Ac.
1604.51
-038
3.32 Ac
1557.52
9-H
-020
15.44A.
-037
12.00Ac
039
8.56Ac
8170
SEE 9-H
8112
8170
APPROVED
LORAIN CO.
MAP DEPT.
DATE 8-1-74
PAGE 9-00-1000 + 96
BY L W Hall
VOID
AFTER
PRO
AUG 9 1974

RUSSIA TWP.