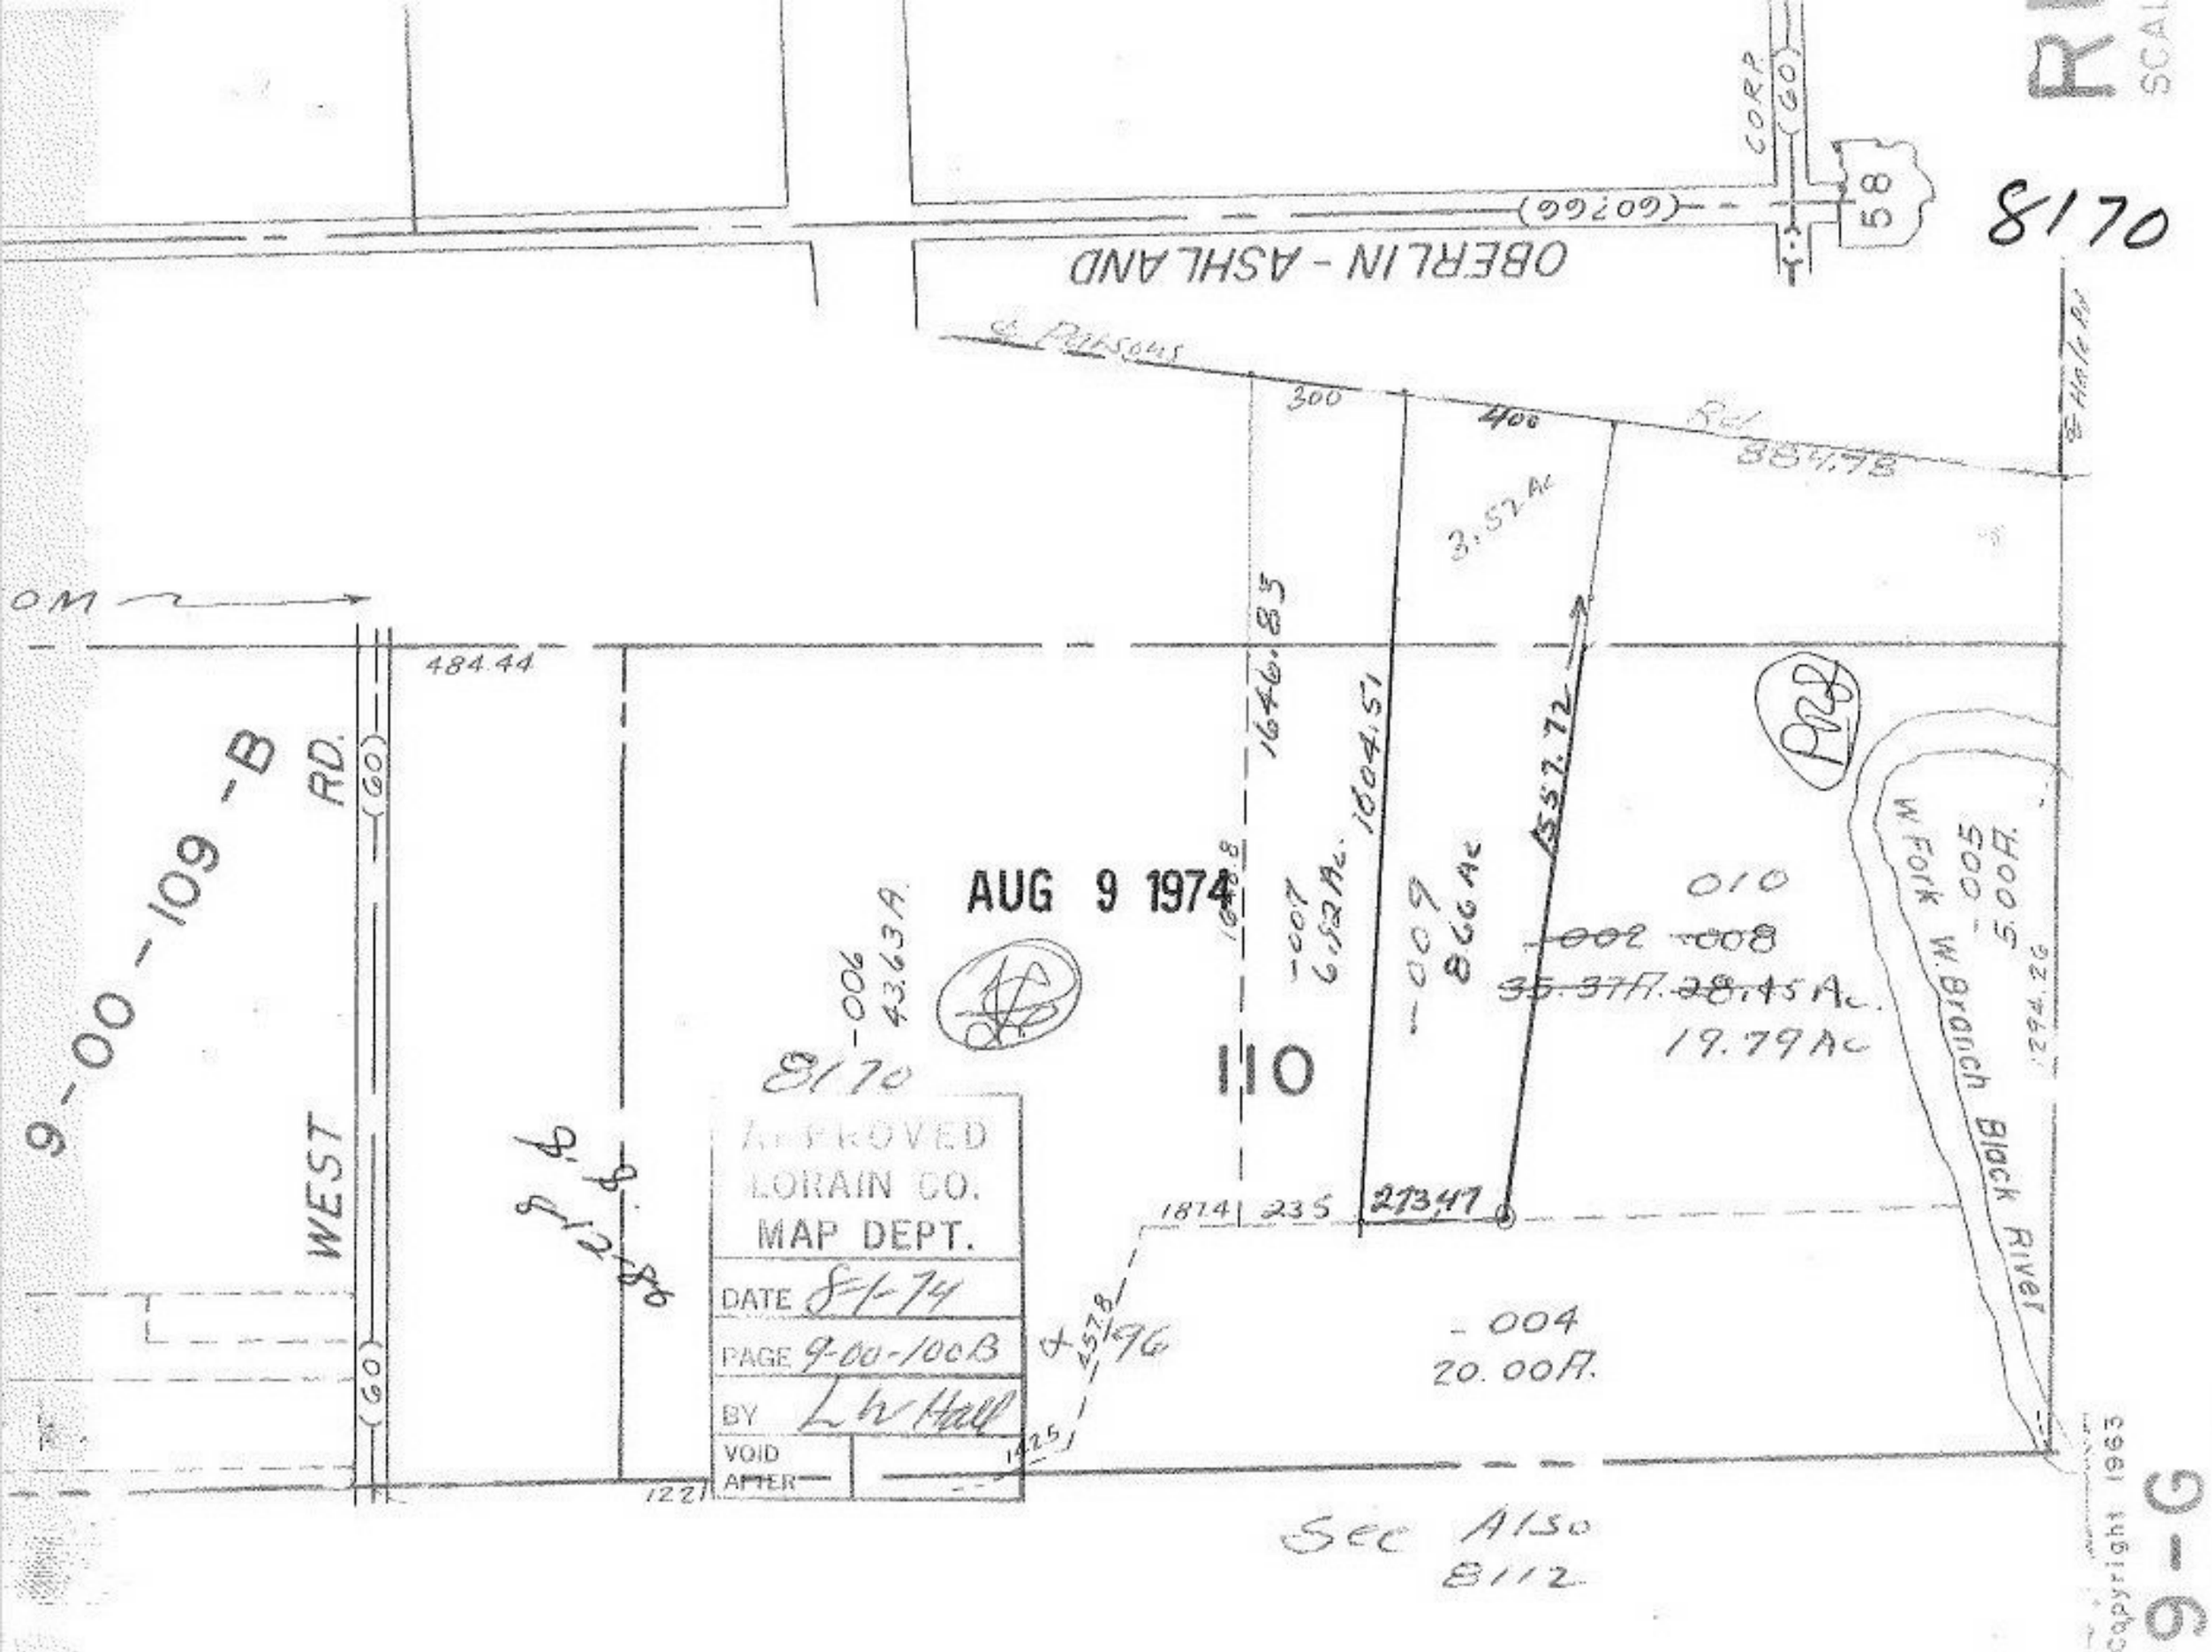

8170
OBERLIN - ASHLAND
(60?66)
CORP.
(60)
58
℄ Parsons
300
400
Rd
884.78
℄ Hale Rd
3.52 Ac
OM
484.44
9-00-109-B
WEST RD.
(60)
1646.83
1604.51
1557.72
AUG 9 1974
-006
43.63 A
8170
110
-007
6.52 Ac.
-009
8.66 Ac
010
-002 -008
35.37 A. 28.45 Ac.
19.79 Ac
-005
5.00 A.
W. Fork W. Branch Black River
1294.26
1874
235
273.47
-004
20.00 A.
APPROVED
LORAIN CO.
MAP DEPT.
DATE 8-1-74
PAGE 9-00-100B
BY L W Hall
VOID AFTER
1221
1425
457.8
96
Sec Also
8112
Copyright 1963
9-G