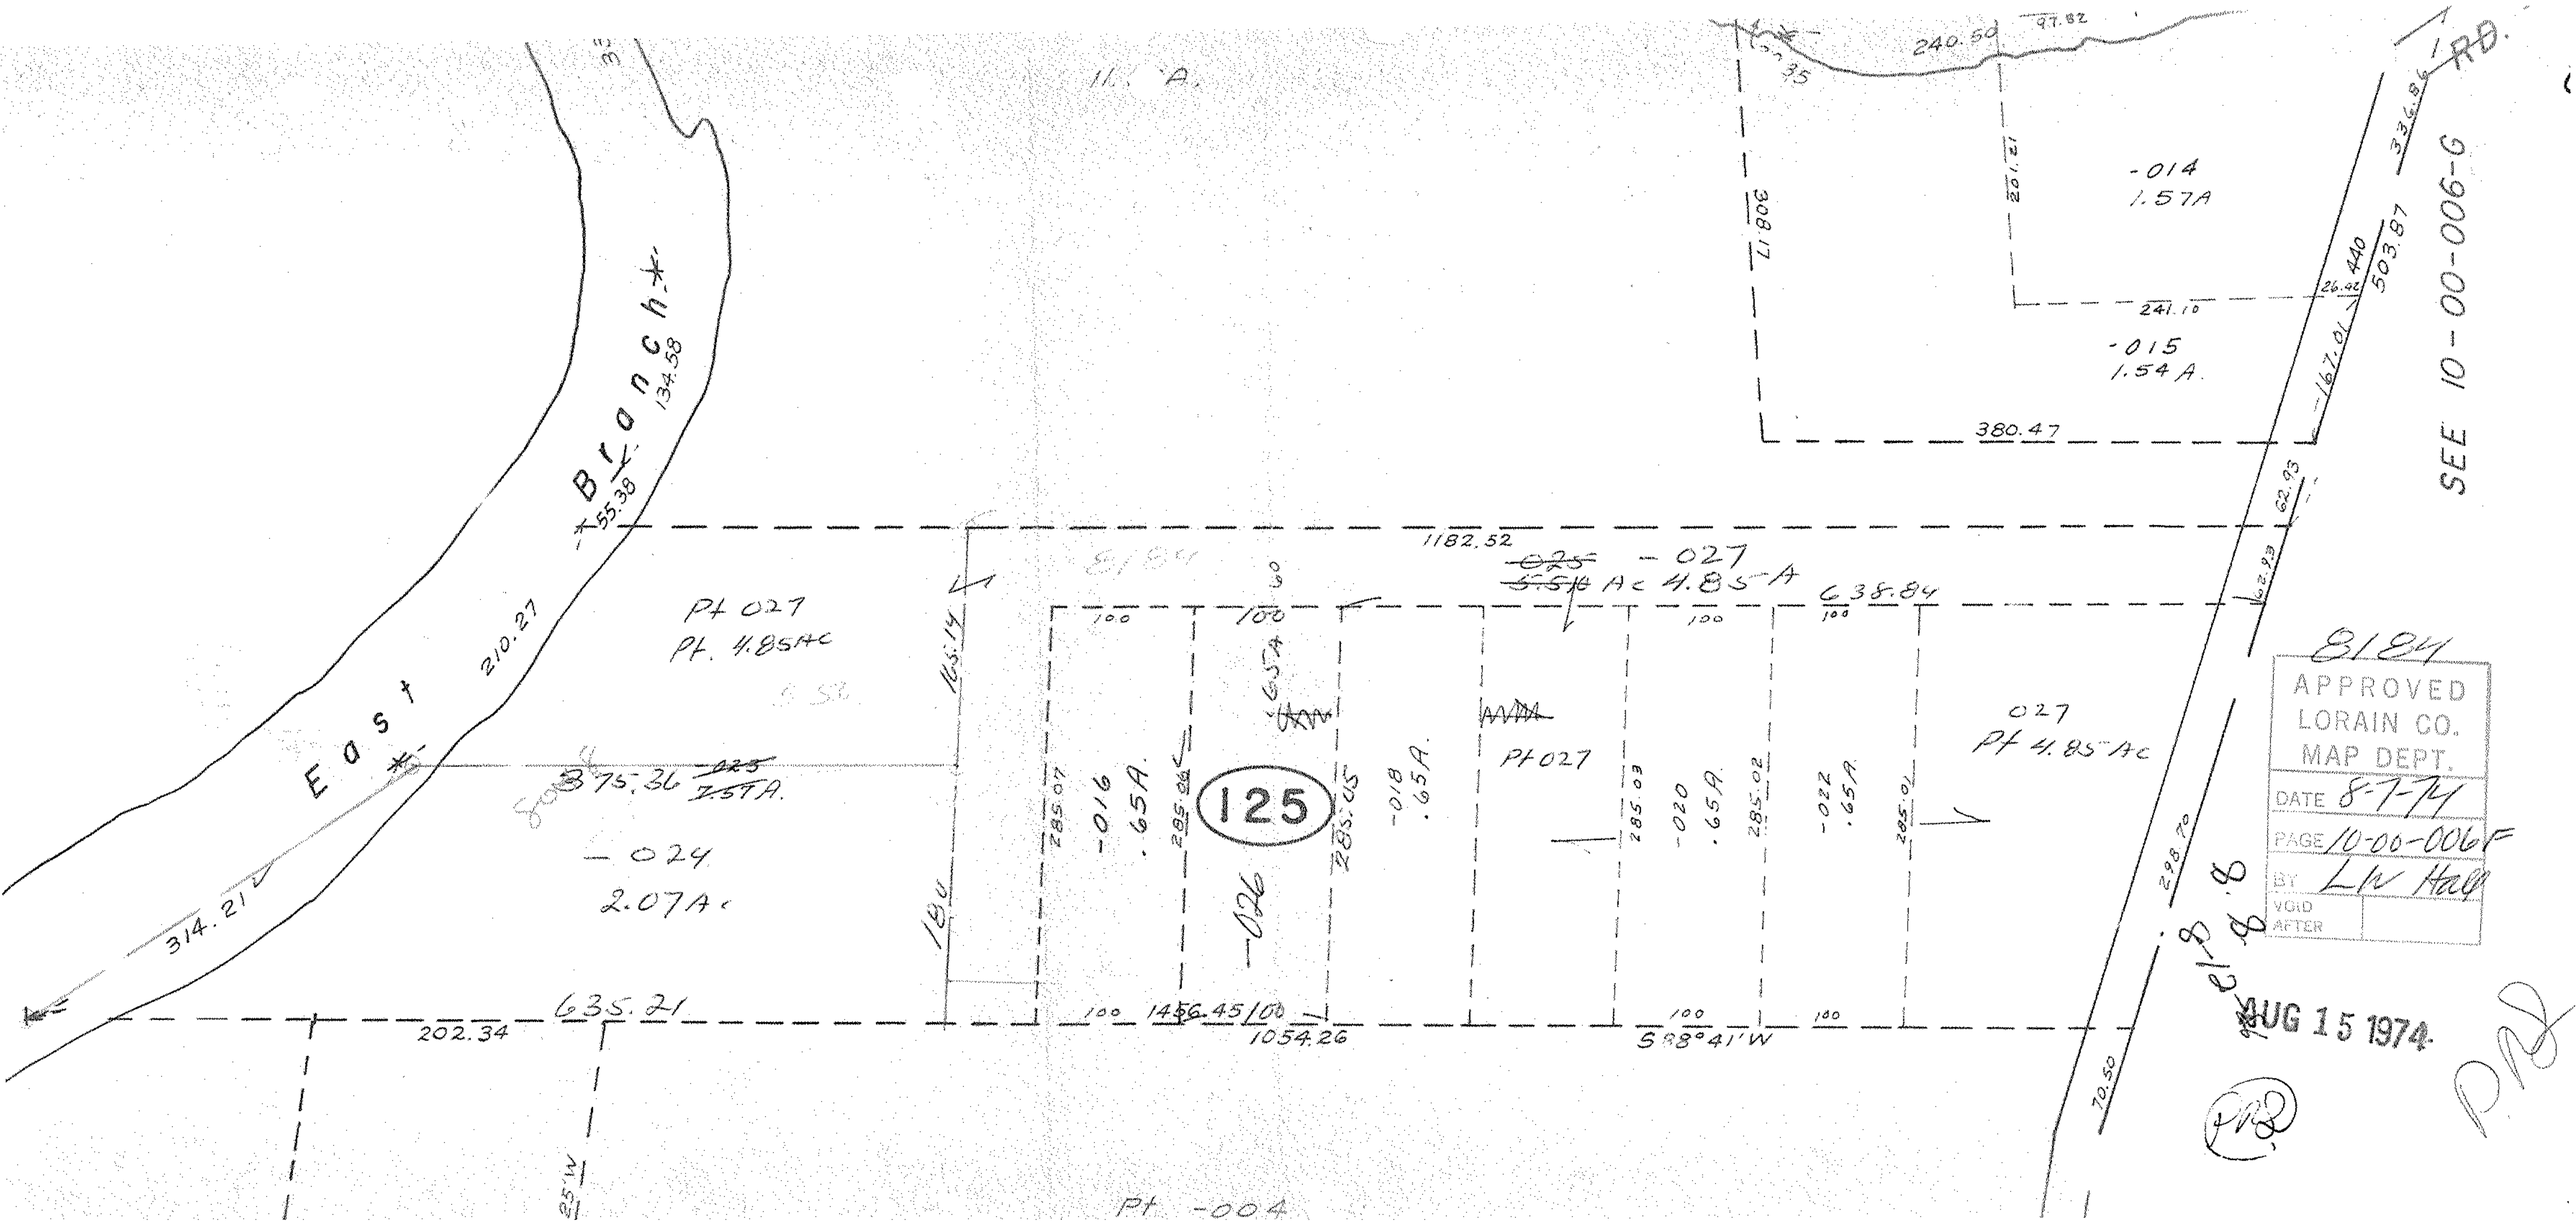

East Branch
134.58
55.38
210.27
314.21
Pt 027
Pt. 4.85Ac
375.36
-024
2.07Ac
635.21
202.34
1182.52
-027
4.85A
638.84
-016
.65A
-018
.65A
-020
.65A
-022
.65A
125
-026
Pt 027
027
Pt 4.85 Ac
1456.45
1054.26
S88°41'W
Pt -004
240.50
97.82
308.17
-014
1.57A
-015
1.54A
241.10
380.47
503.87
SEE 10-00-006-G
RD.
8184
APPROVED
LORAIN CO.
MAP DEPT.
DATE 8-7-74
PAGE 10-00-006F
BY LW Hall
VOID AFTER
AUG 15 1974