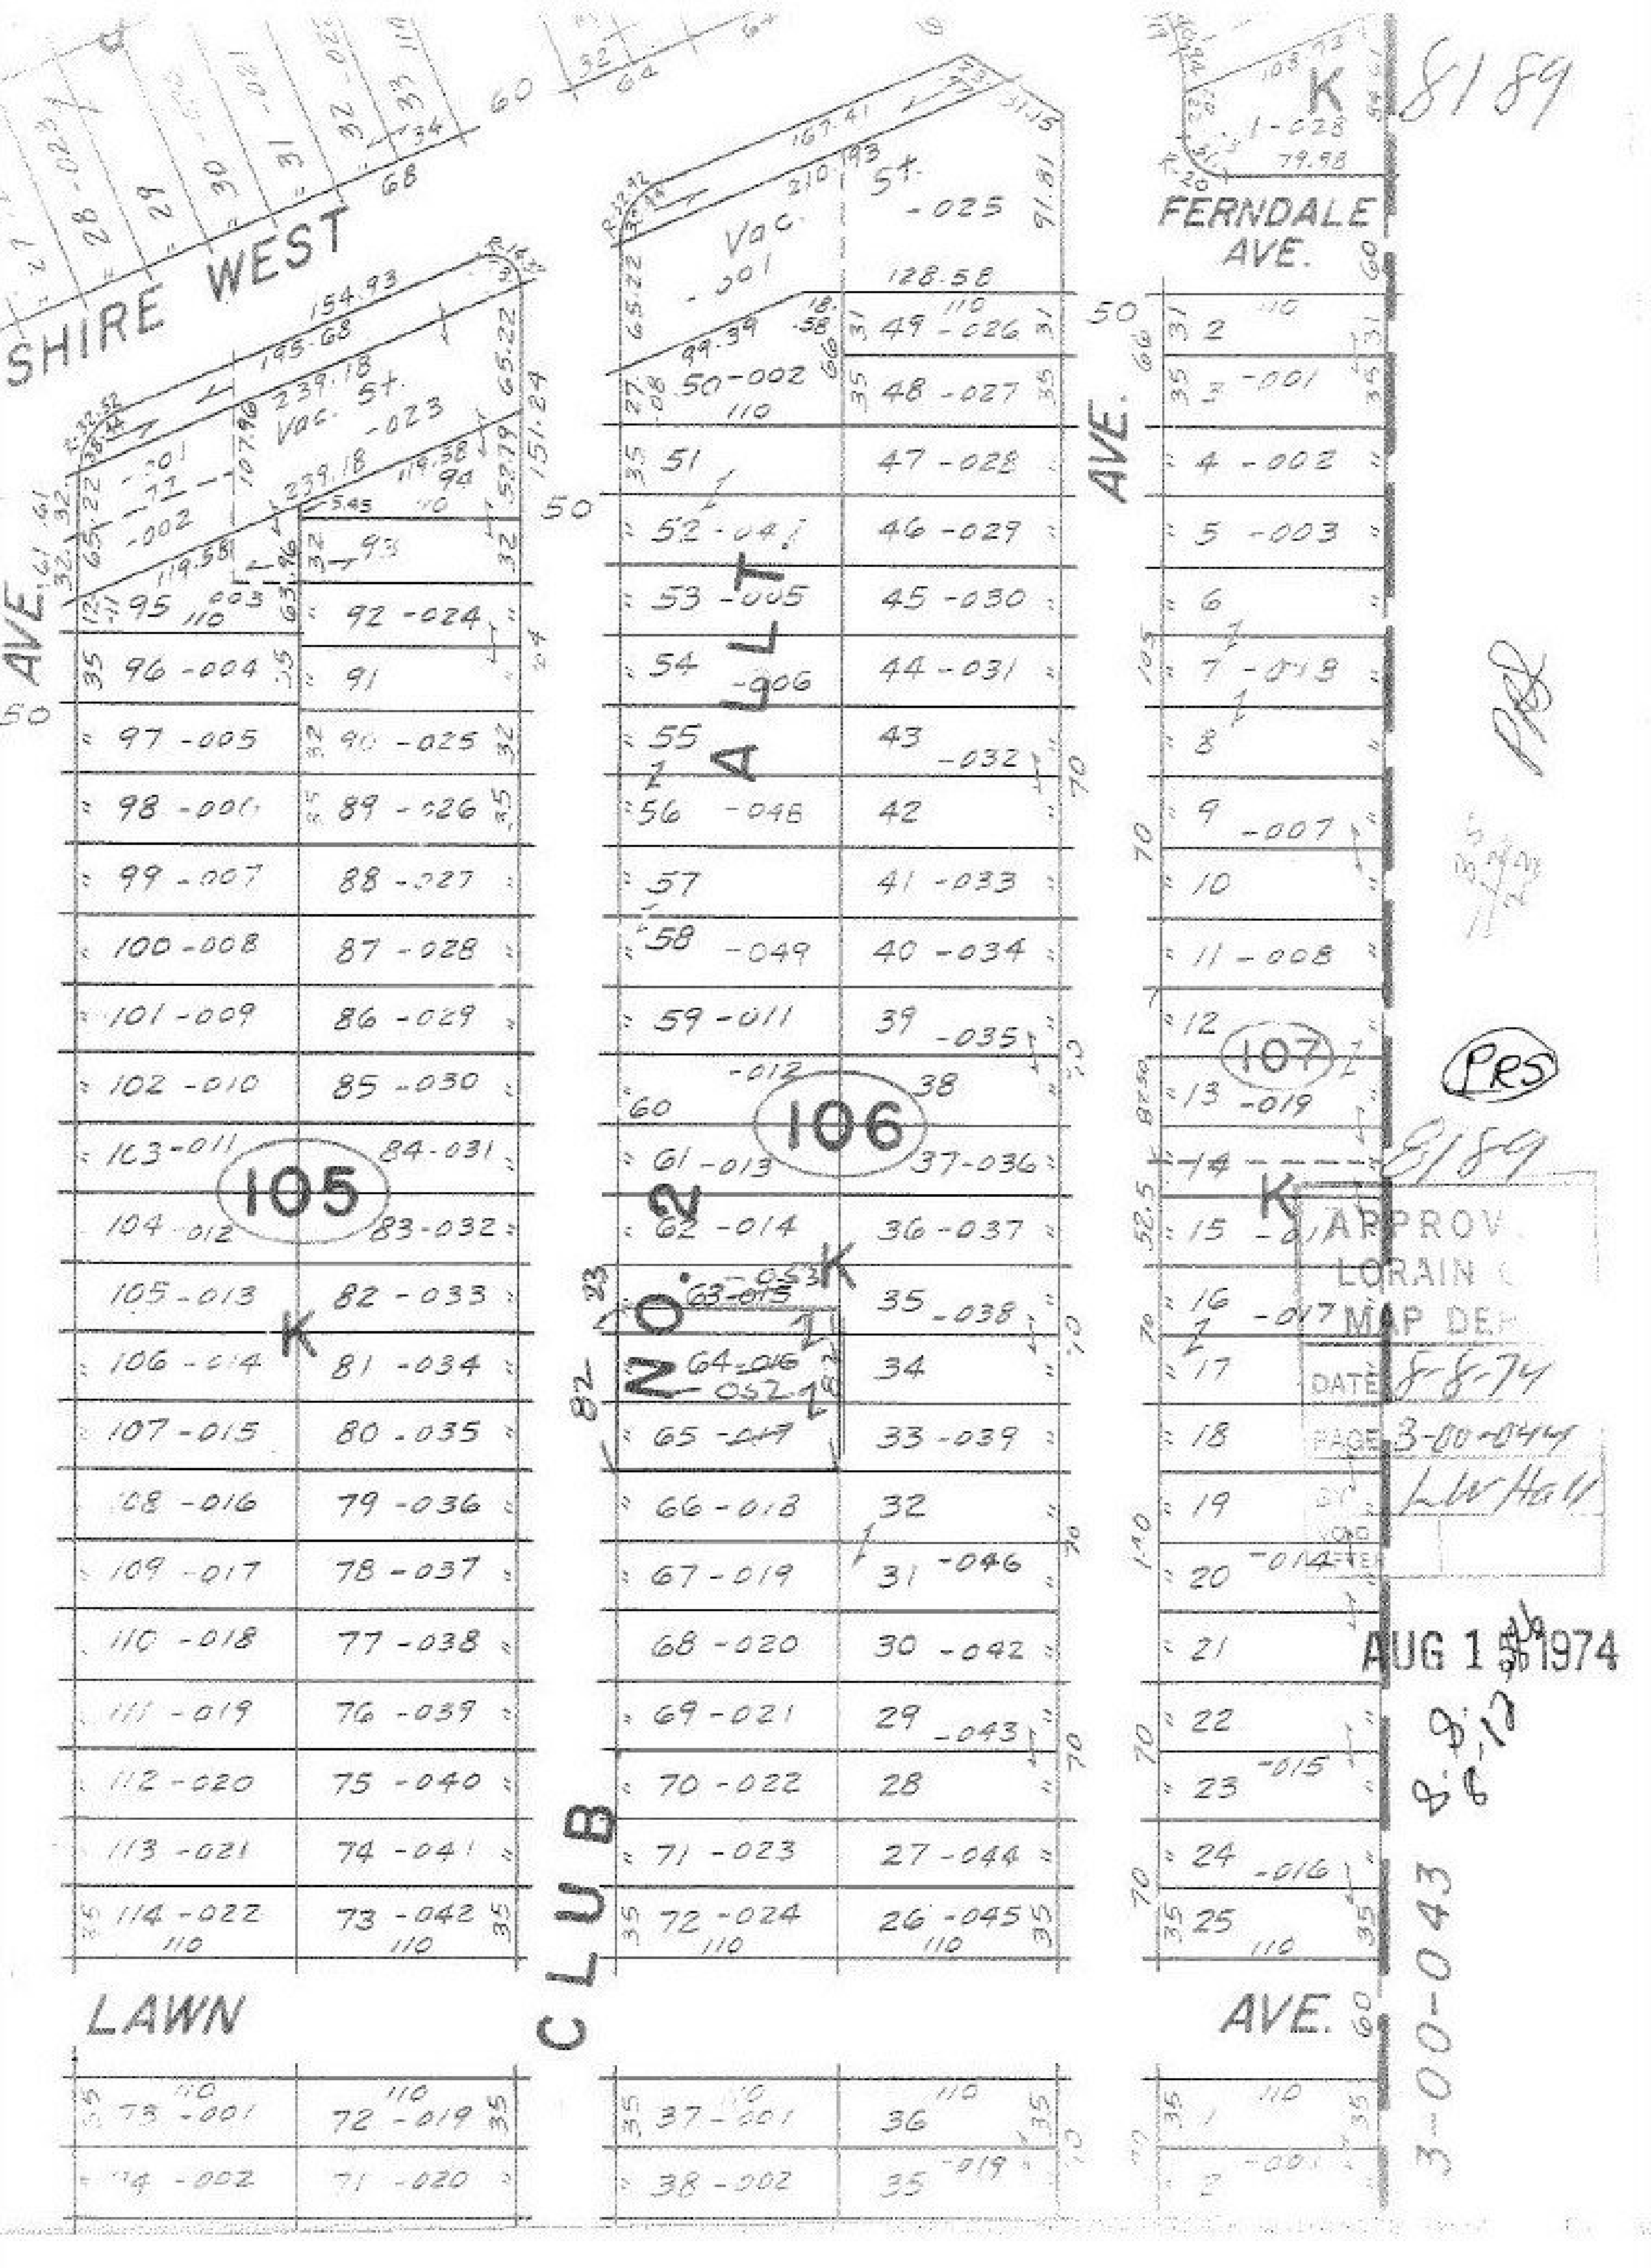
8189
SHIRE WEST
FERNDALE AVE.
AVE.
AVE.
LAWN
AVE.
CLUB NO. 2 ALLT.
Vac. St.
-023
Vac.
-001
St.
-025
K
1-028
105
106
107
95 -003
96 -004
97 -005
98 -006
99 -007
100 -008
101 -009
102 -010
103 -011
104 -012
105 -013
106 -014
107 -015
108 -016
109 -017
110 -018
111 -019
112 -020
113 -021
114 -022
92 -024
91
90 -025
89 -026
88 -027
87 -028
86 -029
85 -030
84 -031
83 -032
82 -033
81 -034
80 -035
79 -036
78 -037
77 -038
76 -039
75 -040
74 -041
73 -042
50 -002
51
52 -041
53 -005
54 -006
55
56 -048
57
58 -049
59 -011
60 -012
61 -013
62 -014
63 -015 -053
64 -016 -052
65 -017
66 -018
67 -019
68 -020
69 -021
70 -022
71 -023
72 -024
49 -026
48 -027
47 -028
46 -029
45 -030
44 -031
43 -032
42
41 -033
40 -034
39 -035
38
37 -036
36 -037
35 -038
34
33 -039
32
31 -046
30 -042
29 -043
28
27 -044
26 -045
2
3 -001
4 -002
5 -003
6
7 -018
8
9 -007
10
11 -008
12
13 -019
14
15
16 -017
17
18
19
20 -014
21
22
23 -015
24 -016
25
73 -001
74 -002
72 -019
71 -020
37 -001
38 -002
36
35 -019
PRS
APPROV
LORAIN
MAP DEP
DATE 8-8-74
PAGE 3-00-044
BY L.W. Hall
AUG 1 1974
8-8
8-12
3-00-043