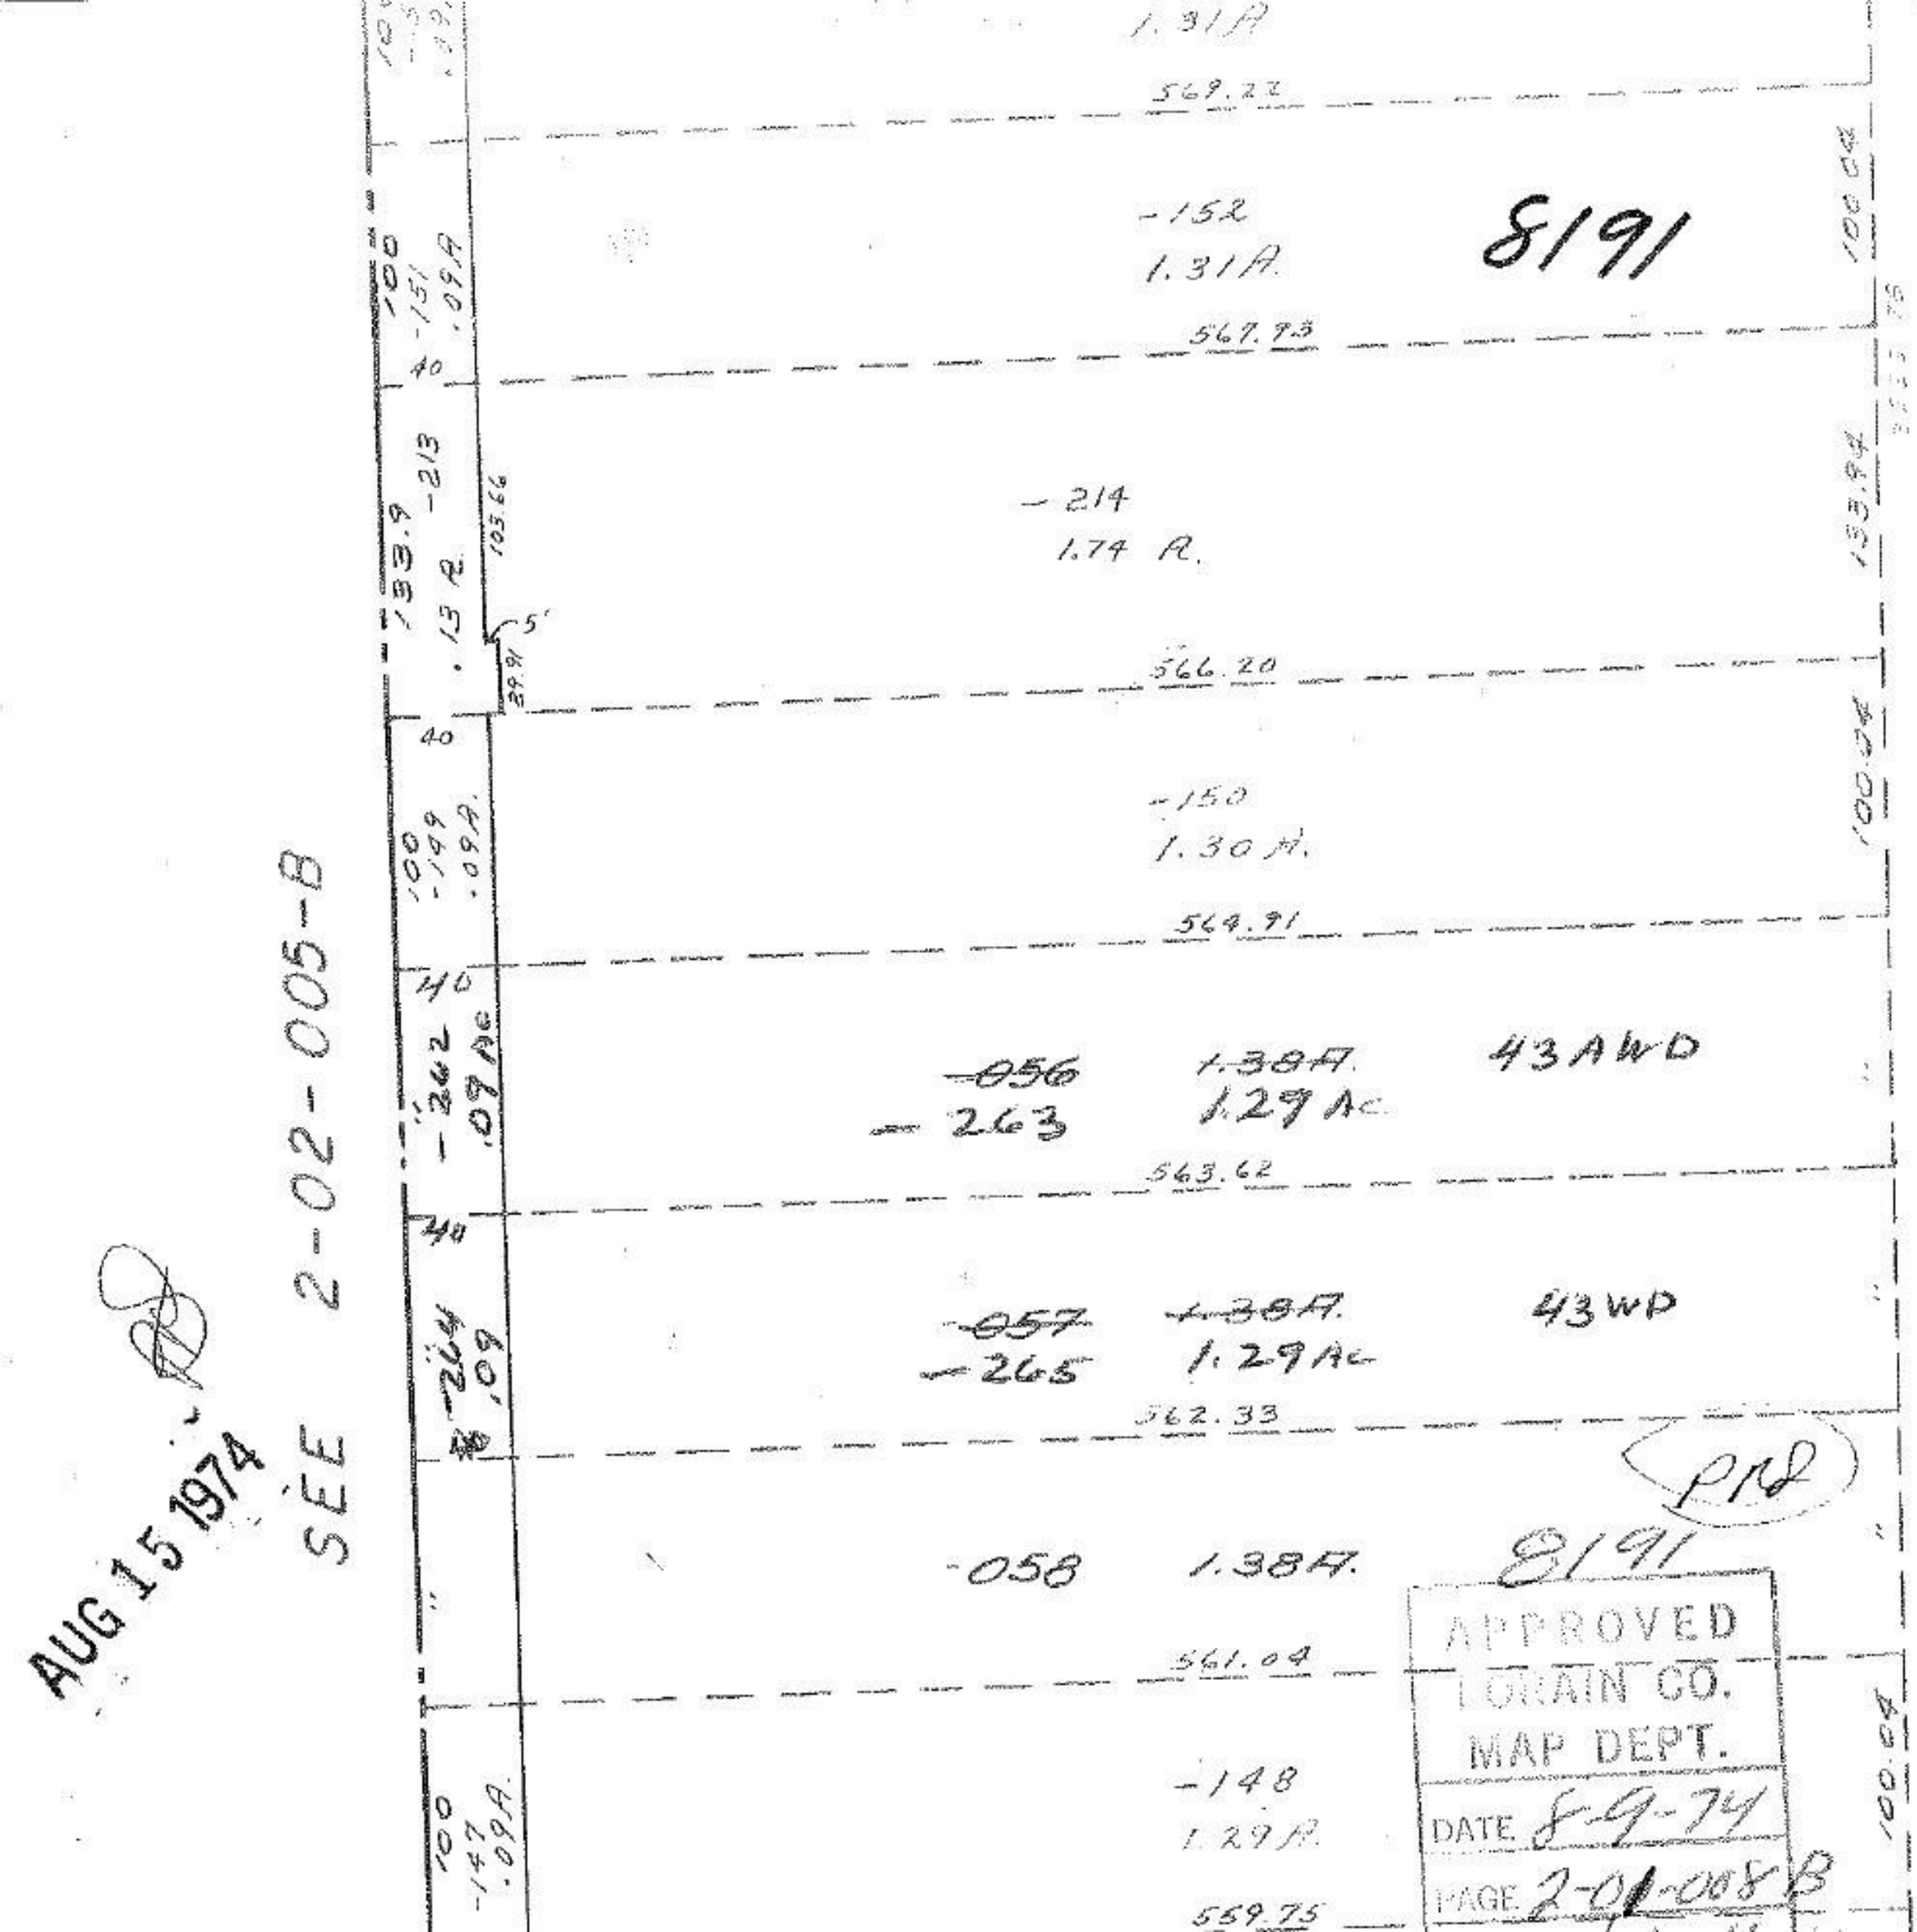

AUG 15 1974

SEE 2-02-005-B

PRD

APPROVED
LORAIN CO.
MAP DEPT.
DATE 8-9-74
PAGE 2-01-008 B