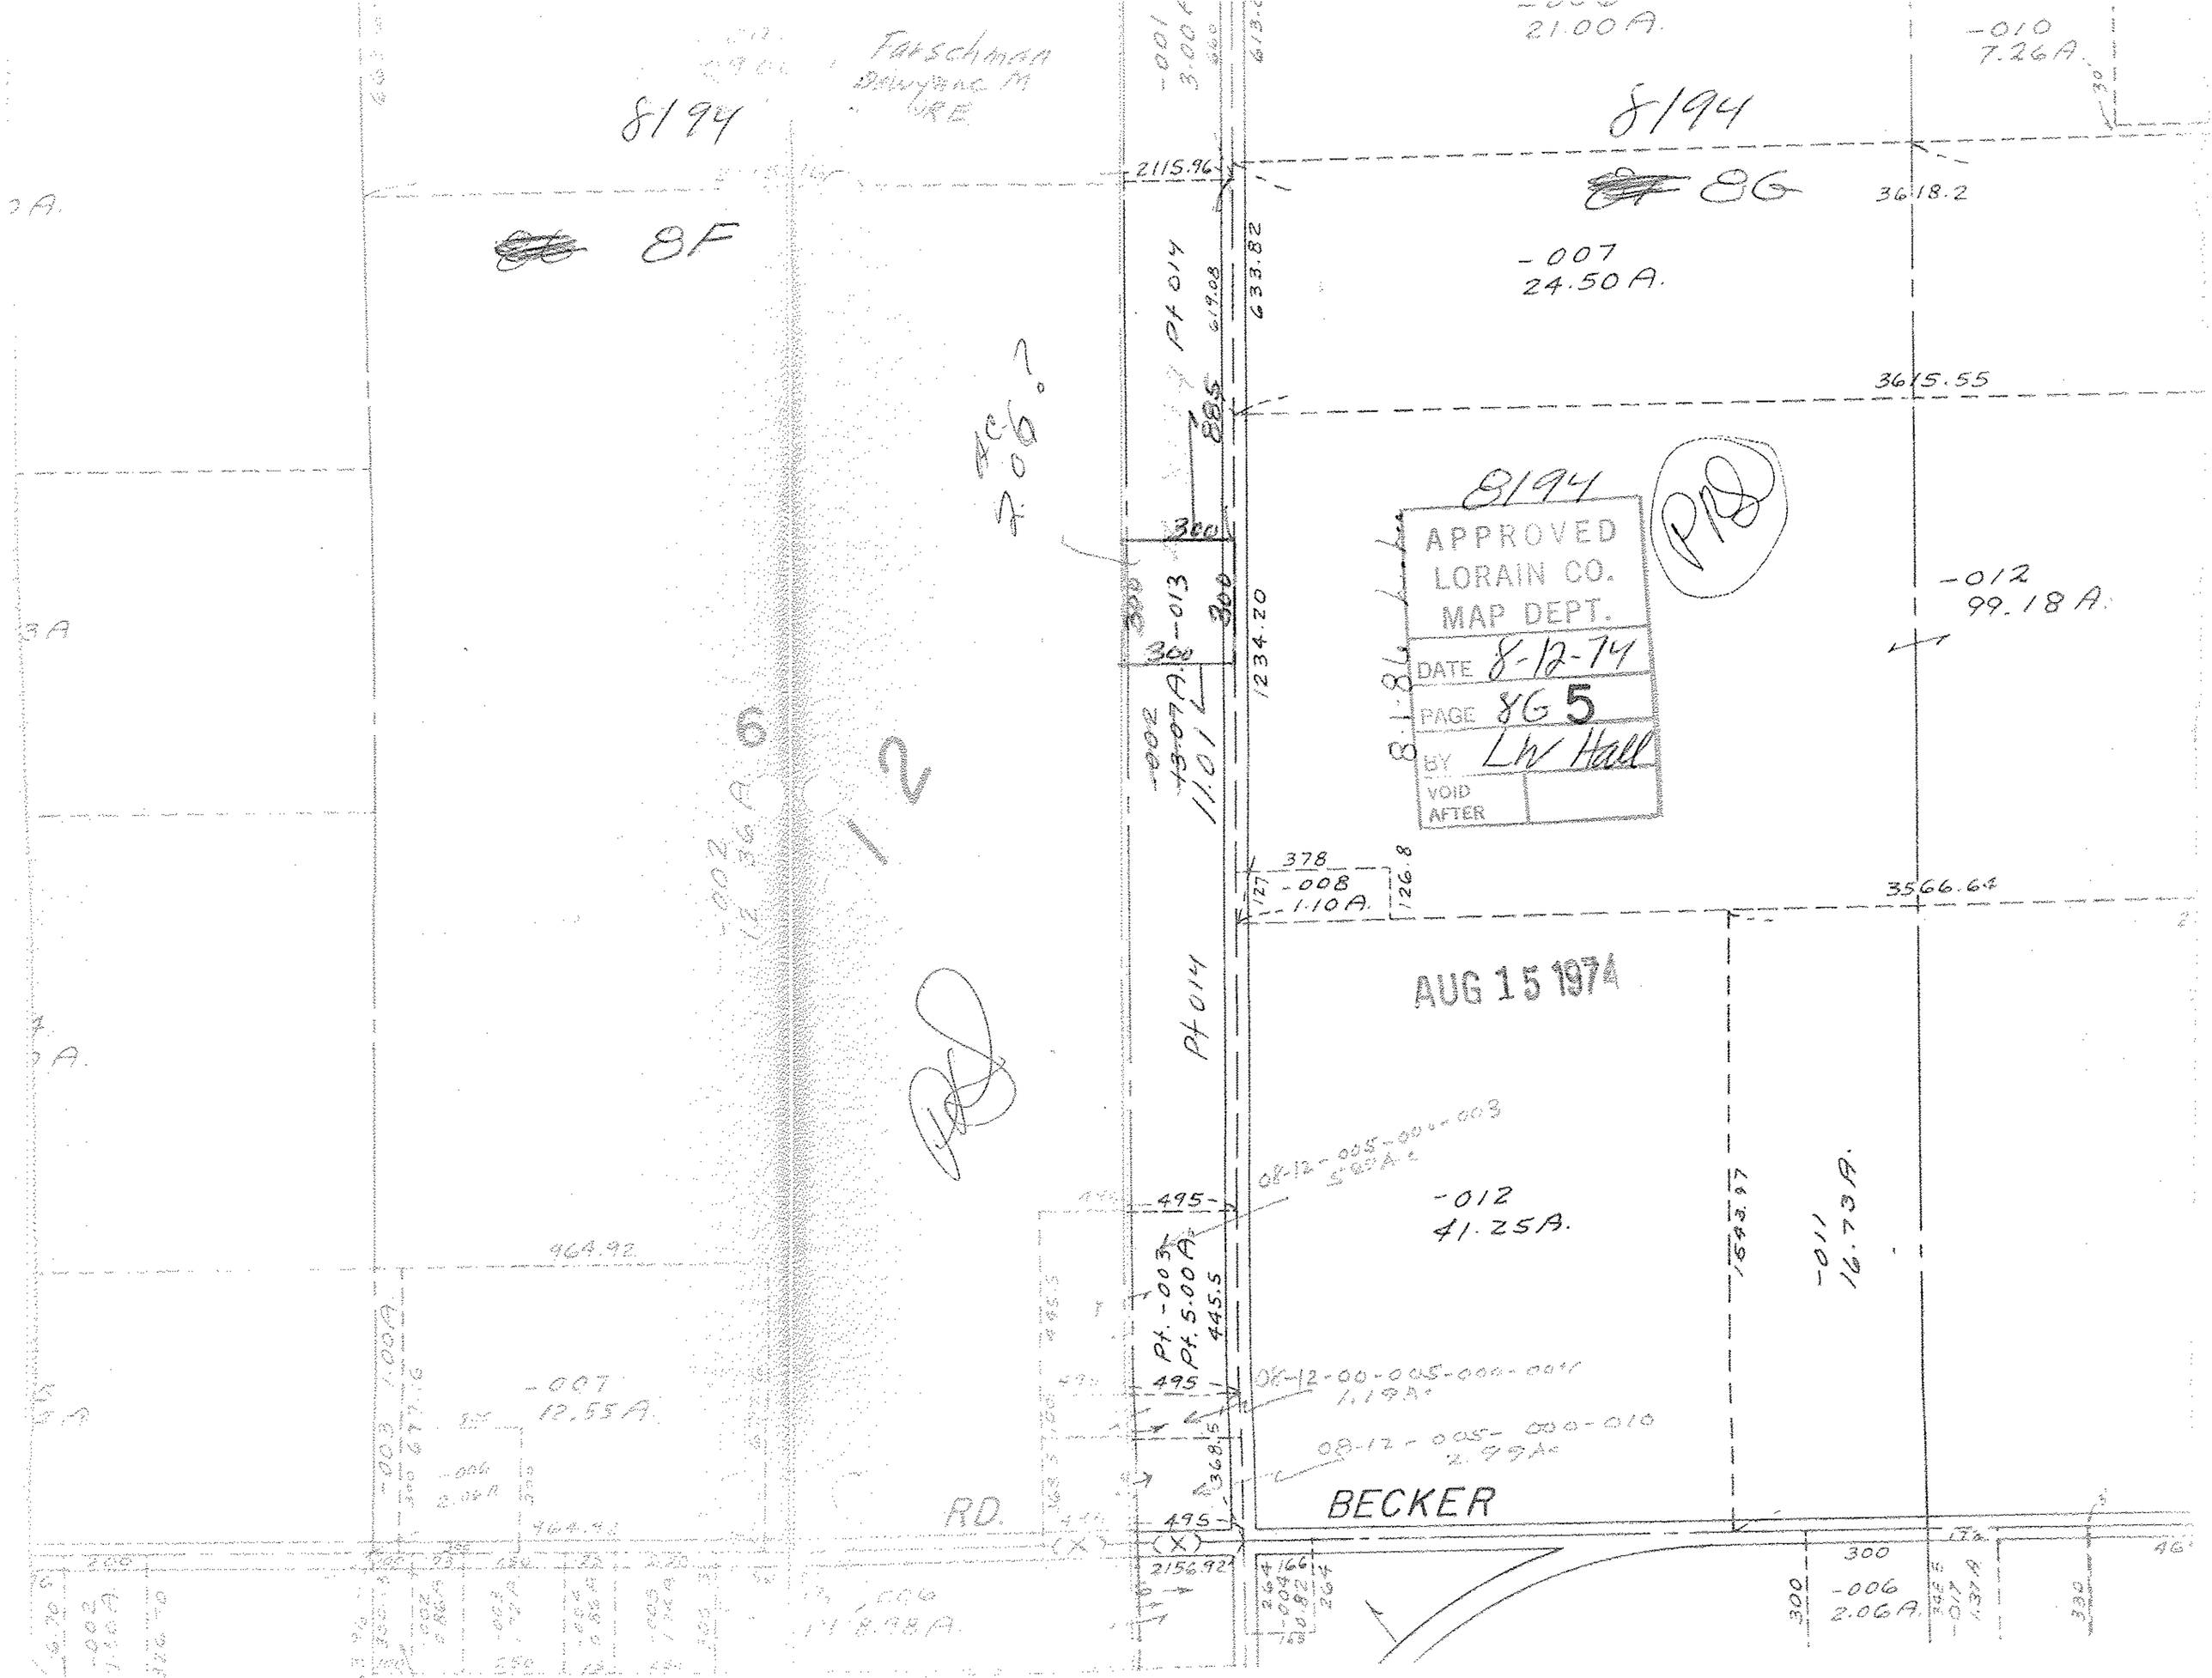

8194
8F
8G
8194
8194
Farschman
Dewyane M
-007
24.50 A.
-010
7.26 A.
21.00 A.
3618.2
3615.55
2115.96
633.82
619.08
885
300
-013
1234.20
-012
99.18 A.
-002
11.01
378
-008
1.10 A.
126.8
3566.64
Pt 014
-012
41.25 A.
-011
16.73 A.
1543.97
495
Pt. -003
Pt. 5.00 A.
445.5
08-12-005-000-003
08-12-00-005-000-004
1.19 A.
08-12-005-000-010
2.99 A.
368.5
BECKER
RD.
2156.92
-006
2.06 A.
-007
12.55 A.
964.92
-002
12.36 A.
6
12
APPROVED
LORAIN CO.
MAP DEPT.
DATE 8-12-74
PAGE 8G 5
BY LW Hall
VOID AFTER
AUG 15 1974