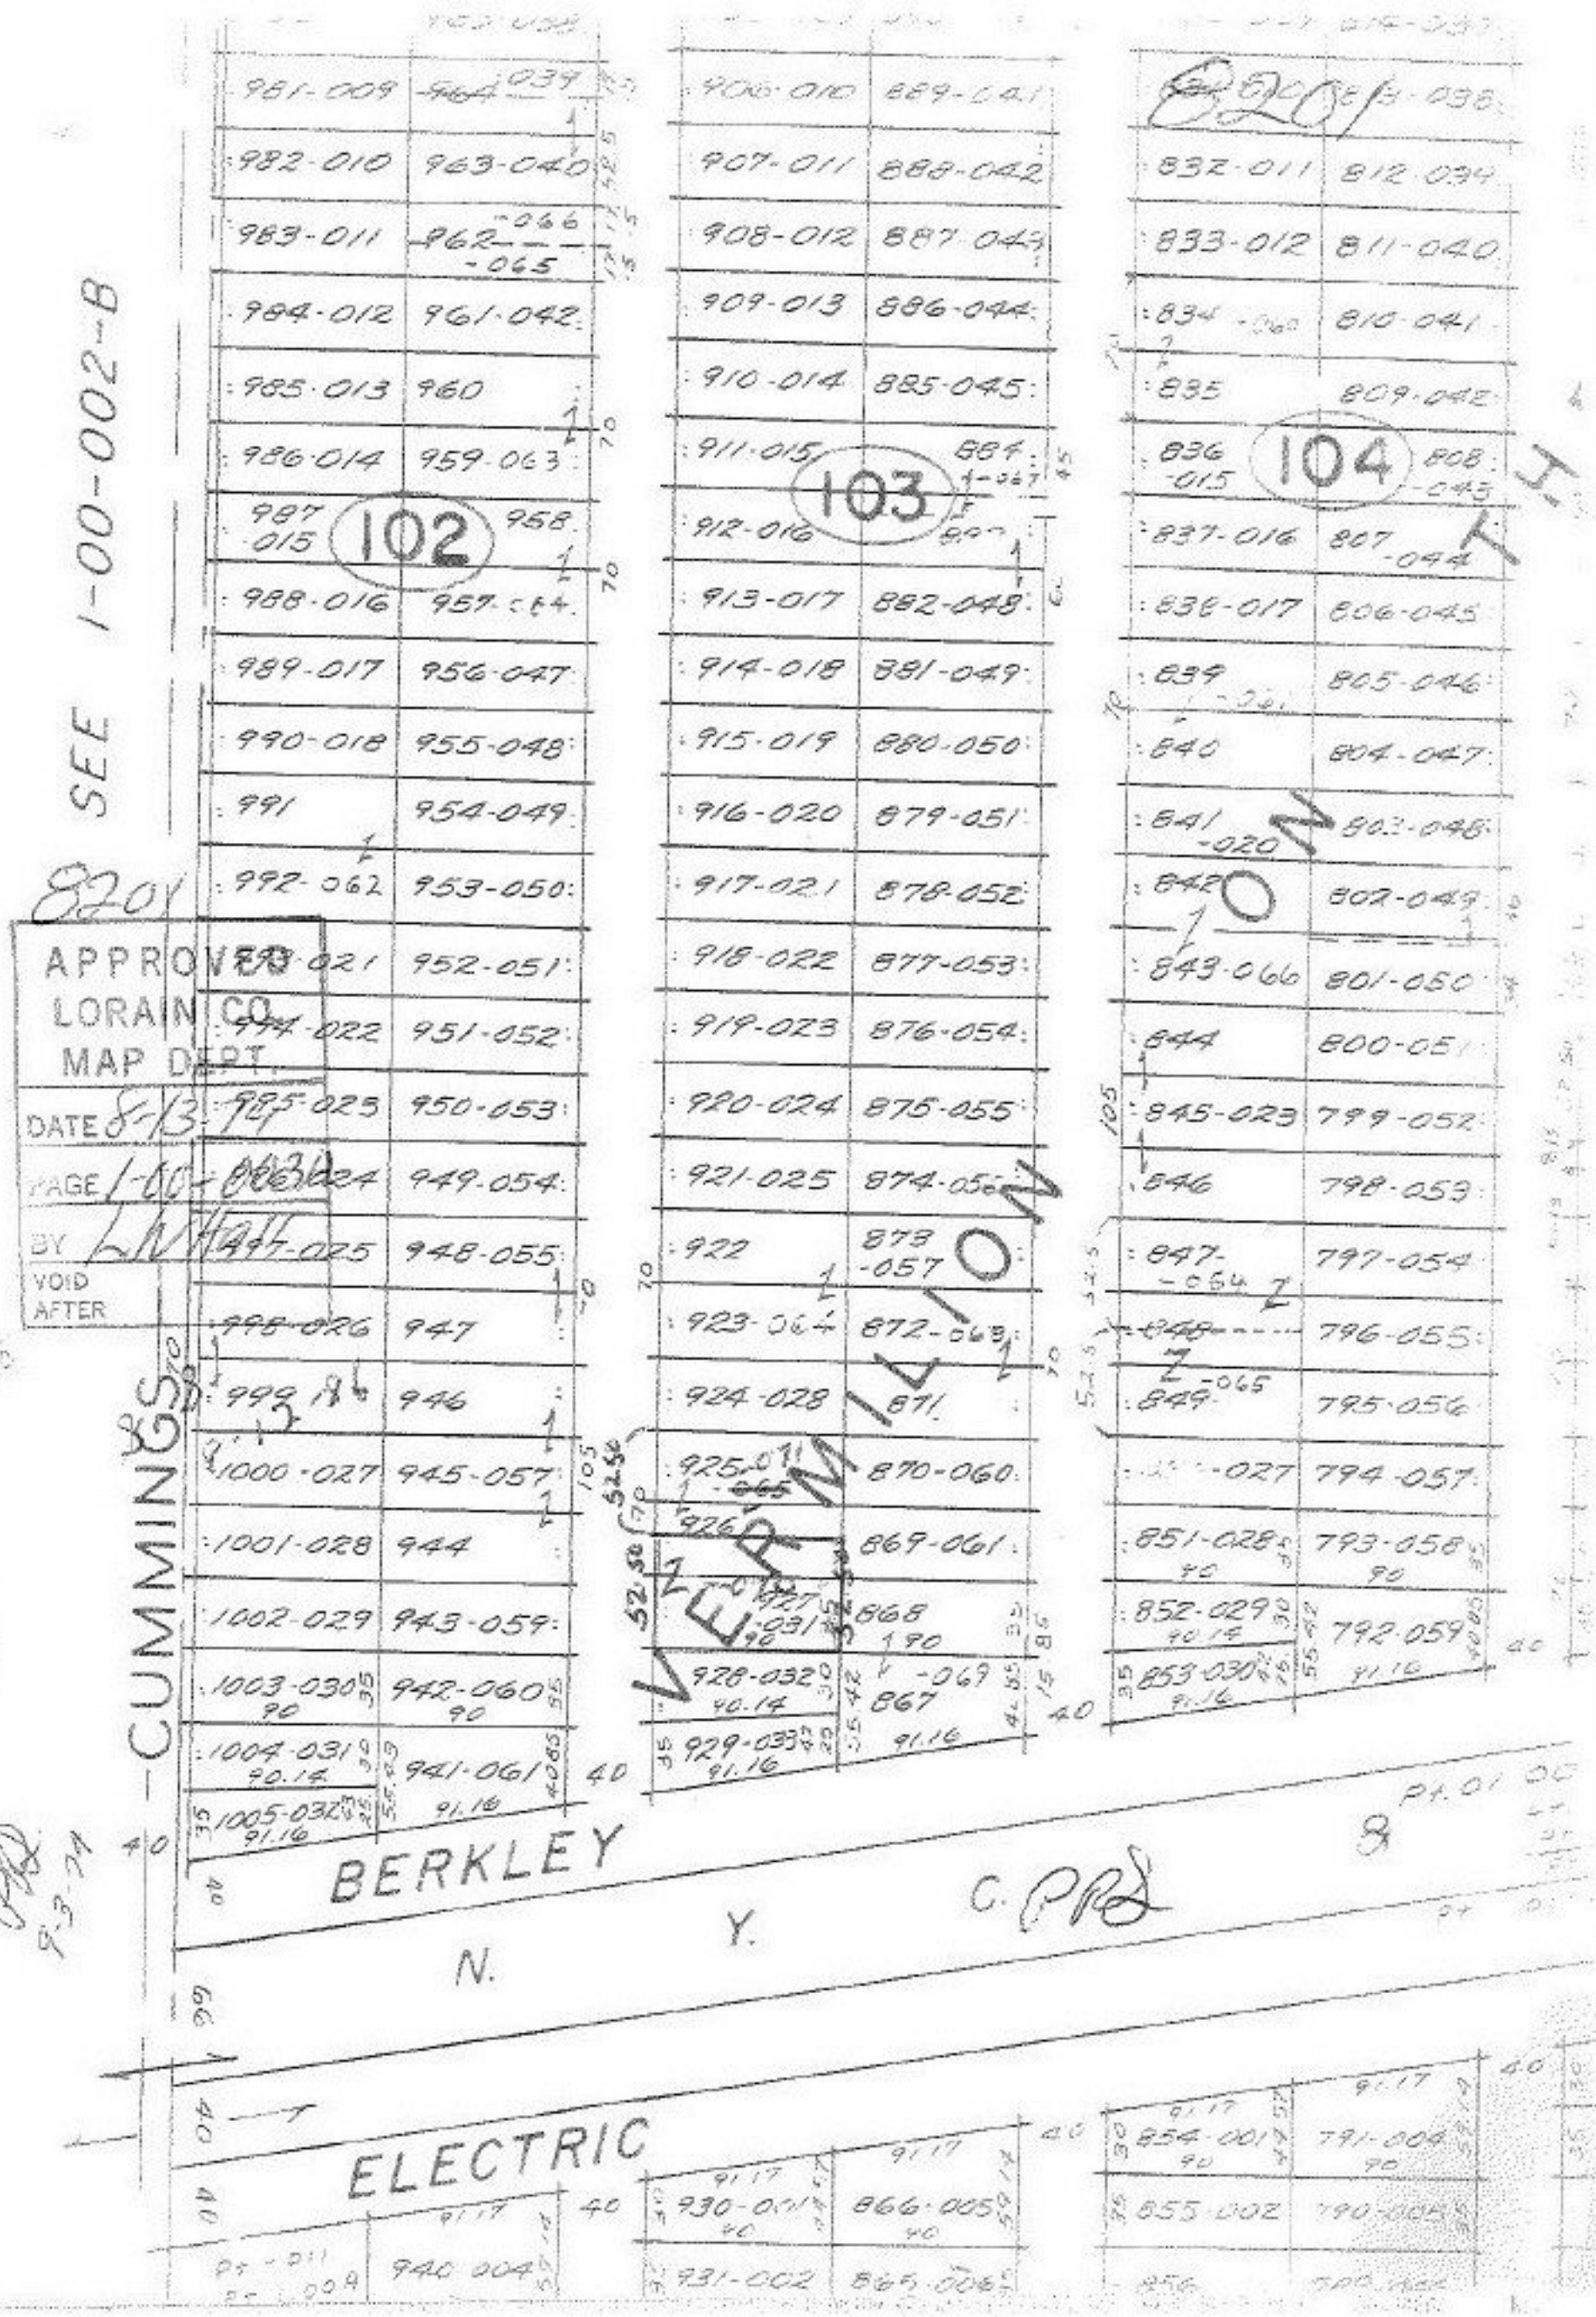

SEE 1-00-002-B
8201
APPROVED
LORAIN CO.
MAP DEPT.
DATE 8-13-74
PAGE 1-00-003
BY LWHall
VOID AFTER
CUMMINGS
VERMILION
BERKLEY
N. Y. C.
ELECTRIC
102
103
104
981-009
982-010
983-011
984-012
985-013
986-014
987-015
988-016
989-017
990-018
991
992-062
993-021
994-022
995-023
996-024
997-025
998-026
999-1
1000-027
1001-028
1002-029
1003-030
1004-031
1005-032
964-039
963-040
962-066
-065
961-042
960
959-063
958
957-064
956-047
955-048
954-049
953-050
952-051
951-052
950-053
949-054
948-055
947
946
945-057
944
943-059
942-060
941-061
906-010
907-011
908-012
909-013
910-014
911-015
912-016
913-017
914-018
915-019
916-020
917-021
918-022
919-023
920-024
921-025
922
923-064
924-028
925-071
926
927-031
928-032
929-033
889-041
888-042
887-043
886-044
885-045
884-067
882-048
881-049
880-050
879-051
878-052
877-053
876-054
875-055
874-056
873-057
872-063
871
870-060
869-061
868
867-069
832-011
833-012
834-060
835
836-015
837-016
838-017
839-061
840
841-020
842
843-066
844
845-023
846
847-064
848
849-065
851-028
852-029
853-030
854-001
855-002
856
812-039
811-040
810-041
809-042
808-043
807-044
806-045
805-046
804-047
803-048
802-049
801-050
800-051
799-052
798-053
797-054
796-055
795-056
794-057
793-058
792-059
791-004
790-005
940-004
930-001
931-002
866-005
865-006