8202

022
~~Pt 020~~
~~Pt 36.59A.~~
35.87AC

102

8202

APPROVED
LORAIN CO.
MAP DEPT.
DATE 8-13-74
PAGE 2-02-001B
BY L.H. Hall
VOID AFTER
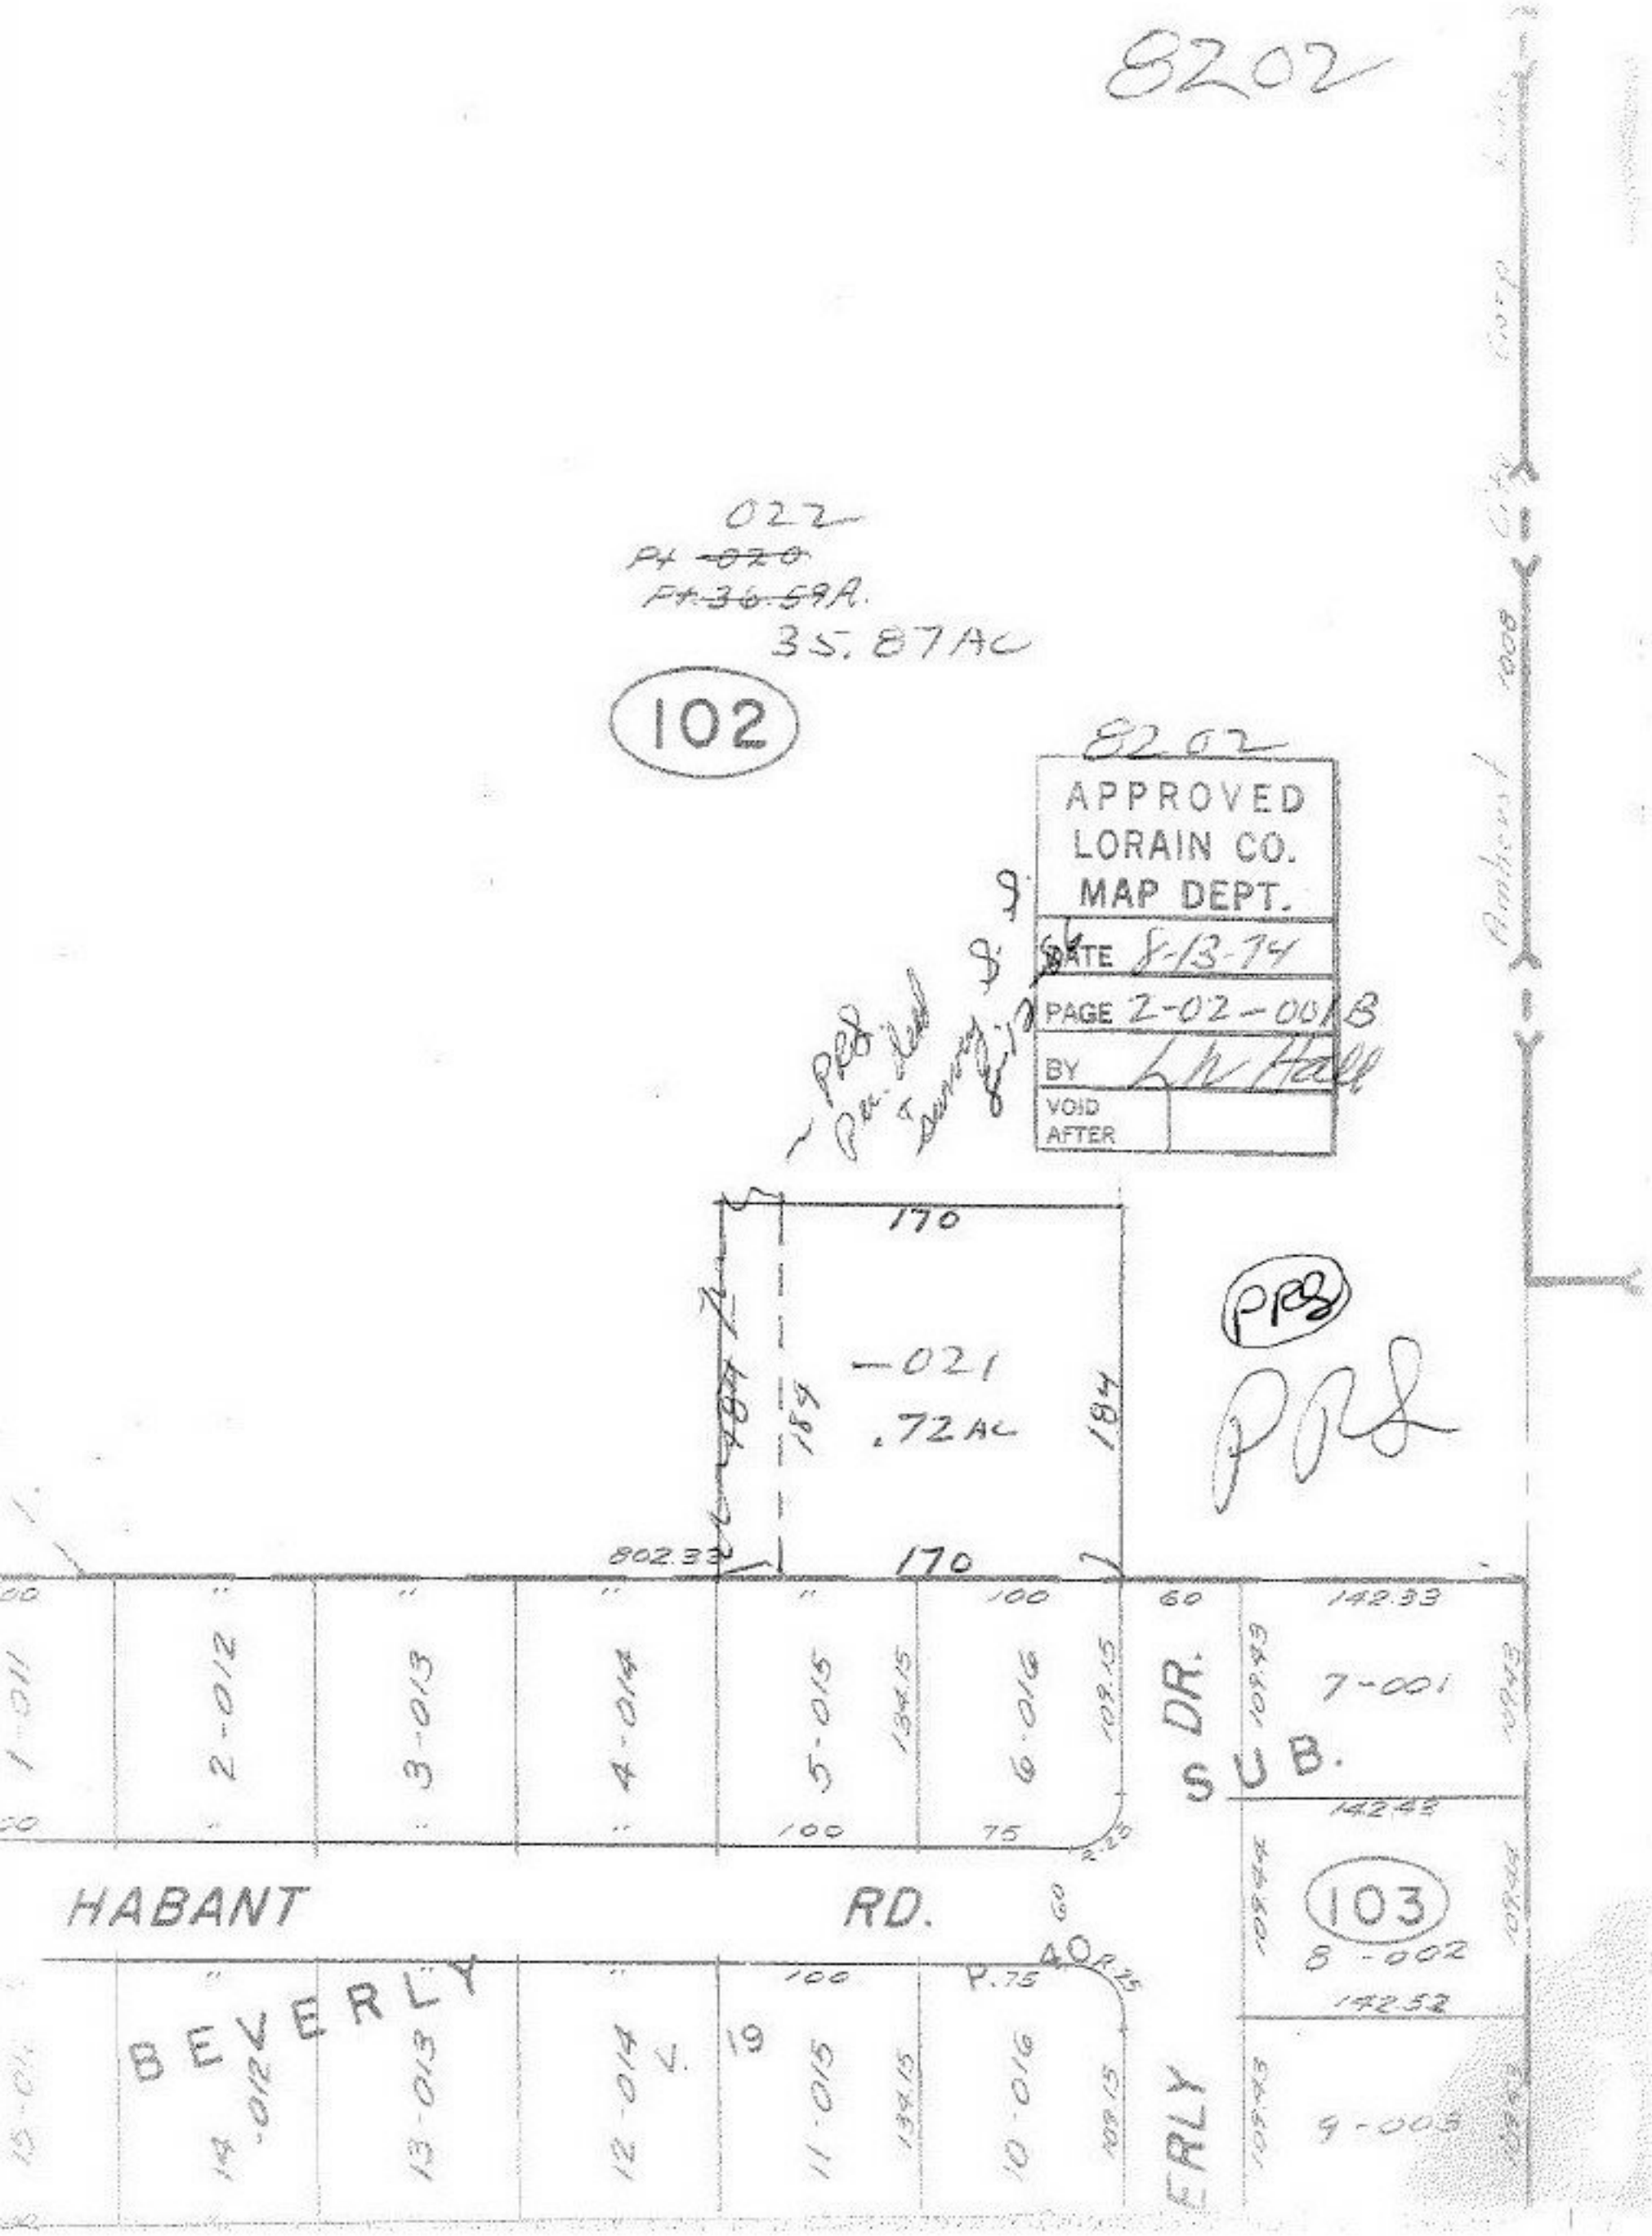
~ PRS
Per. Ded
Survey 8.9
8-12-66