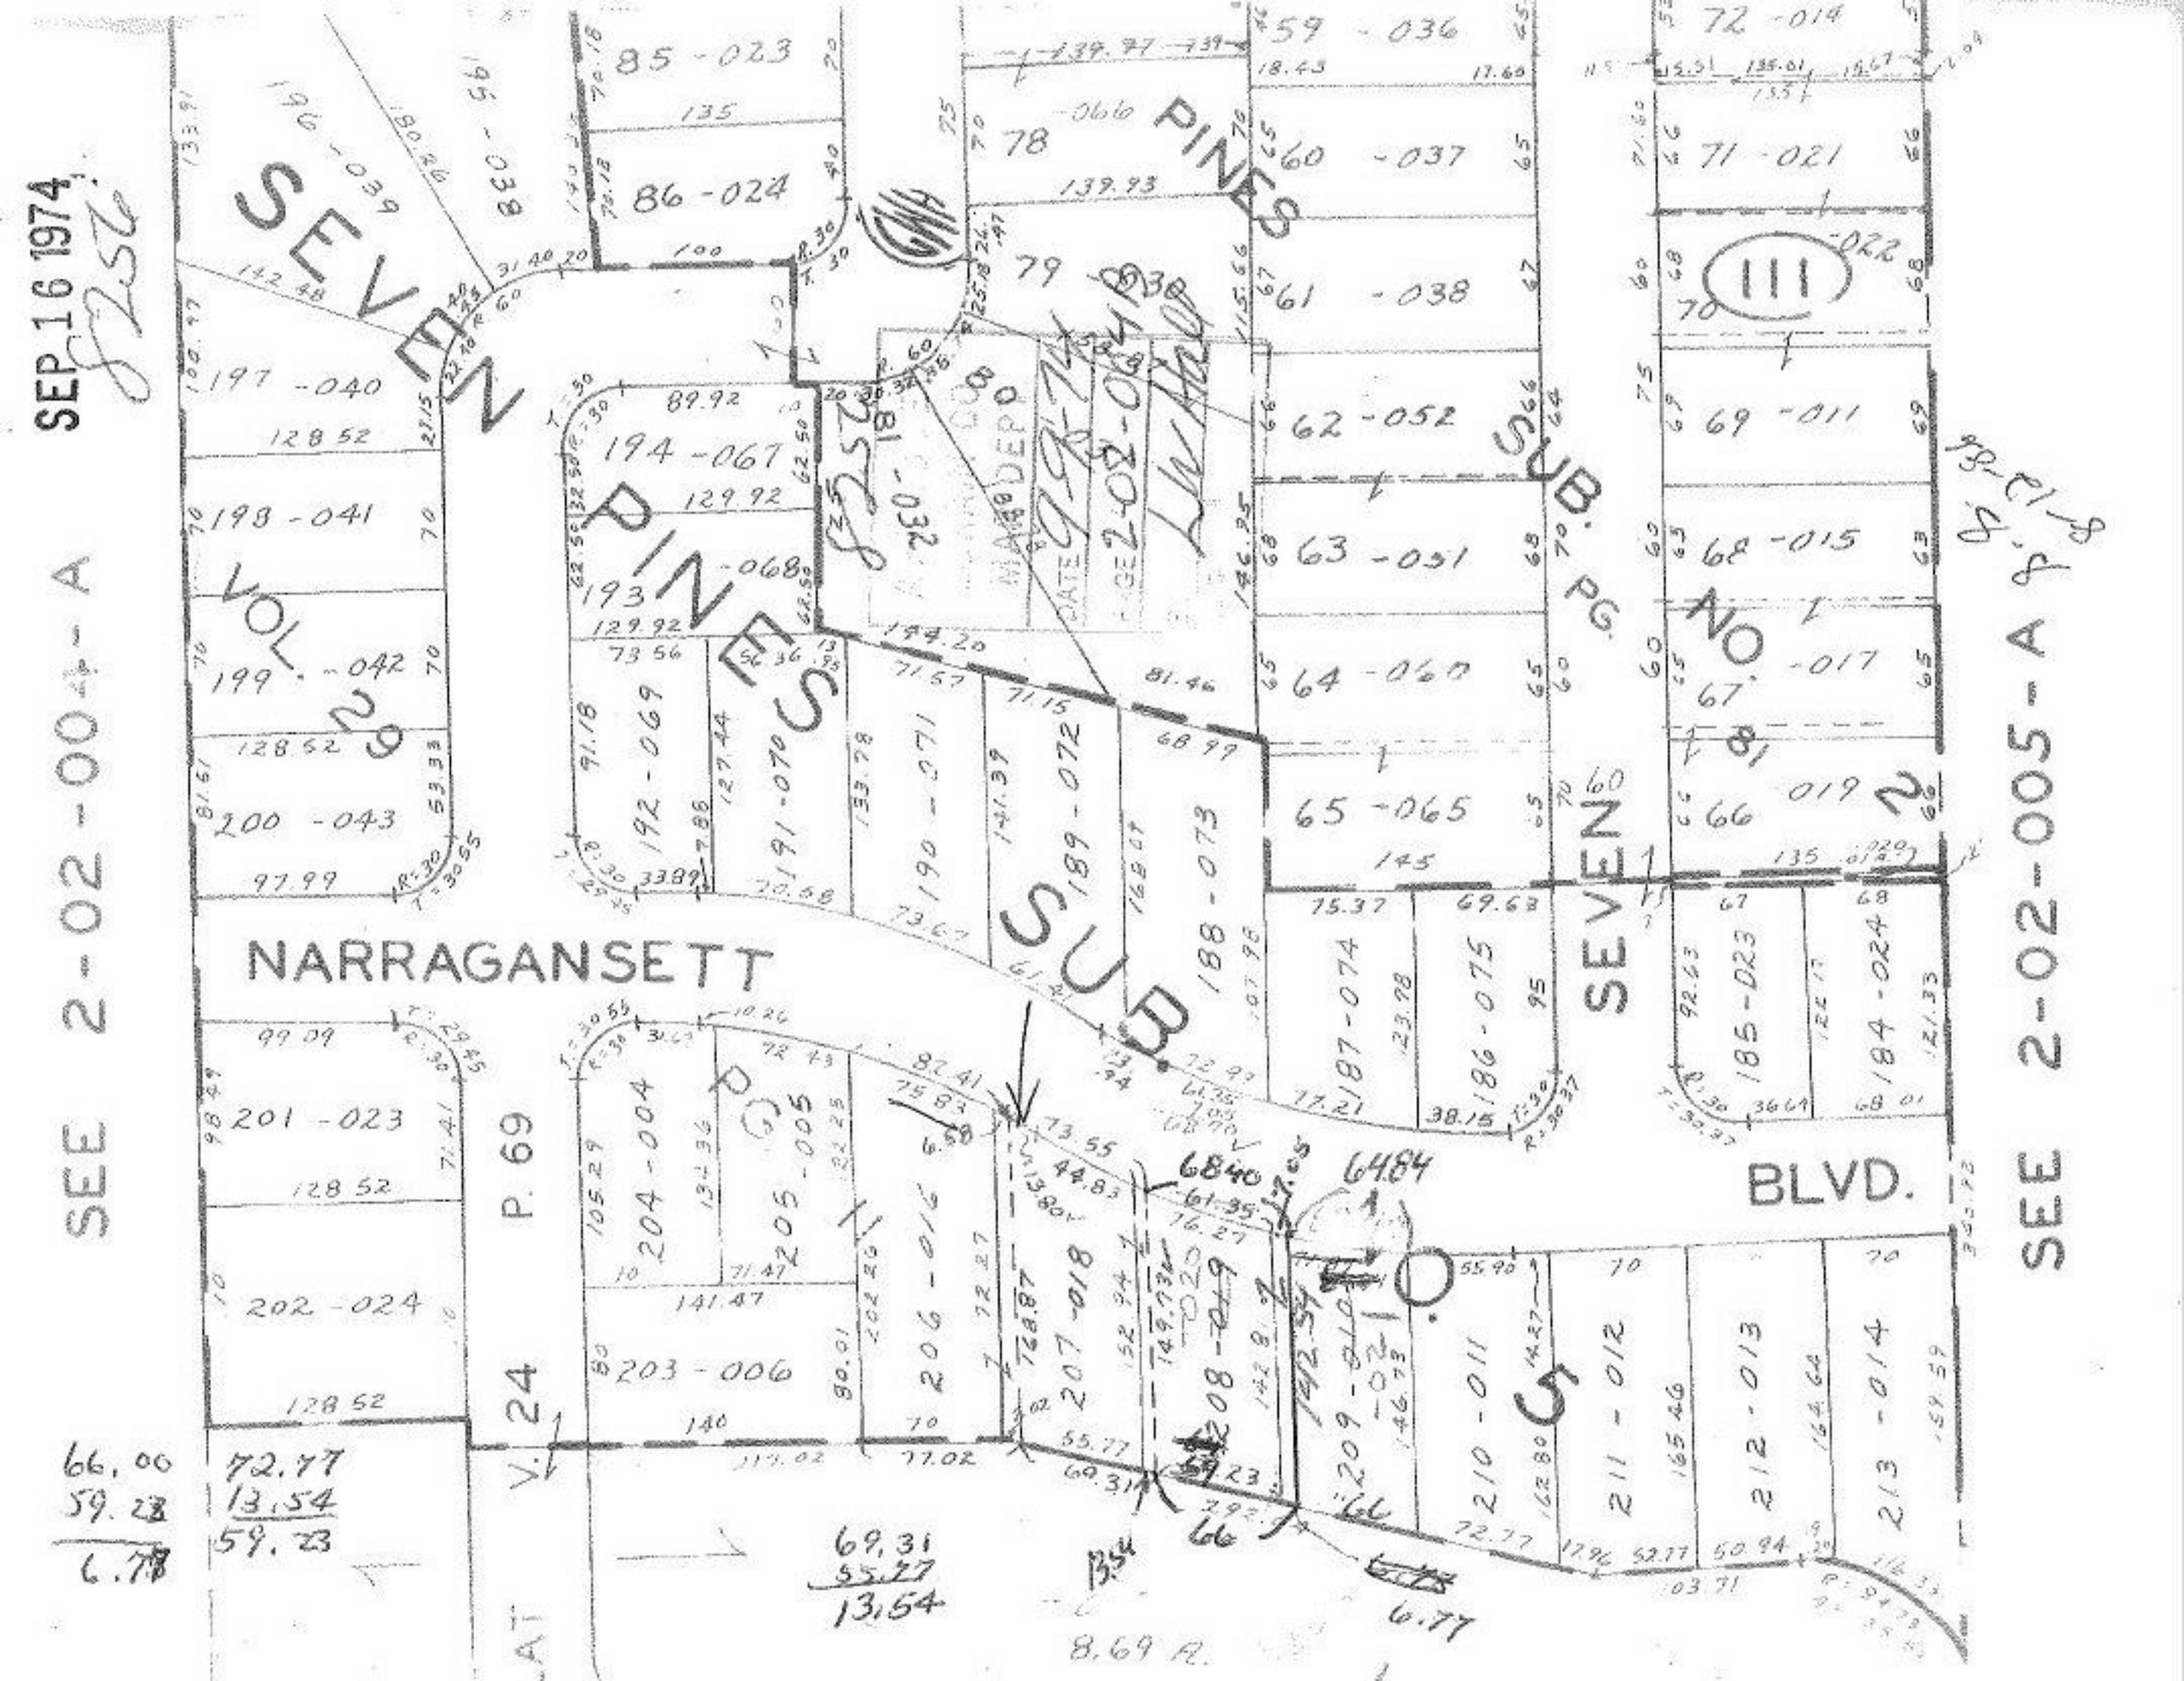
SEP 16 1974
8256
SEE 2-02-004-A
SEE 2-02-005-A
SEVEN PINES SUB. PG. NO. 81
SEVEN PINES SUB. PG. 80
NARRAGANSETT BLVD.
VOL. 29
P. 69
V. 24
111
85-023
86-024
78-066
79-030
81-032
59-036
60-037
61-038
62-052
63-051
64-060
65-065
72-014
71-021
69-011
68-015
67-017
66-019
197-040
198-041
199-042
200-043
201-023
202-024
203-006
194-067
193-068
192-069
191-070
190-071
189-072
188-073
187-074
186-075
185-023
184-024
204-004
205-005
206-016
207-018
208-019
209-010
210-011
211-012
212-013
213-014
66.00
59.23
6.77
72.77
13.54
59.23
69.31
55.77
13.54
8.69 A.