8270

APPROVED
LORAIN CO.
MAP DEPT.

DATE 9-16-74

PAGE 5-00-025 B

BY [signature]

VOID AFTER

8-1-861

SEE 5-00-024-B

See Survey

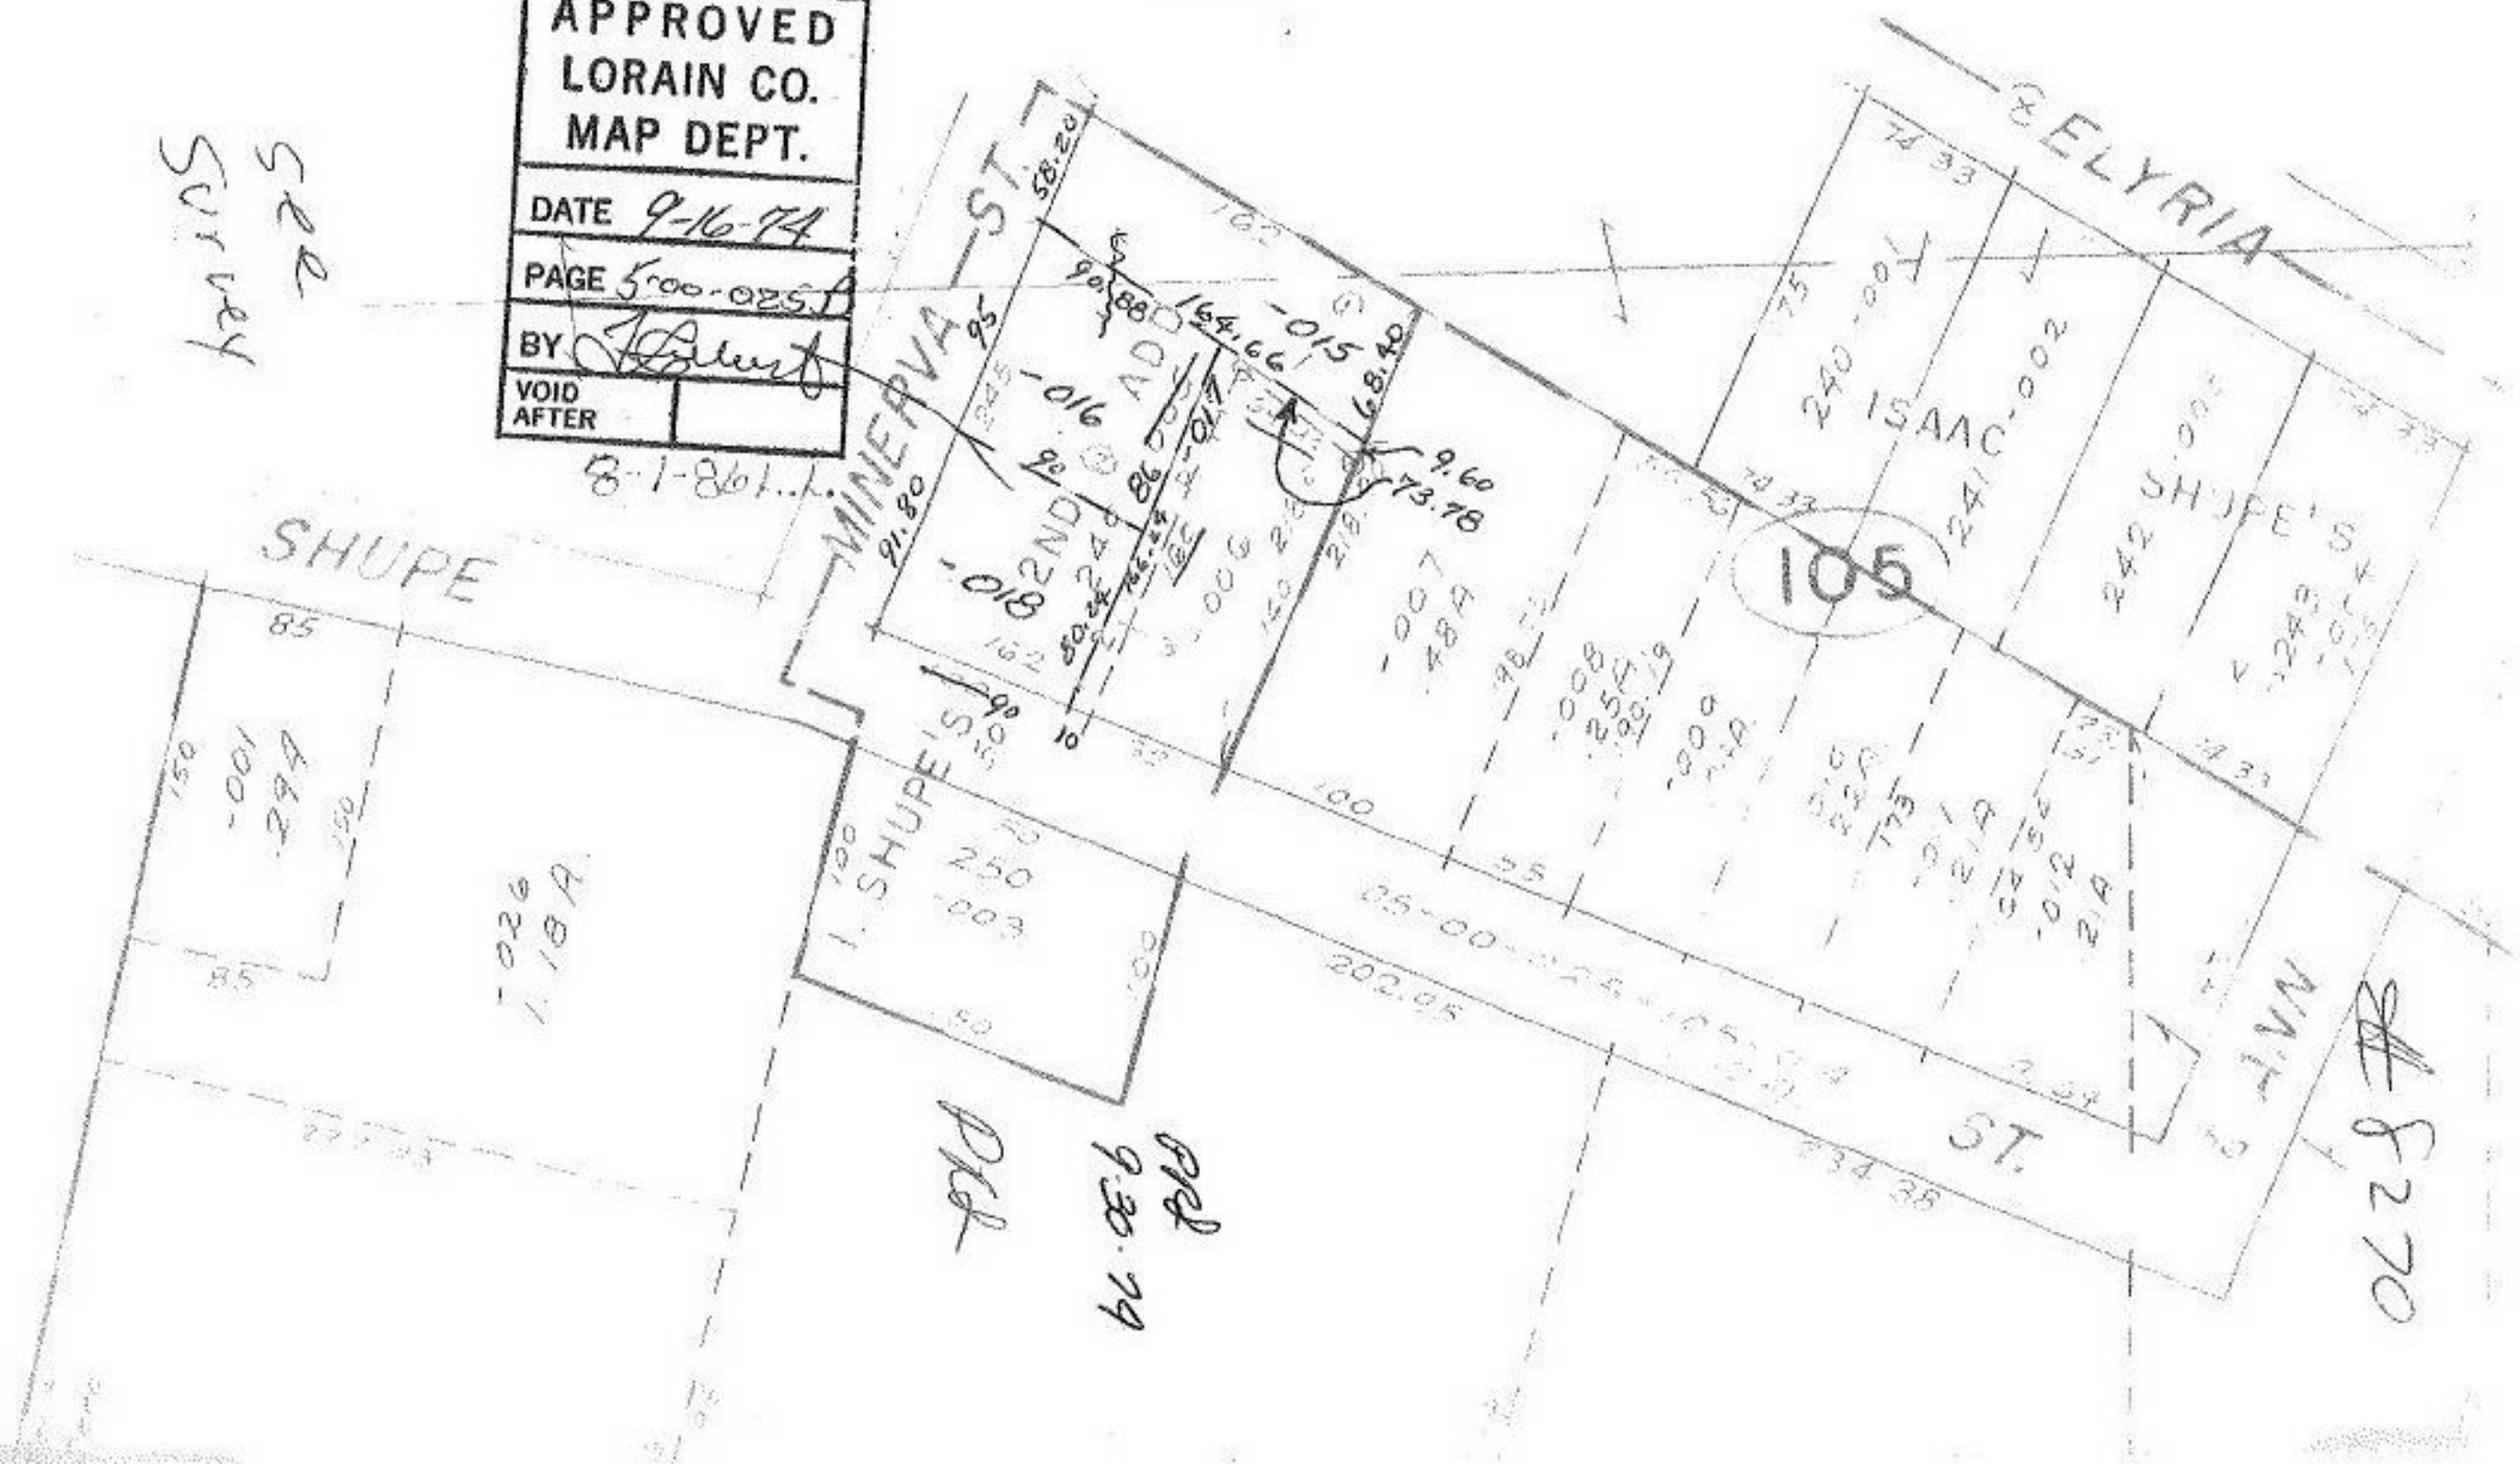

PRD 9.30.74

#8270