8281

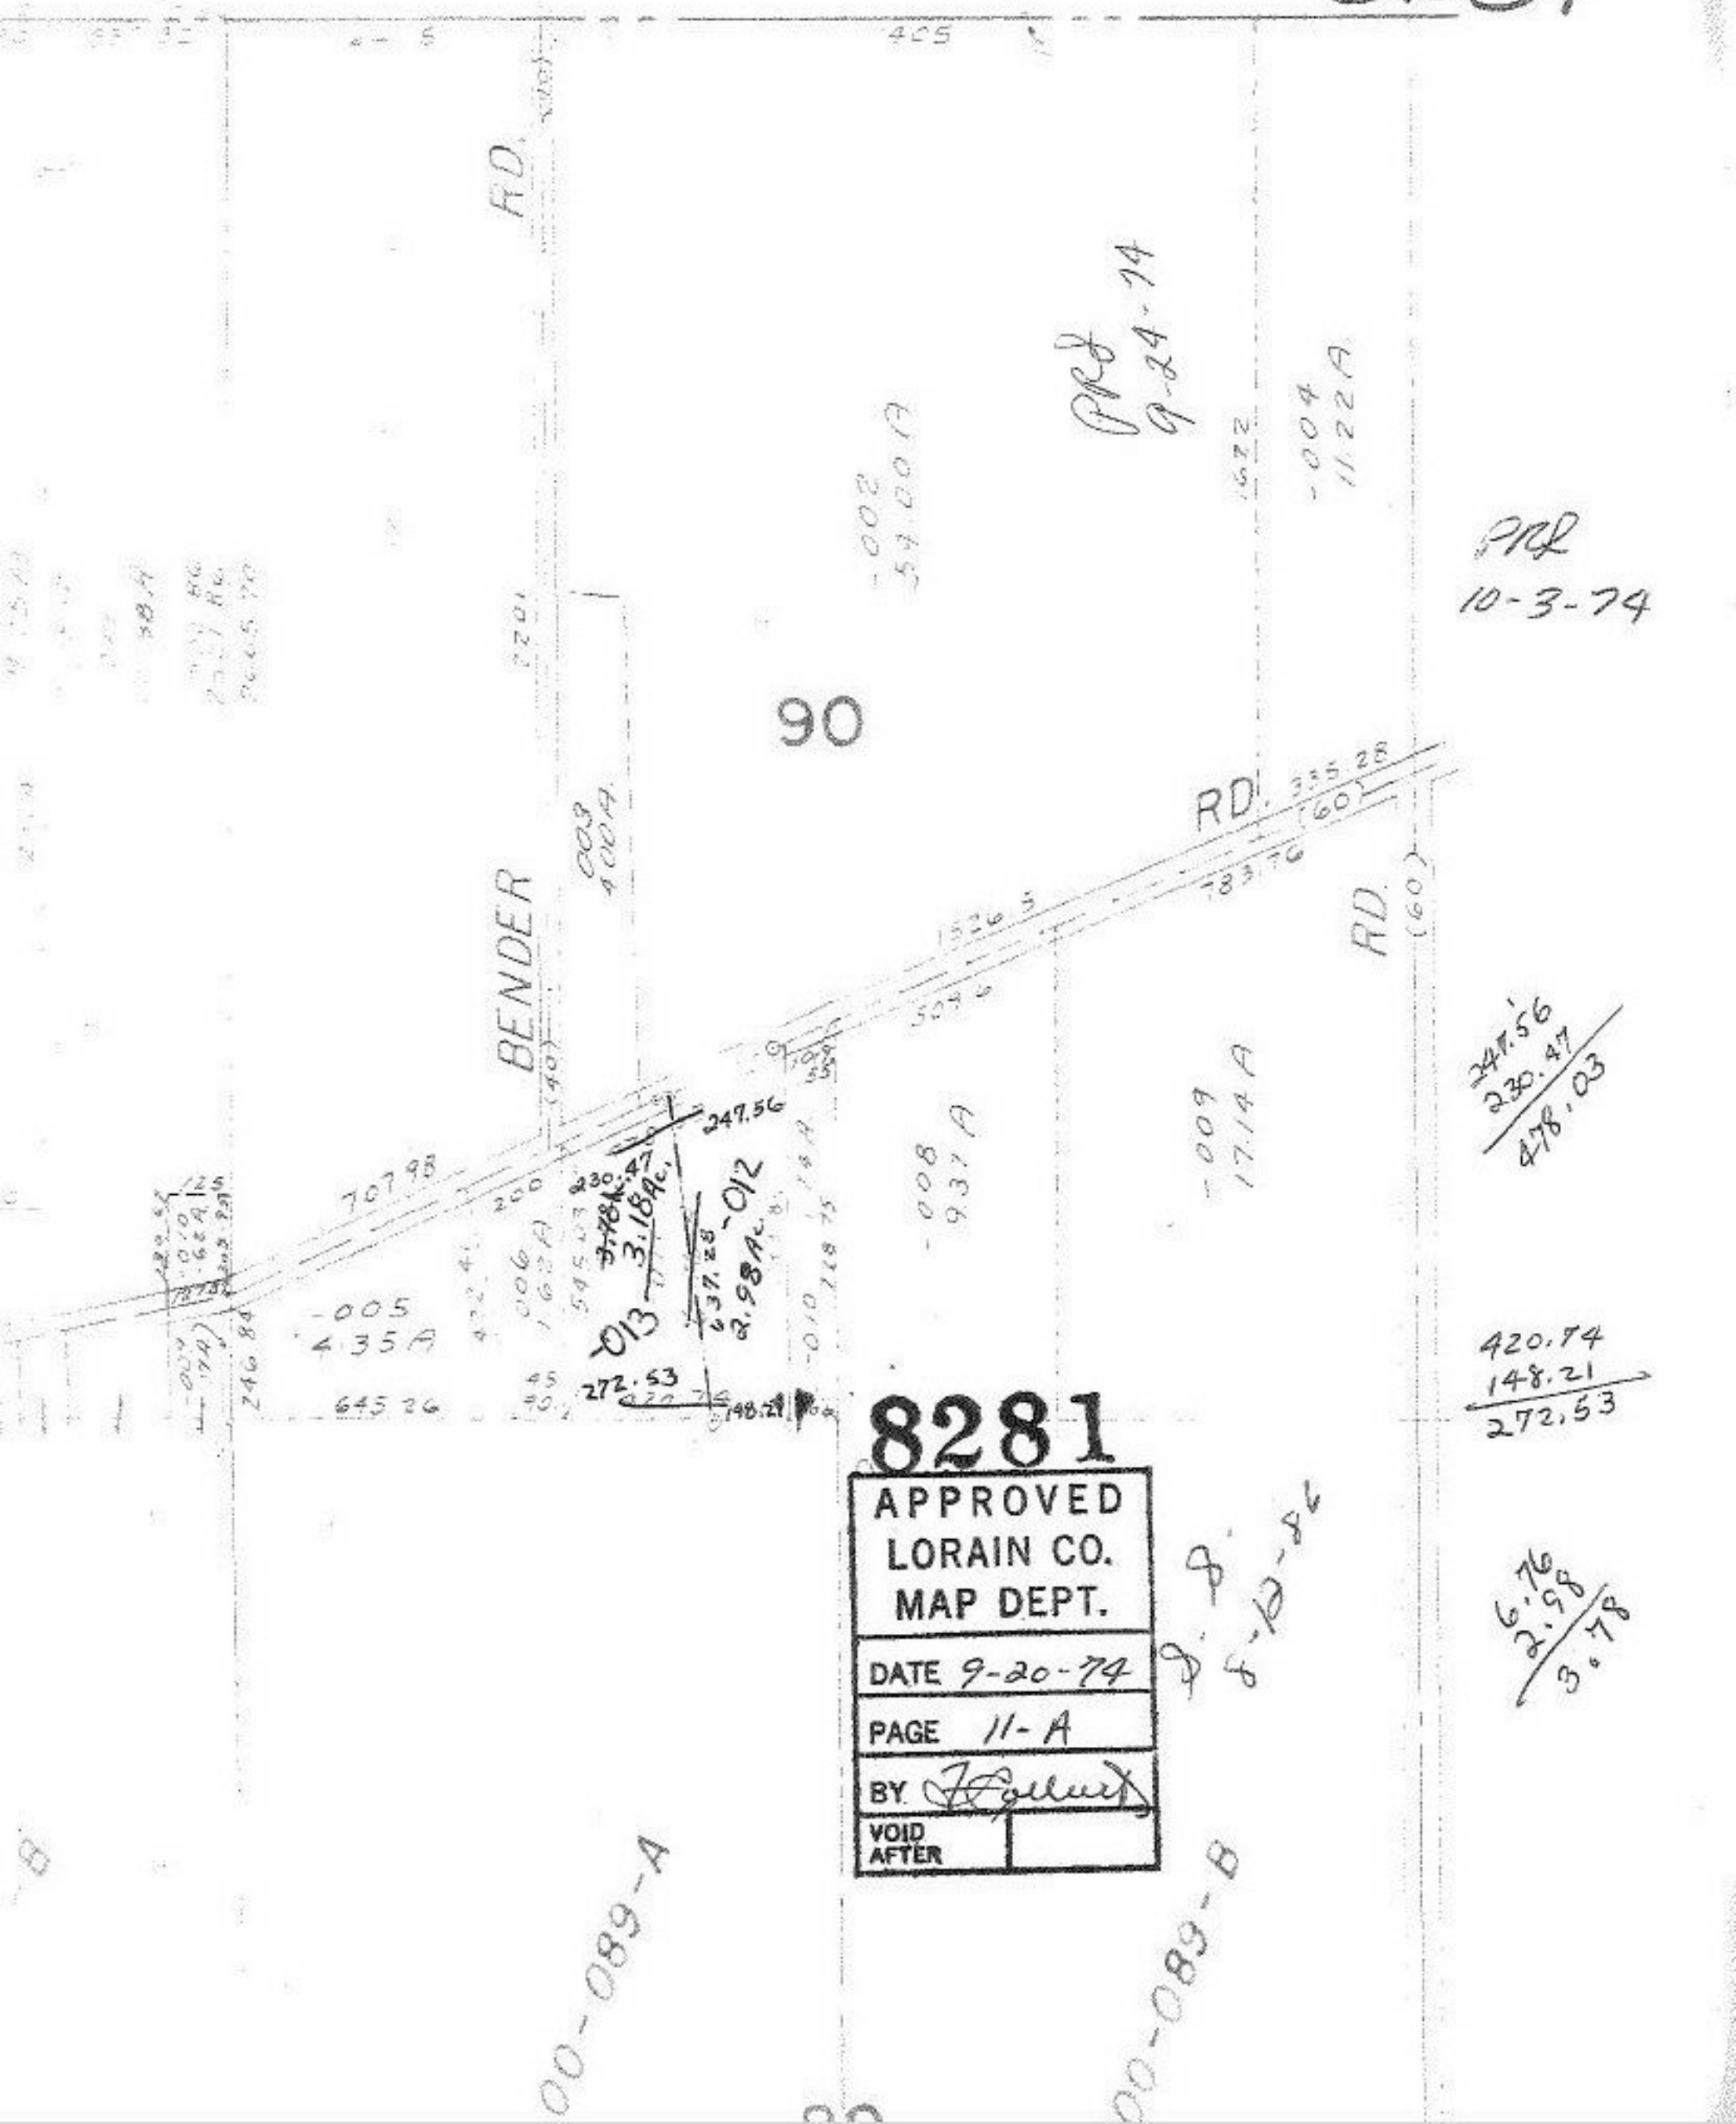

8281

APPROVED
LORAIN CO.
MAP DEPT.

DATE 9-20-74

PAGE 11-A

BY [signature]

VOID AFTER