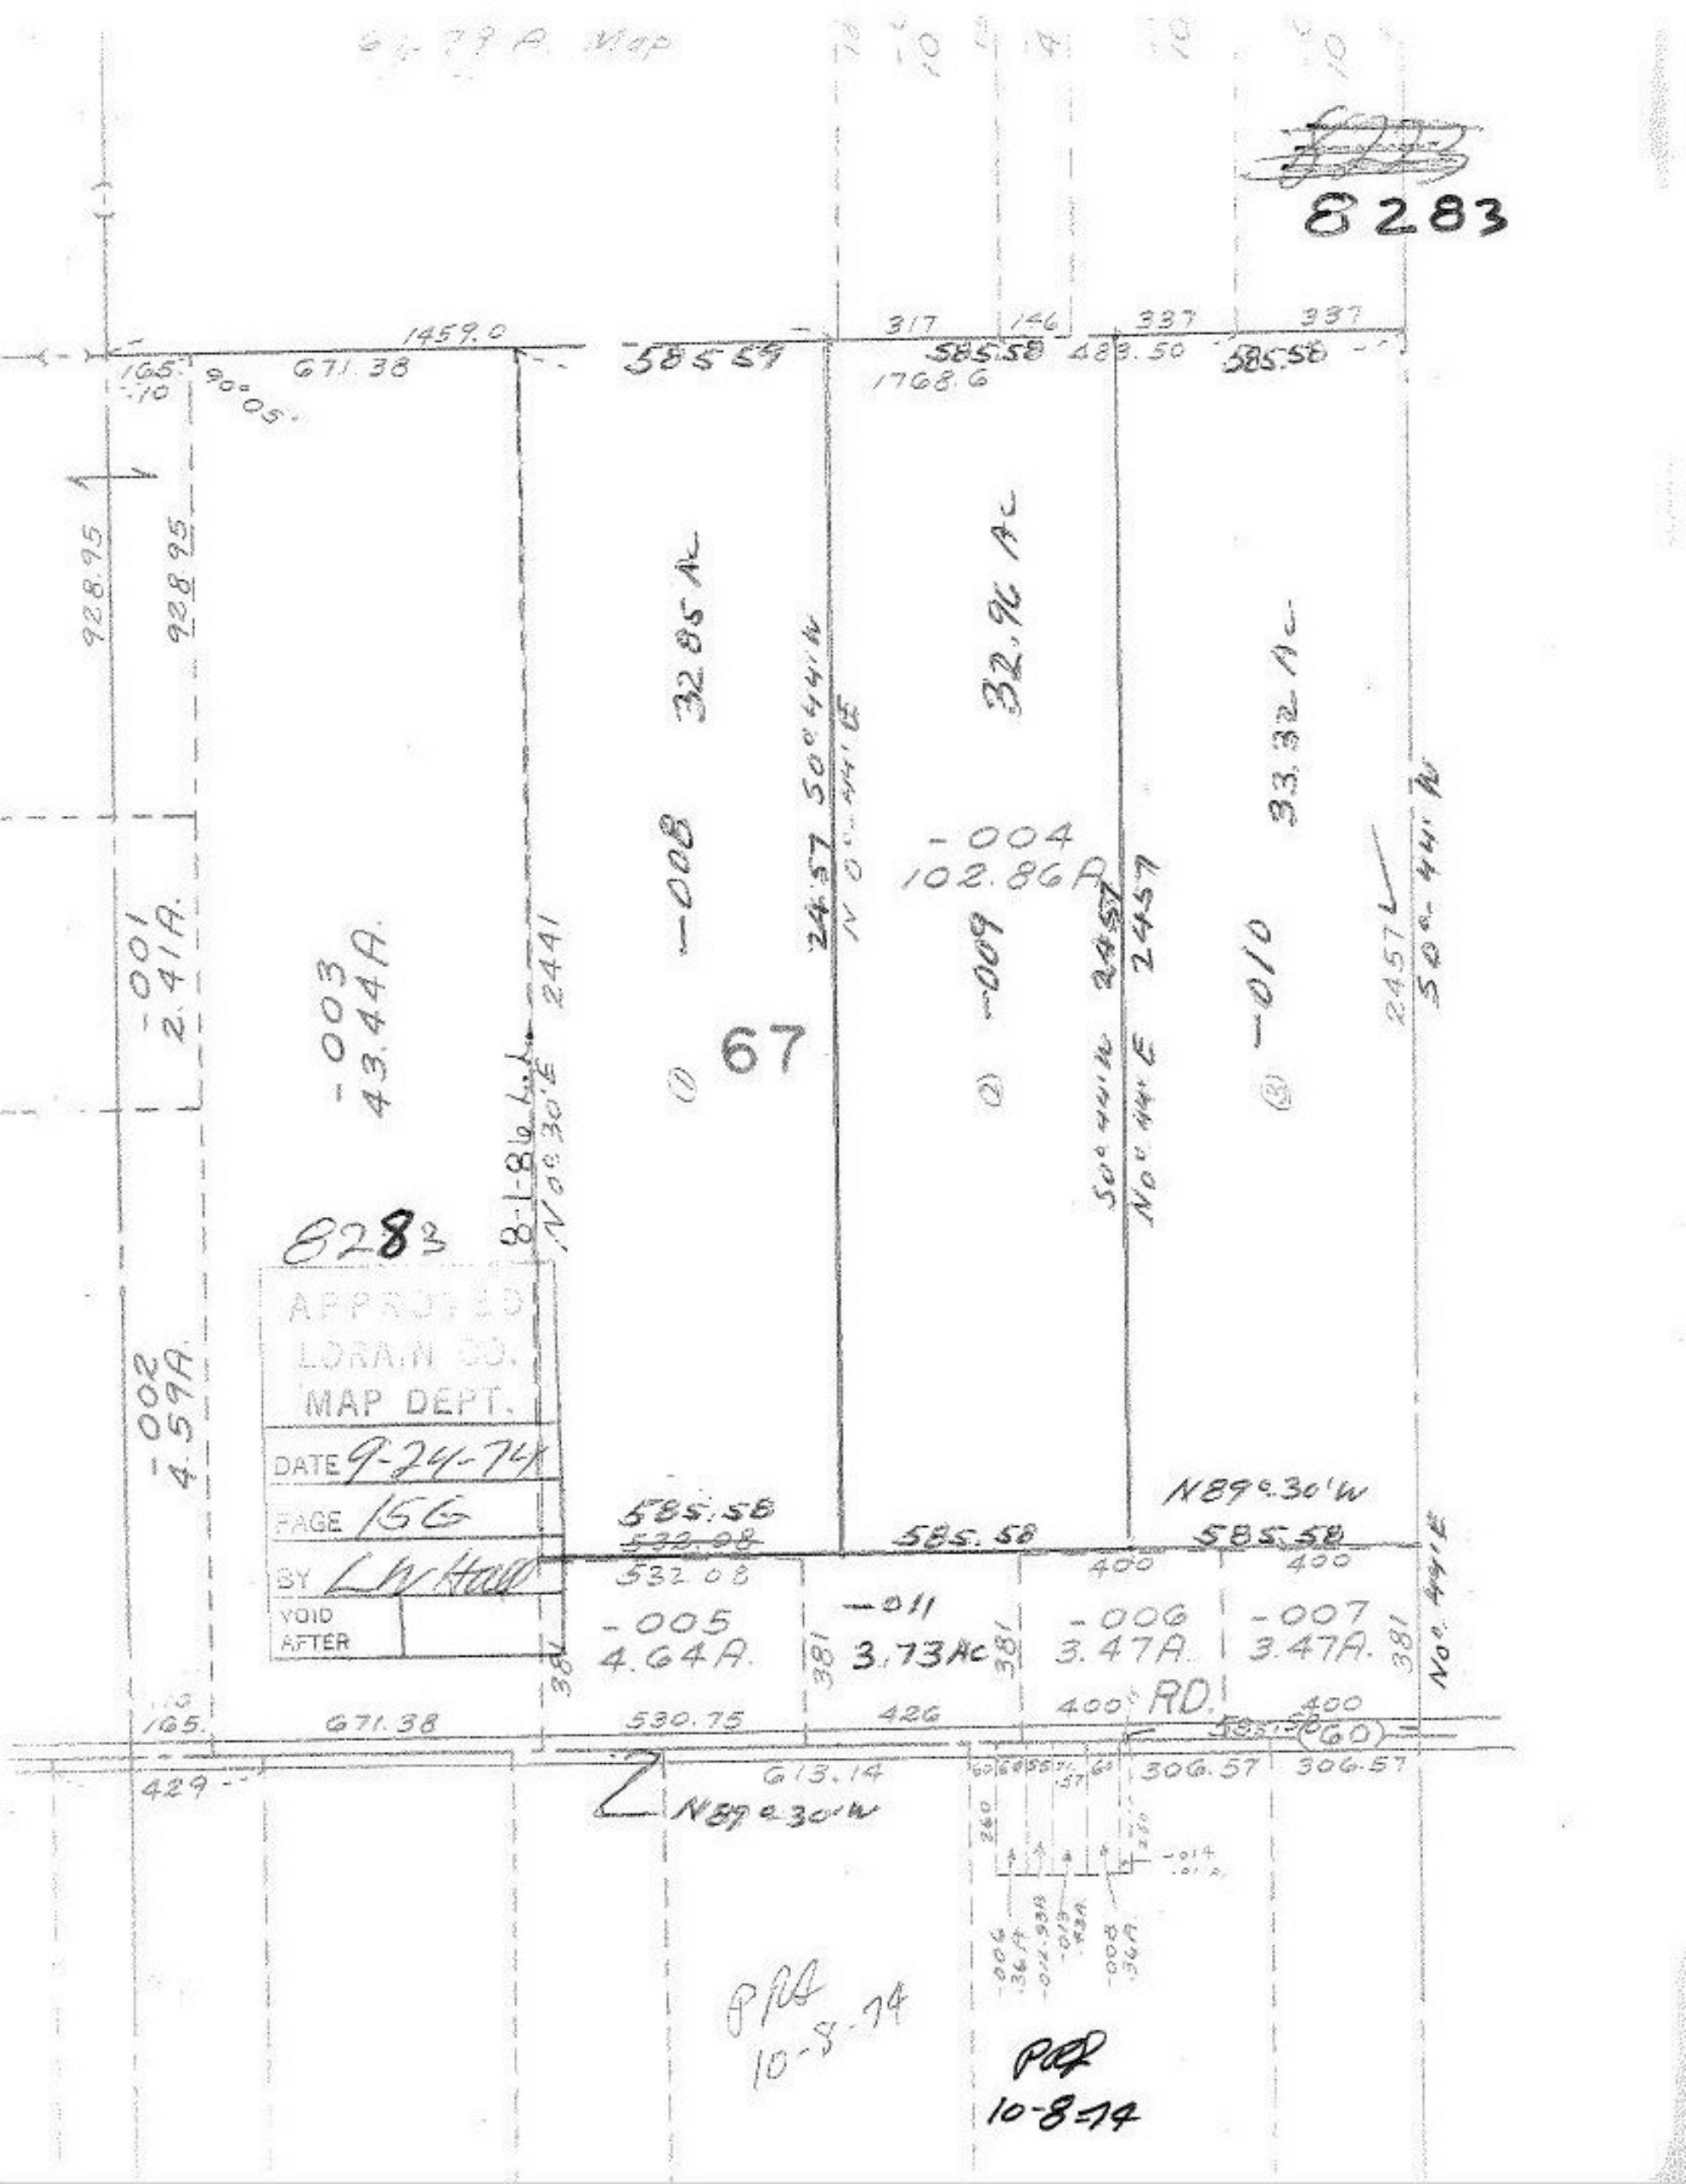

8283
1459.0
671.38
165.10
90°05'
585.59
317
146
585.58
1768.6
337
483.50
337
585.58
928.95
928.95
32.85 Ac
32.96 Ac
33.32 Ac
-008
-004
102.86A
-009
-010
-001
2.41A.
-003
43.44A.
-002
4.59A.
67
2441
8-1-86
N 0°30'E
2457
50°44'W
N 0°44'E
2457
50°44'W
N 0°44'E
2457
50°44'W
8283
APPROVED
LORAIN CO.
MAP DEPT.
DATE 9-24-74
PAGE 156
BY L.W. Hall
VOID AFTER
585.58
532.08
585.58
N89°30'W
585.58
532.08
400
400
-005
4.64A.
-011
3.73Ac
-006
3.47A.
-007
3.47A.
381
381
381
381
No. 44'E
165.
671.38
530.75
426
400
RD.
400
585.58
(60)
429
613.14
306.57
306.57
N89°30'W
260
260
-014
-006
.36A
-012.93A
-013
.43A
-008
.36A
PRA
10-8-74
PRA
10-8-74