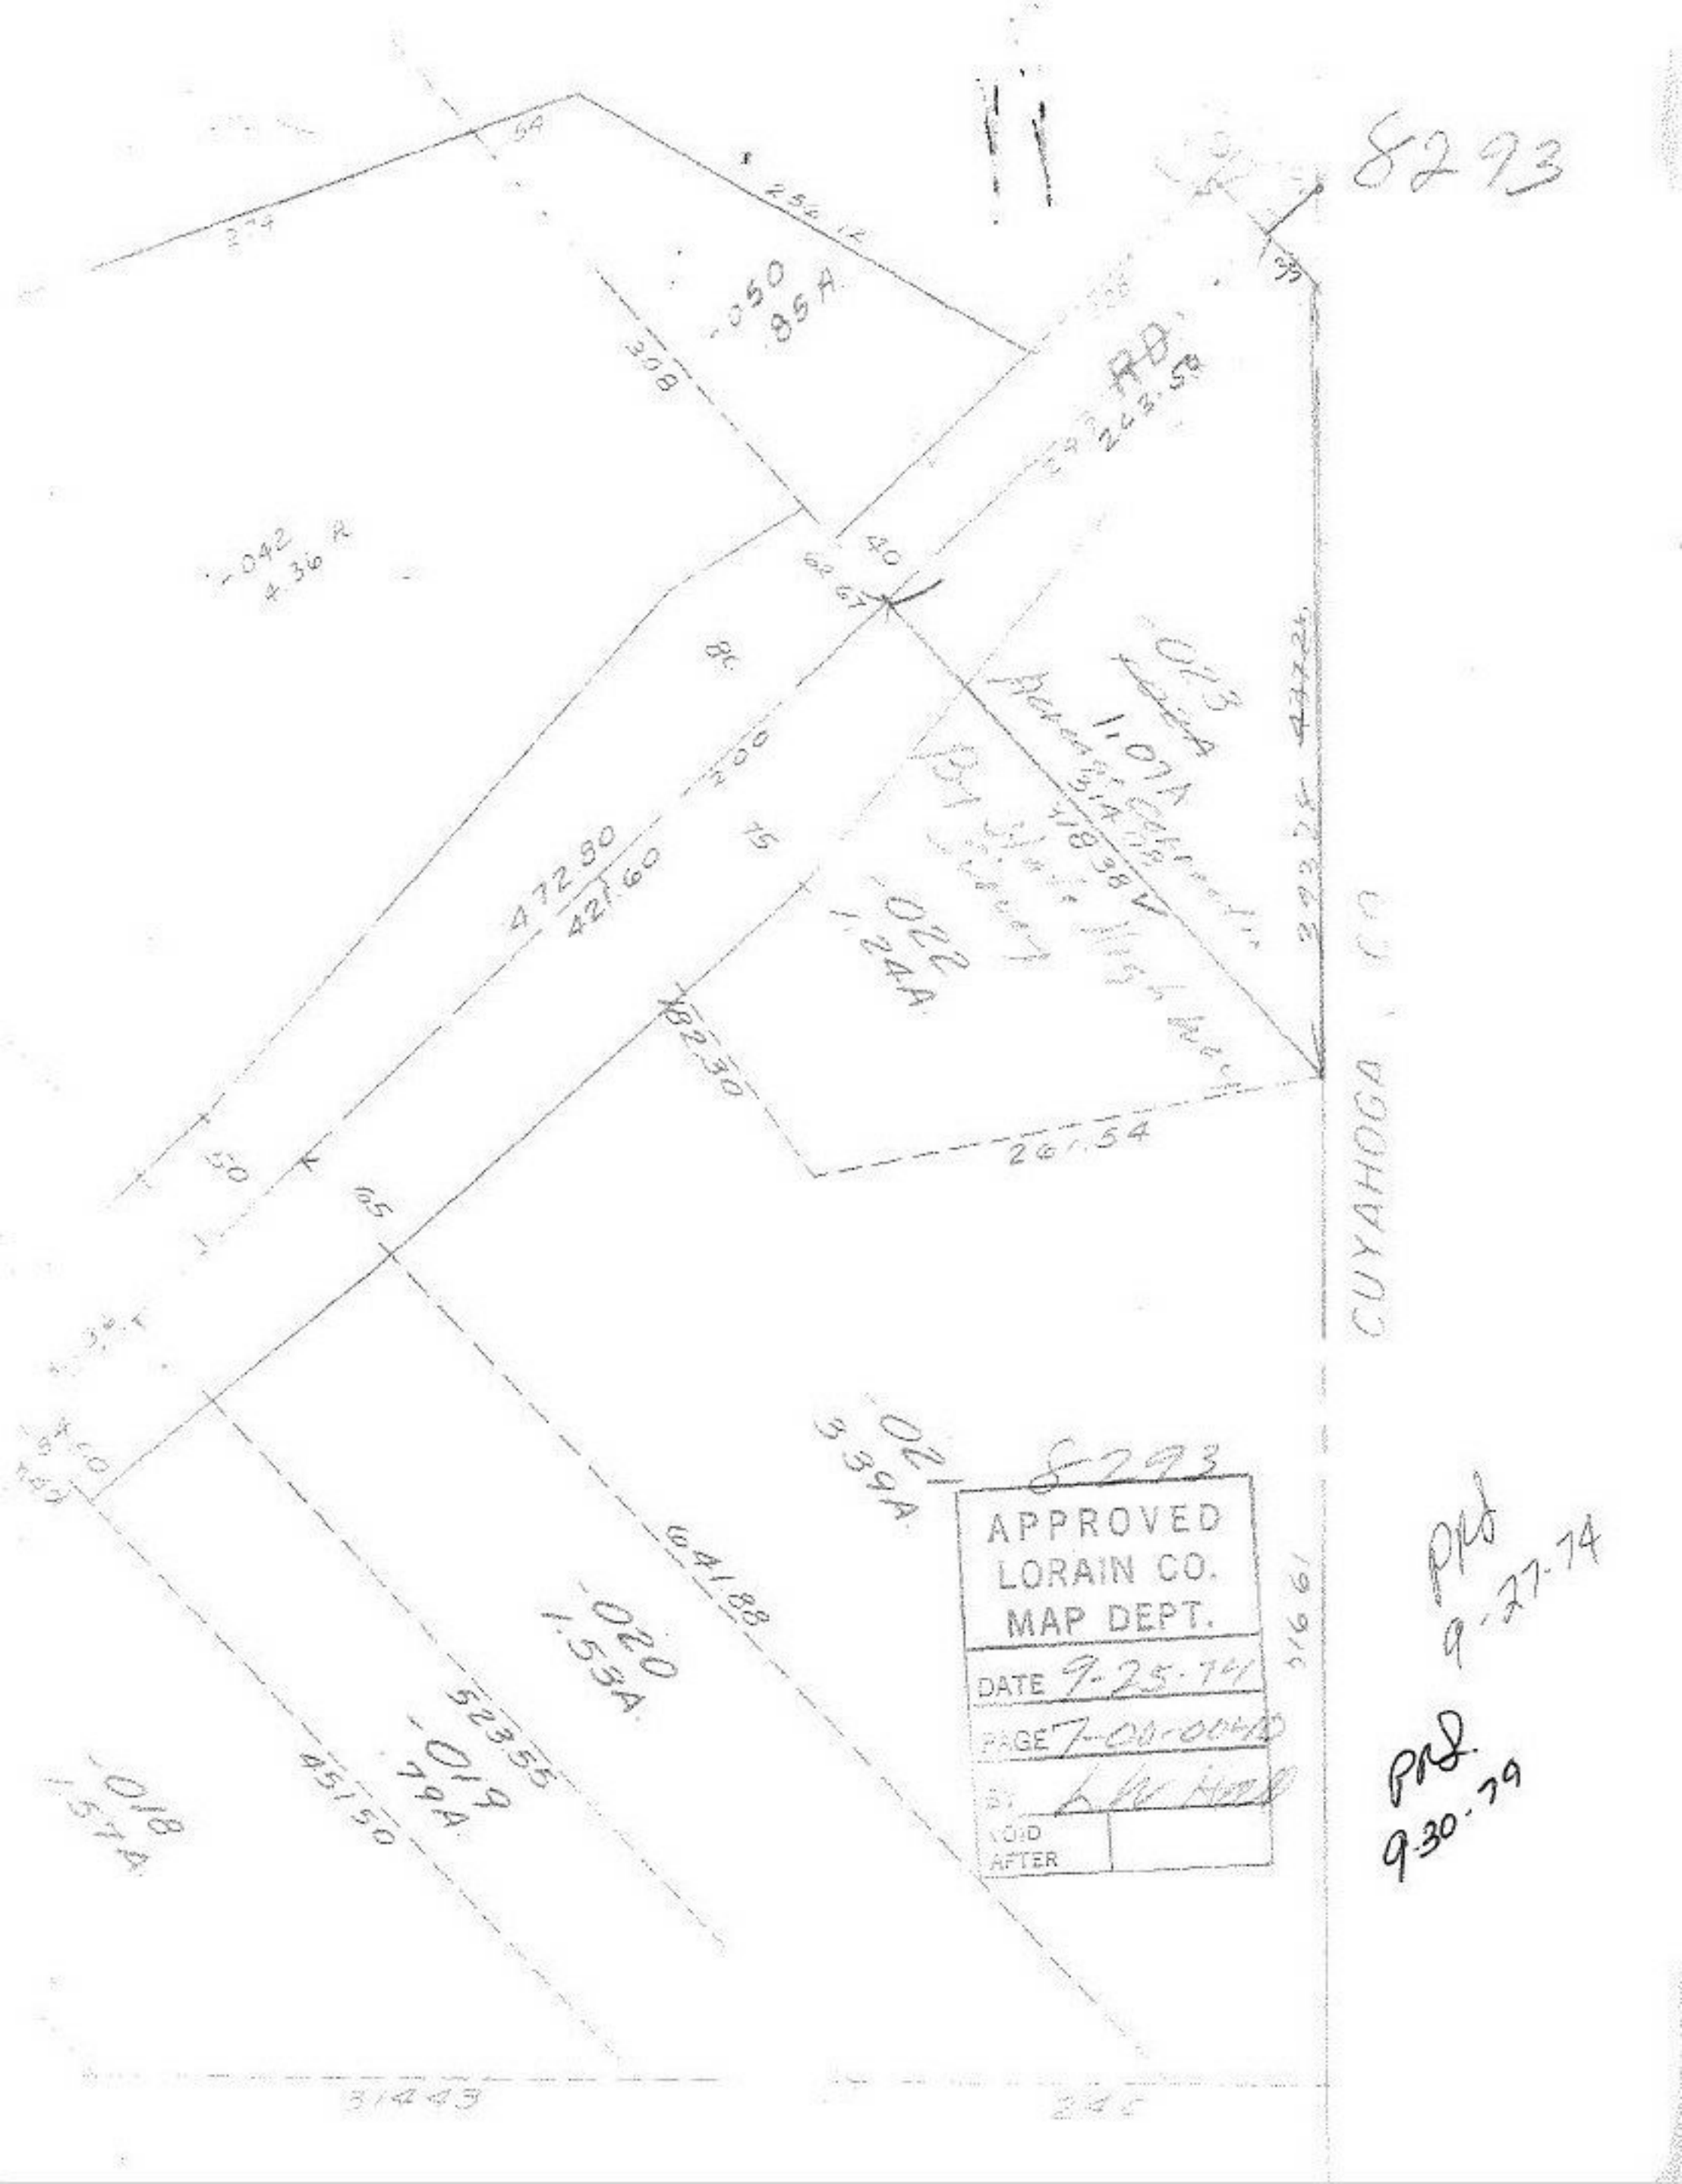
8293
CUYAHOGA CO
.050
.85A
.042
4.36 R
.023
1.07A
.022
1.24A
.021
3.39A
.020
1.53A
.019
.79A
.018
1.57A
472.80
421.60
182.30
261.54
641.88
523.55
451.50
31443
8293
APPROVED
LORAIN CO.
MAP DEPT.
DATE 9-25-74
PAGE 7-00-0040
BY
VOID
AFTER
PRD
9-27-74
PRD.
9-30-79