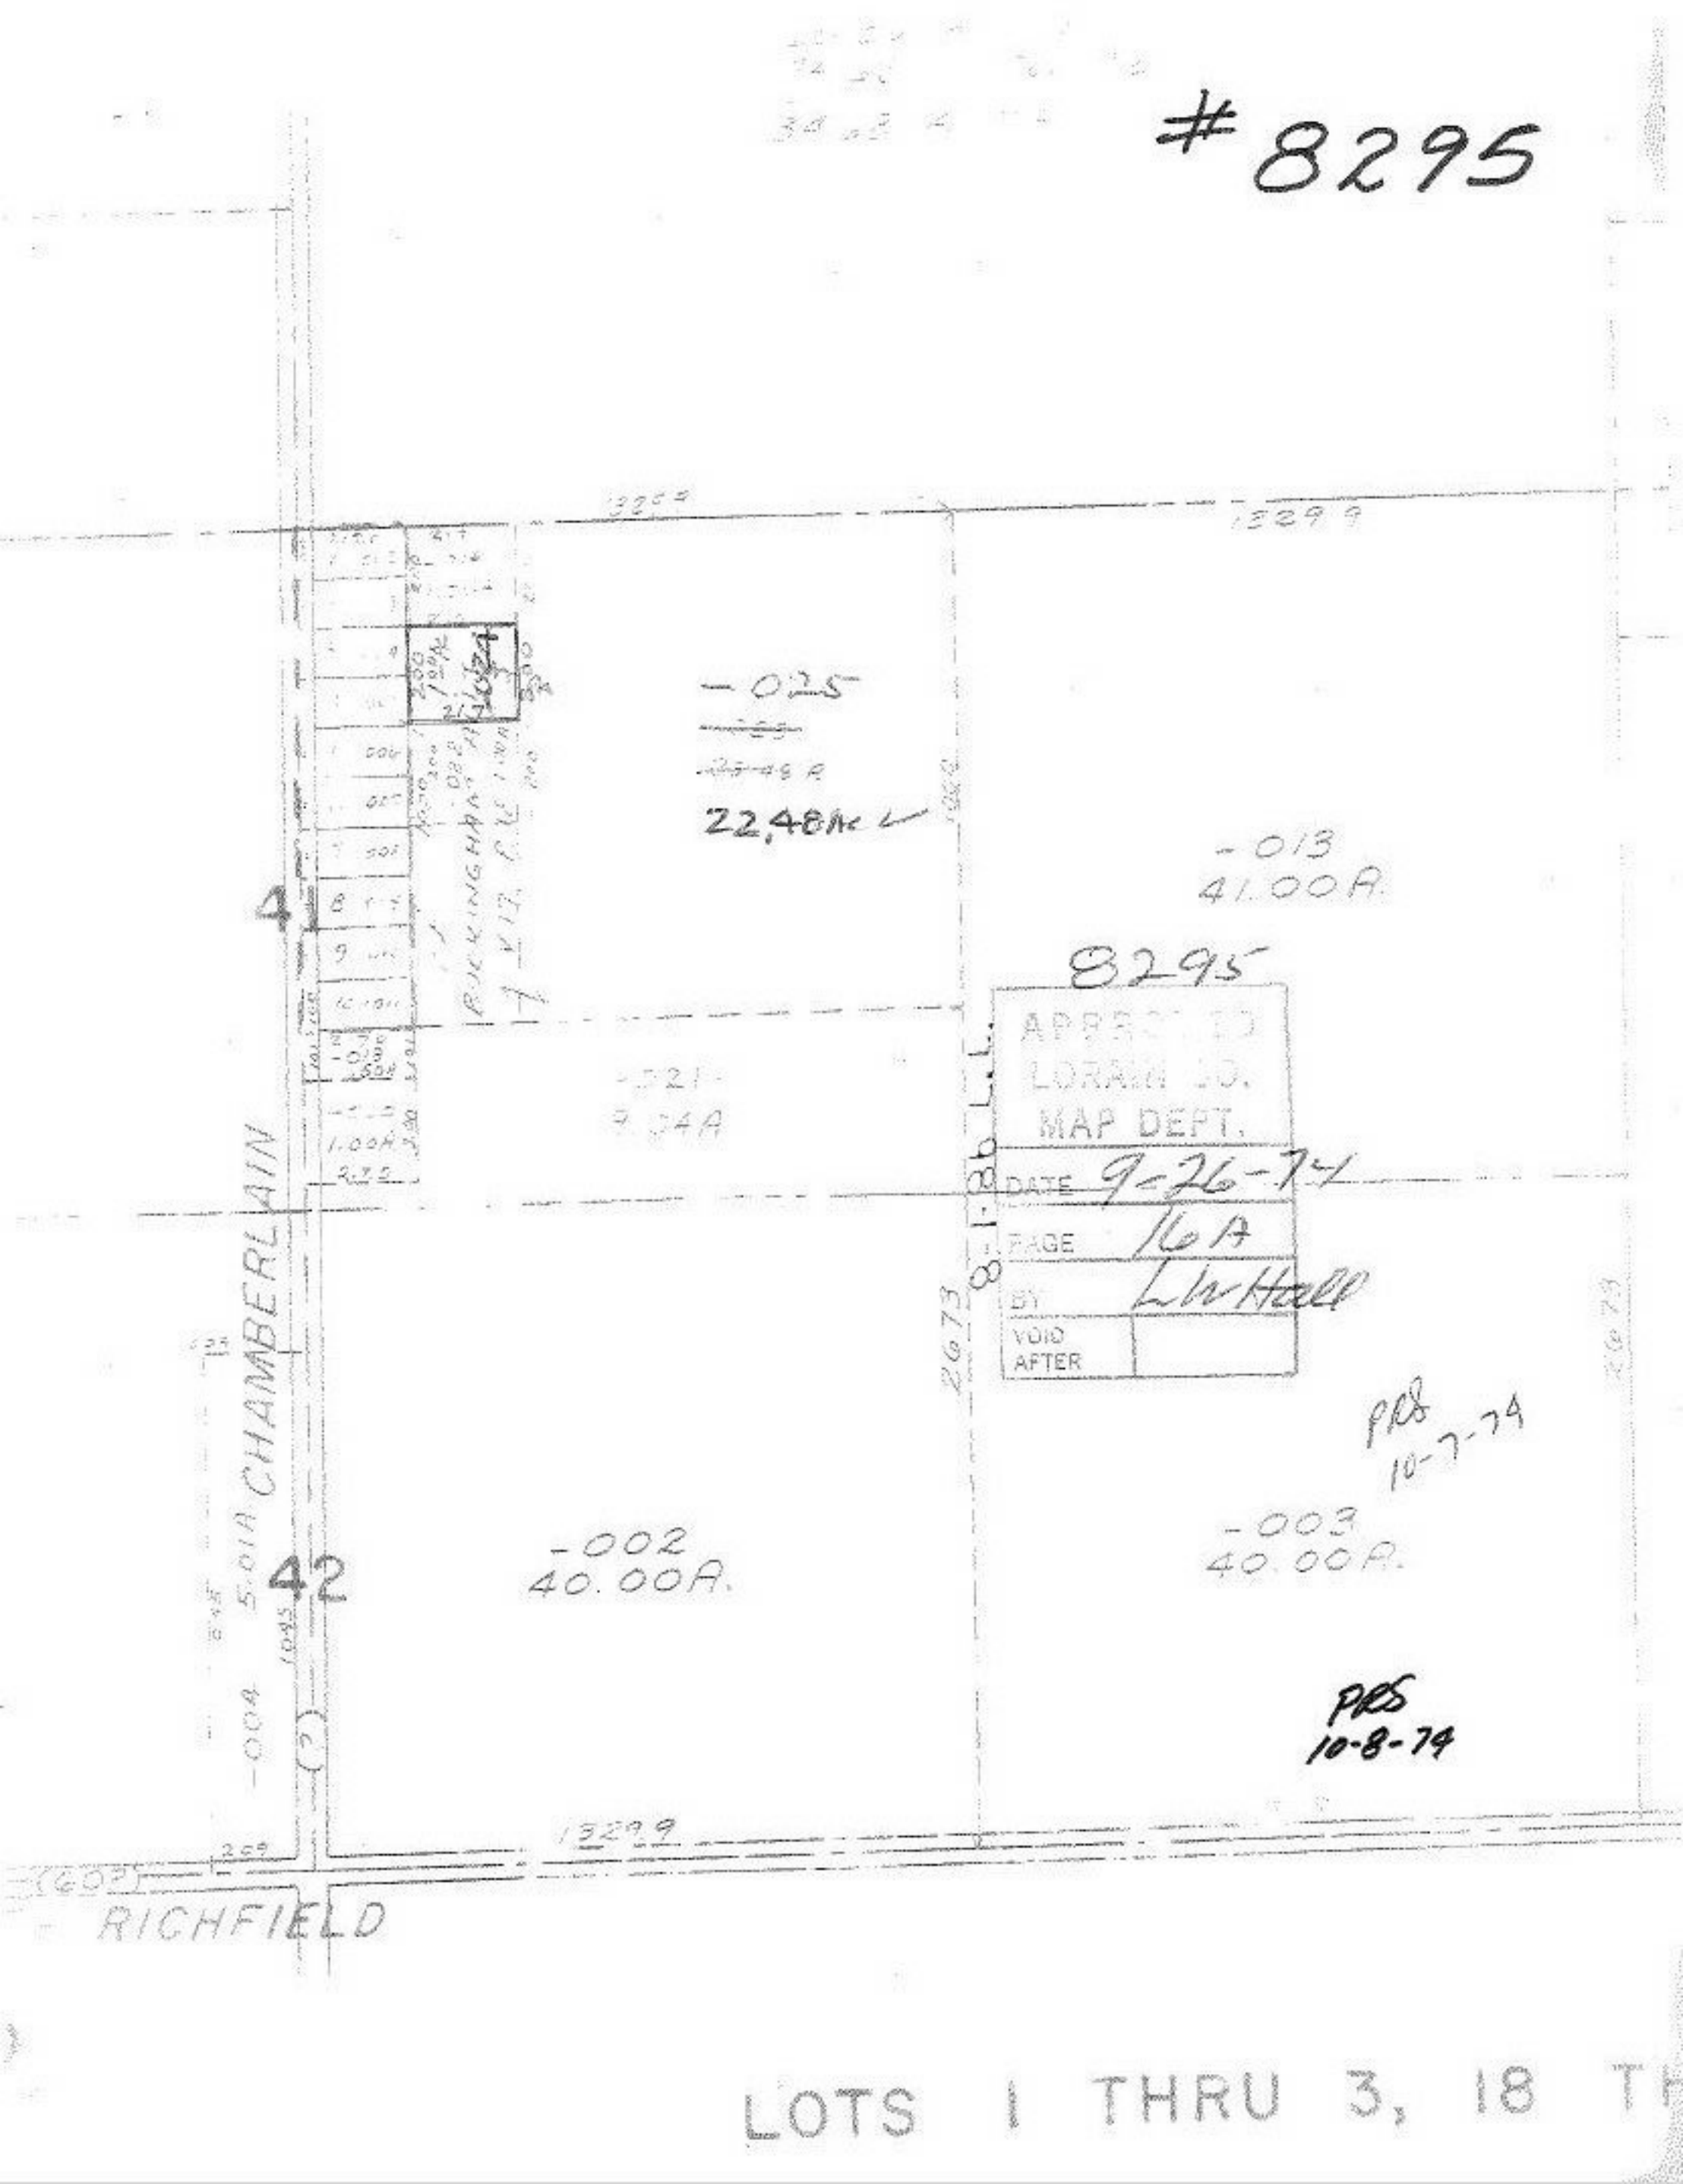
#8295
-025
22.48Ac
-013
41.00A.
8295
APPROVED
LORAIN CO.
MAP DEPT.
DATE 9-26-74
PAGE 16A
BY L.W. Hall
VOID AFTER
PRS 10-7-74
-003
40.00A.
-002
40.00A.
PRS 10-8-74
41
42
CHAMBERLAIN
RICHFIELD
RICKINGHAM
2673
13299
LOTS 1 THRU 3, 18 TH