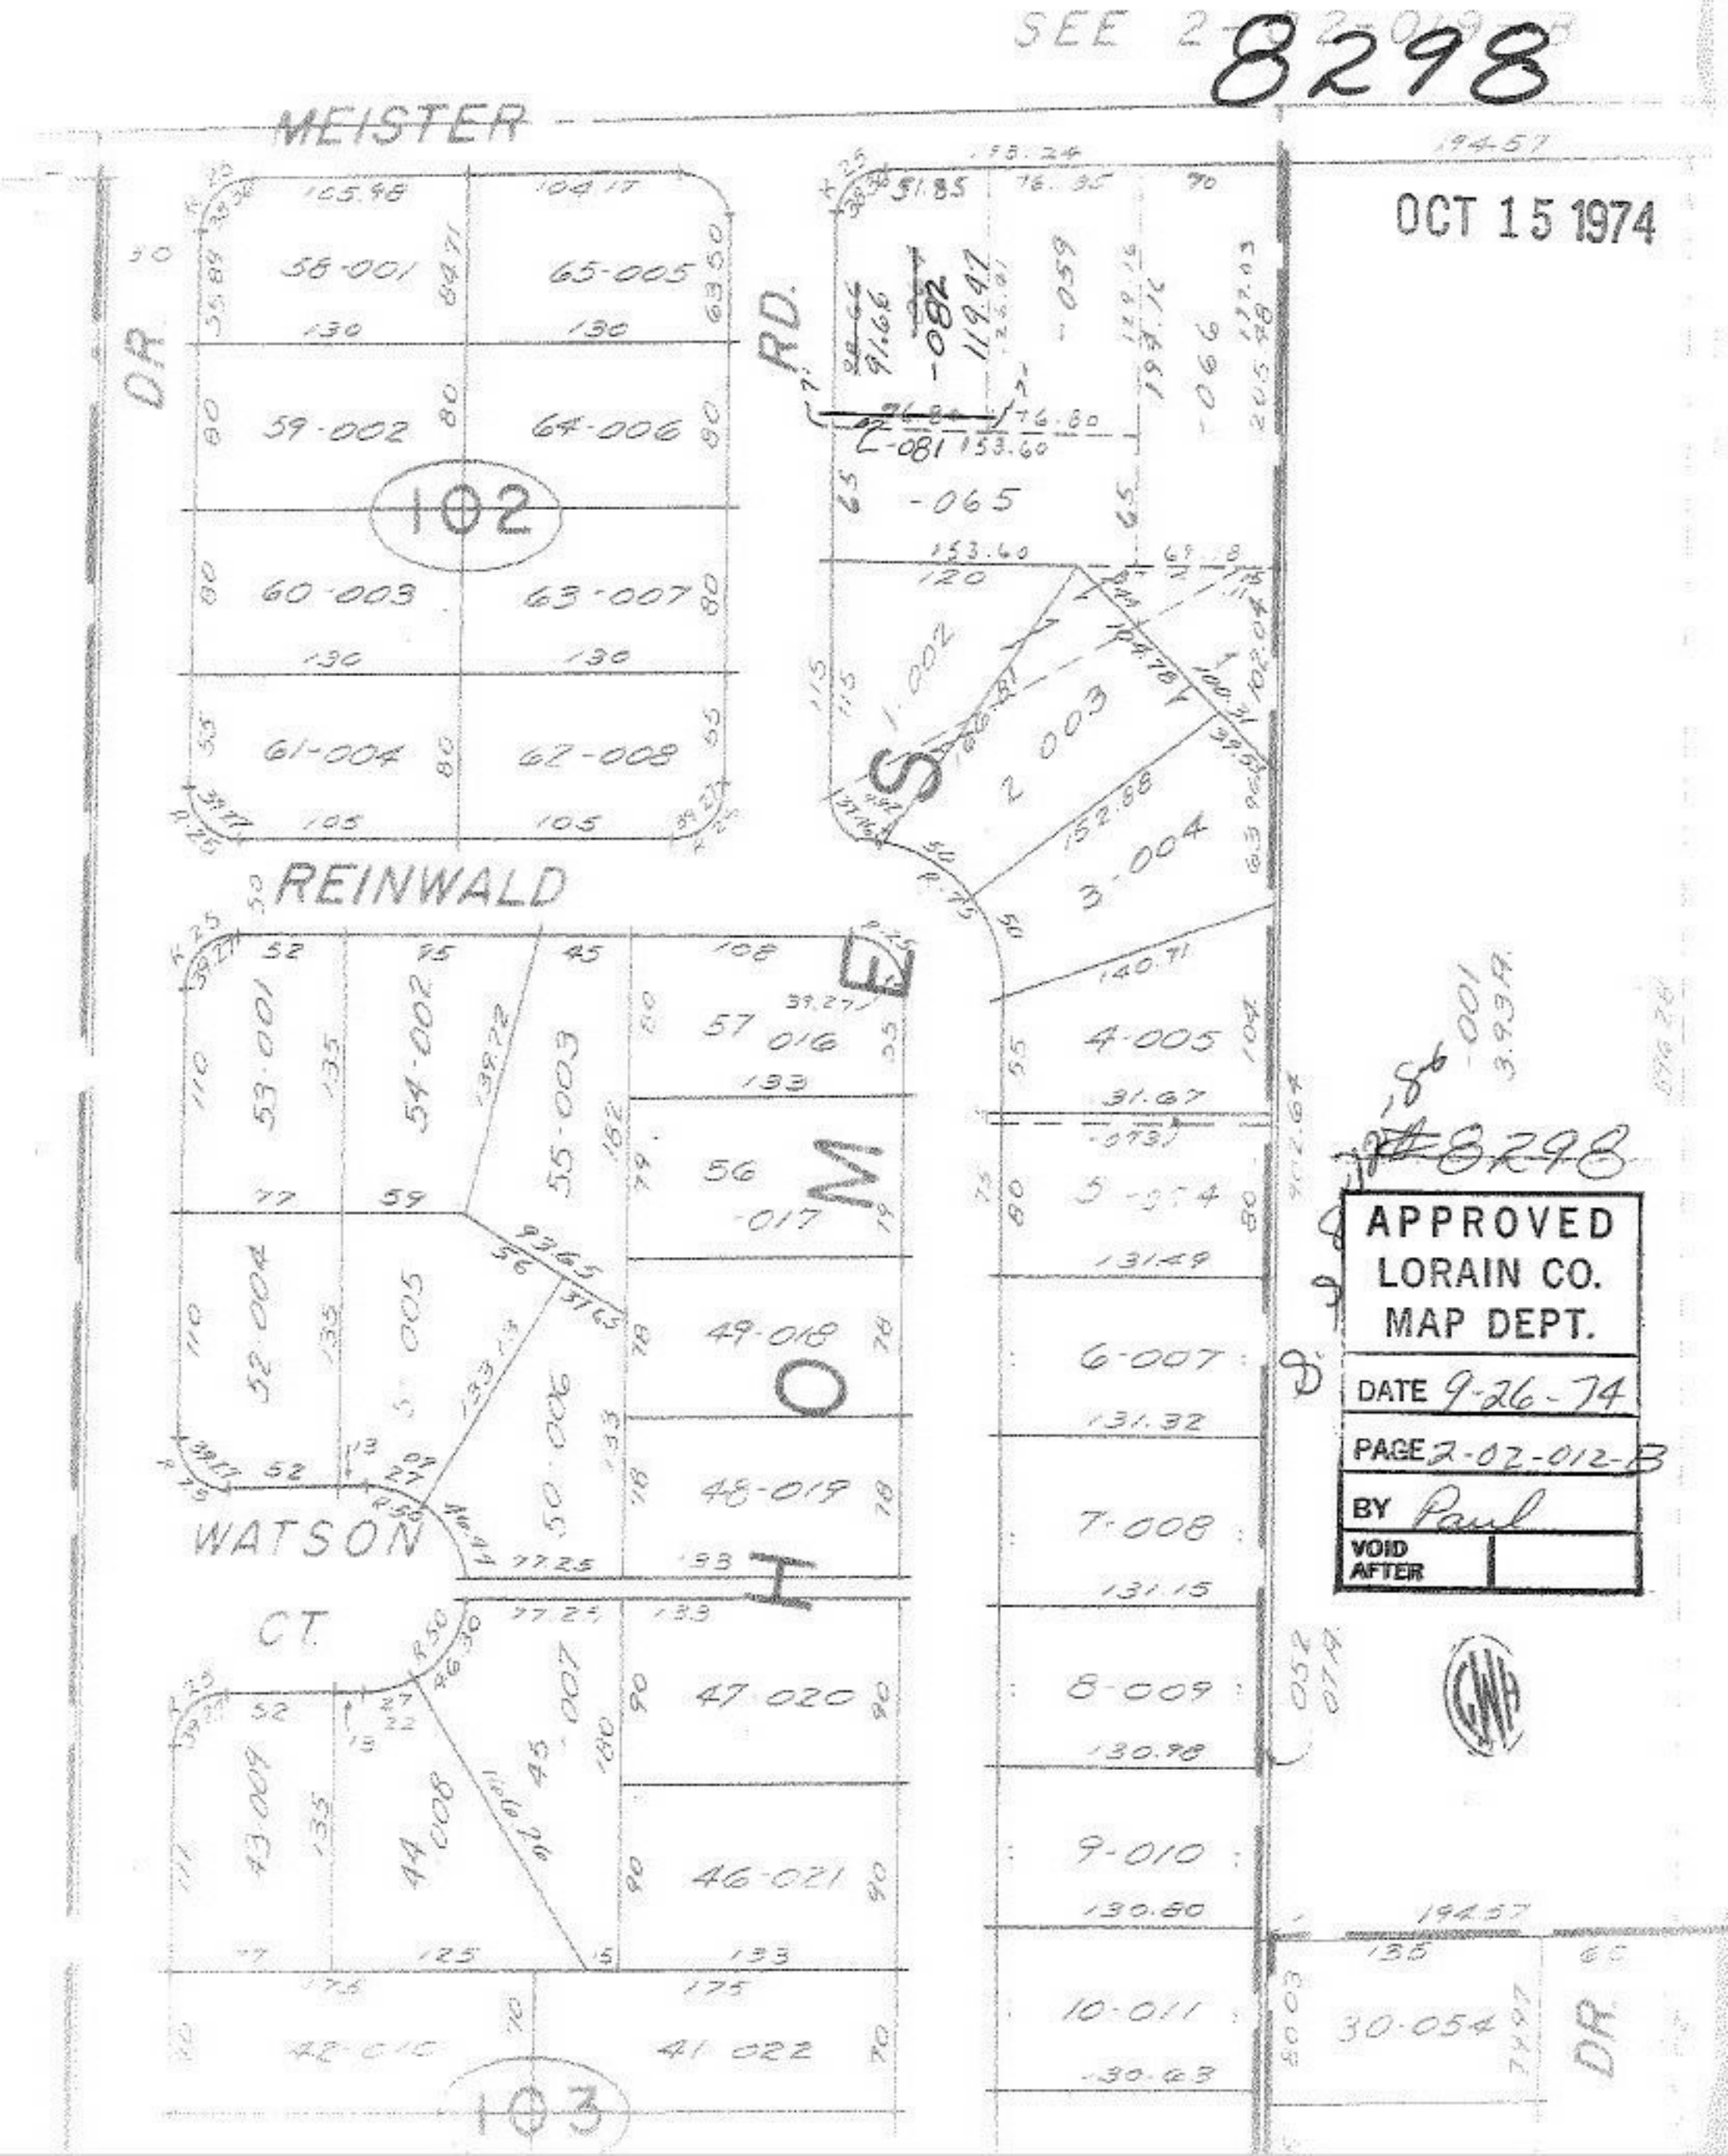
SEE 2-02-019-B
8298
OCT 15 1974
MEISTER
DR
RD.
REINWALD
WATSON
CT.
102
103
58-001
65-005
59-002
64-006
60-003
63-007
61-004
62-008
1-002
2-003
3-004
4-005
5-004
6-007
7-008
8-009
9-010
10-011
30-054
57-016
56-017
49-018
48-019
47-020
46-021
41-022
42-010
53-001
54-002
55-003
52-004
50-006
43-009
44-008
45-007
#8298
APPROVED
LORAIN CO.
MAP DEPT.
DATE 9-26-74
PAGE 2-02-012-B
BY Paul
VOID AFTER