8299

OCT 15 1974

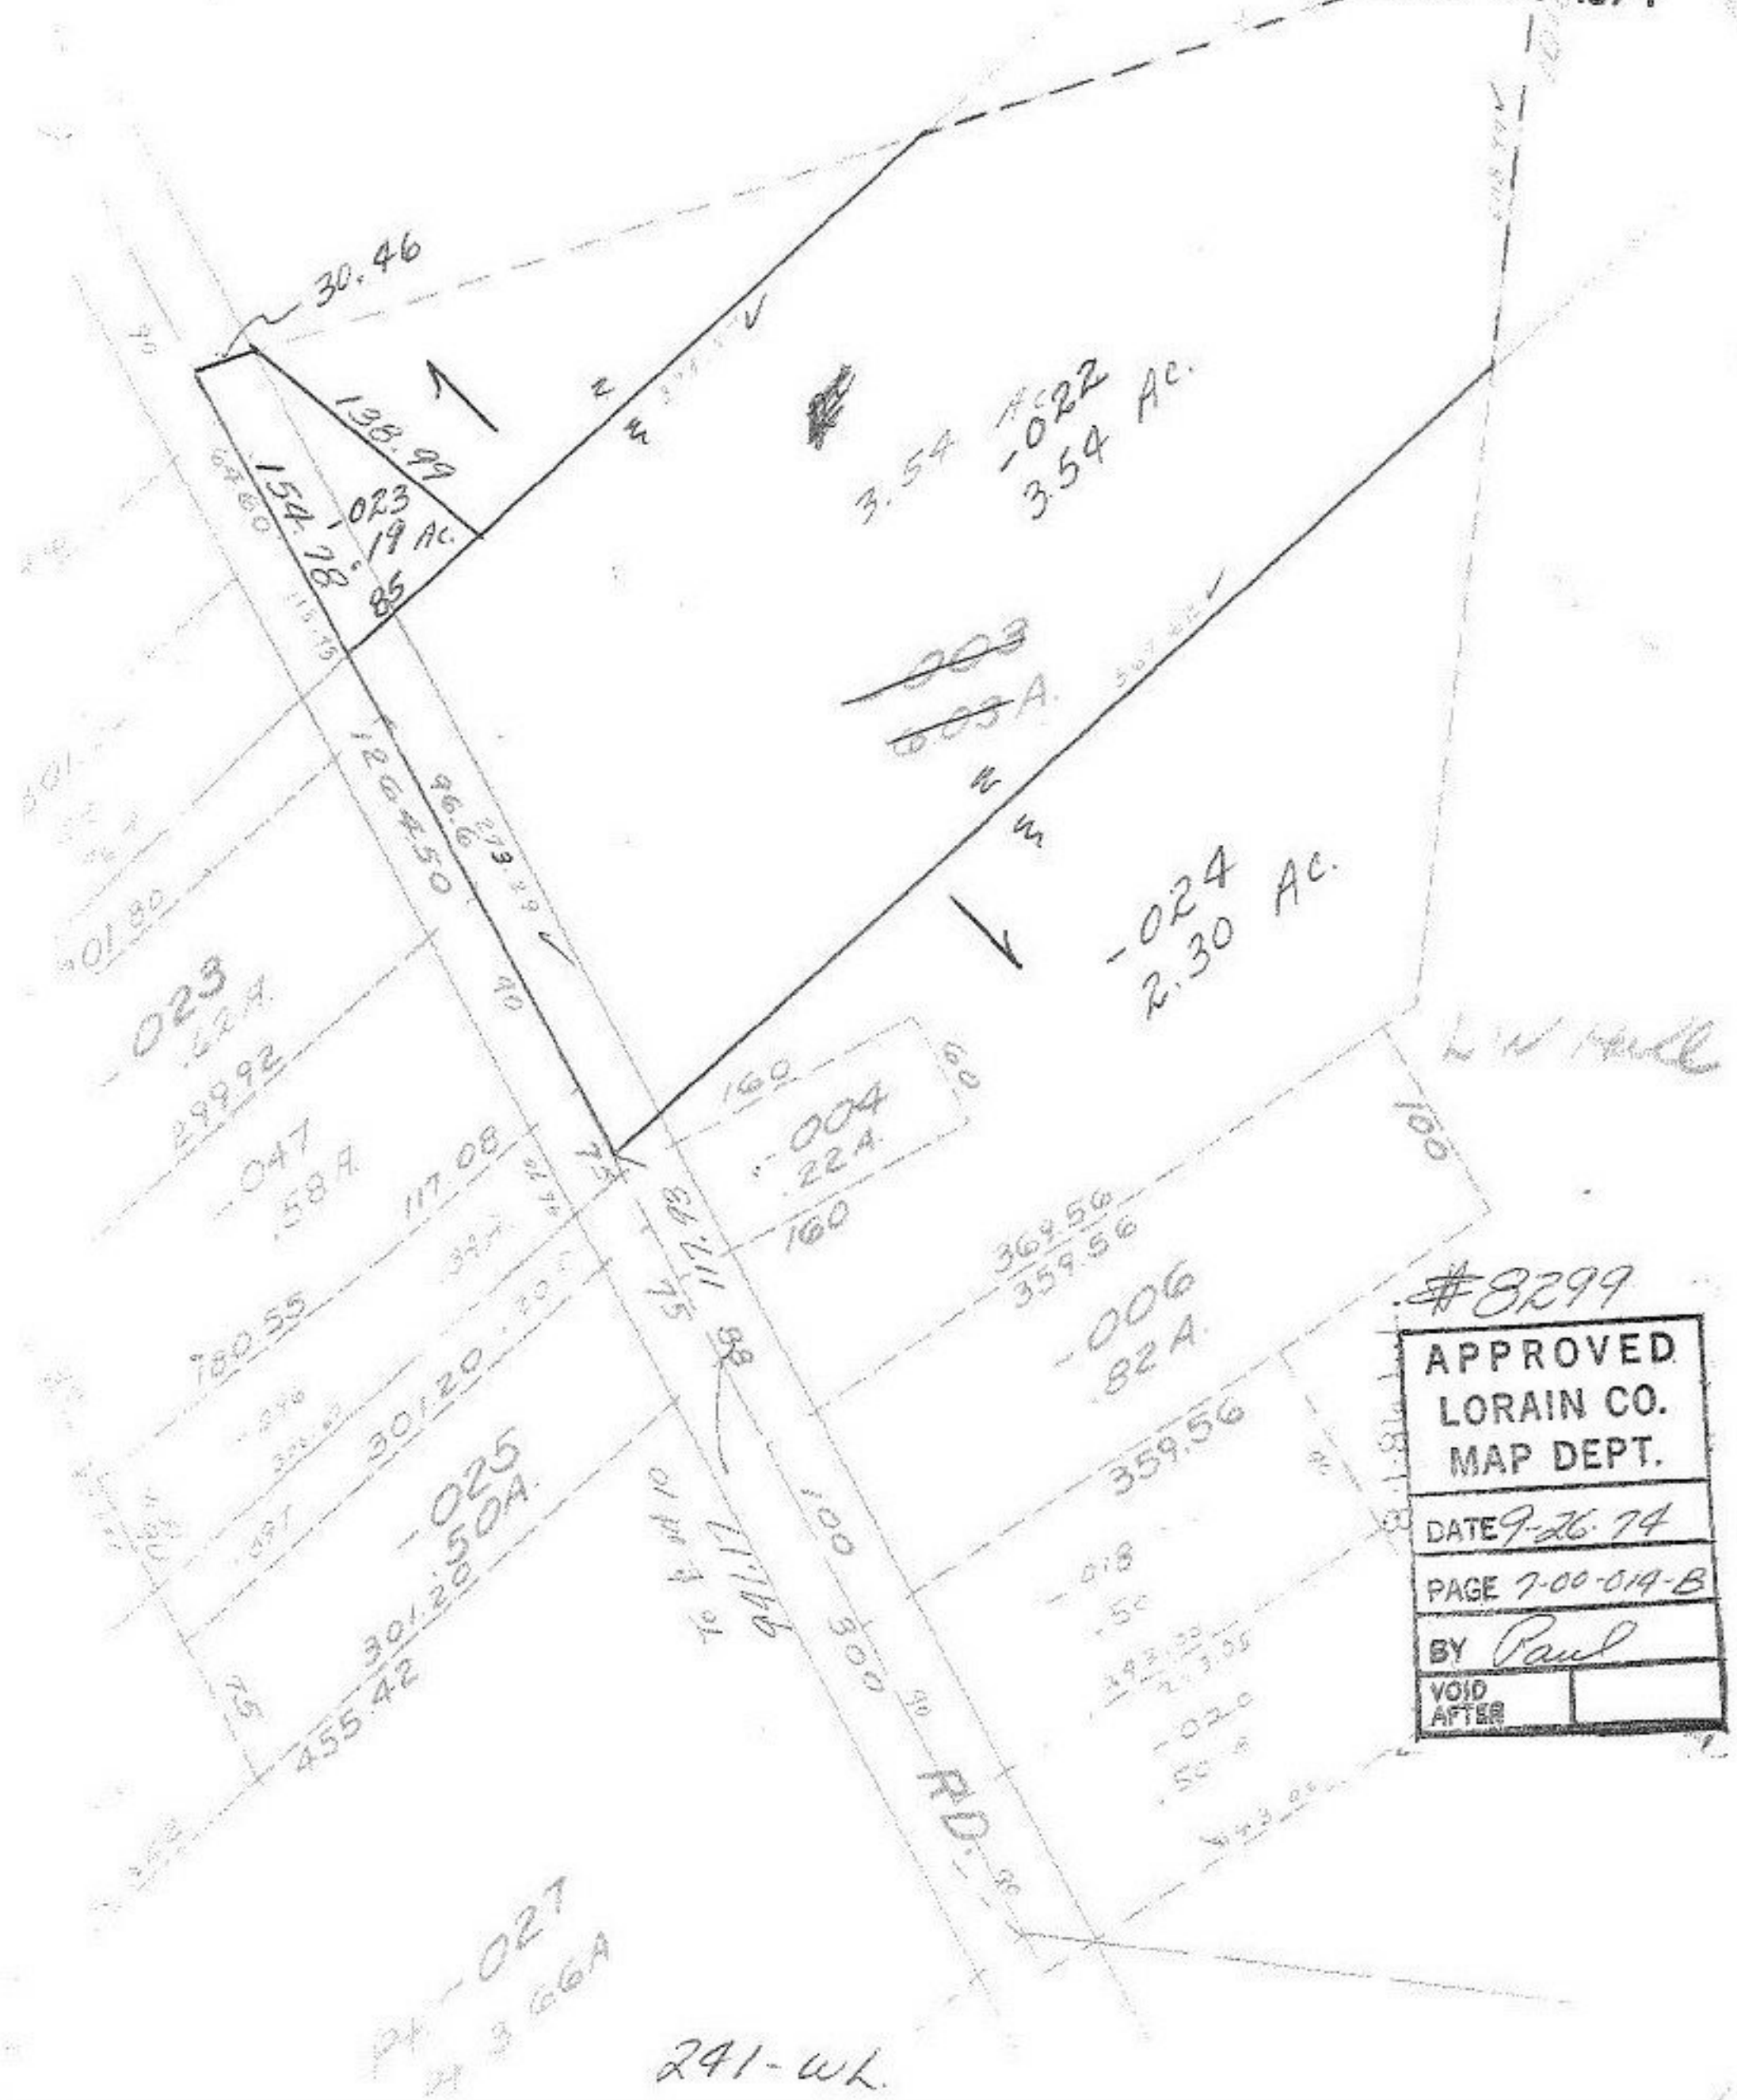

#8299

APPROVED
LORAIN CO.
MAP DEPT.

DATE 9-26-74

PAGE 7-00-014-B

BY Paul

VOID AFTER