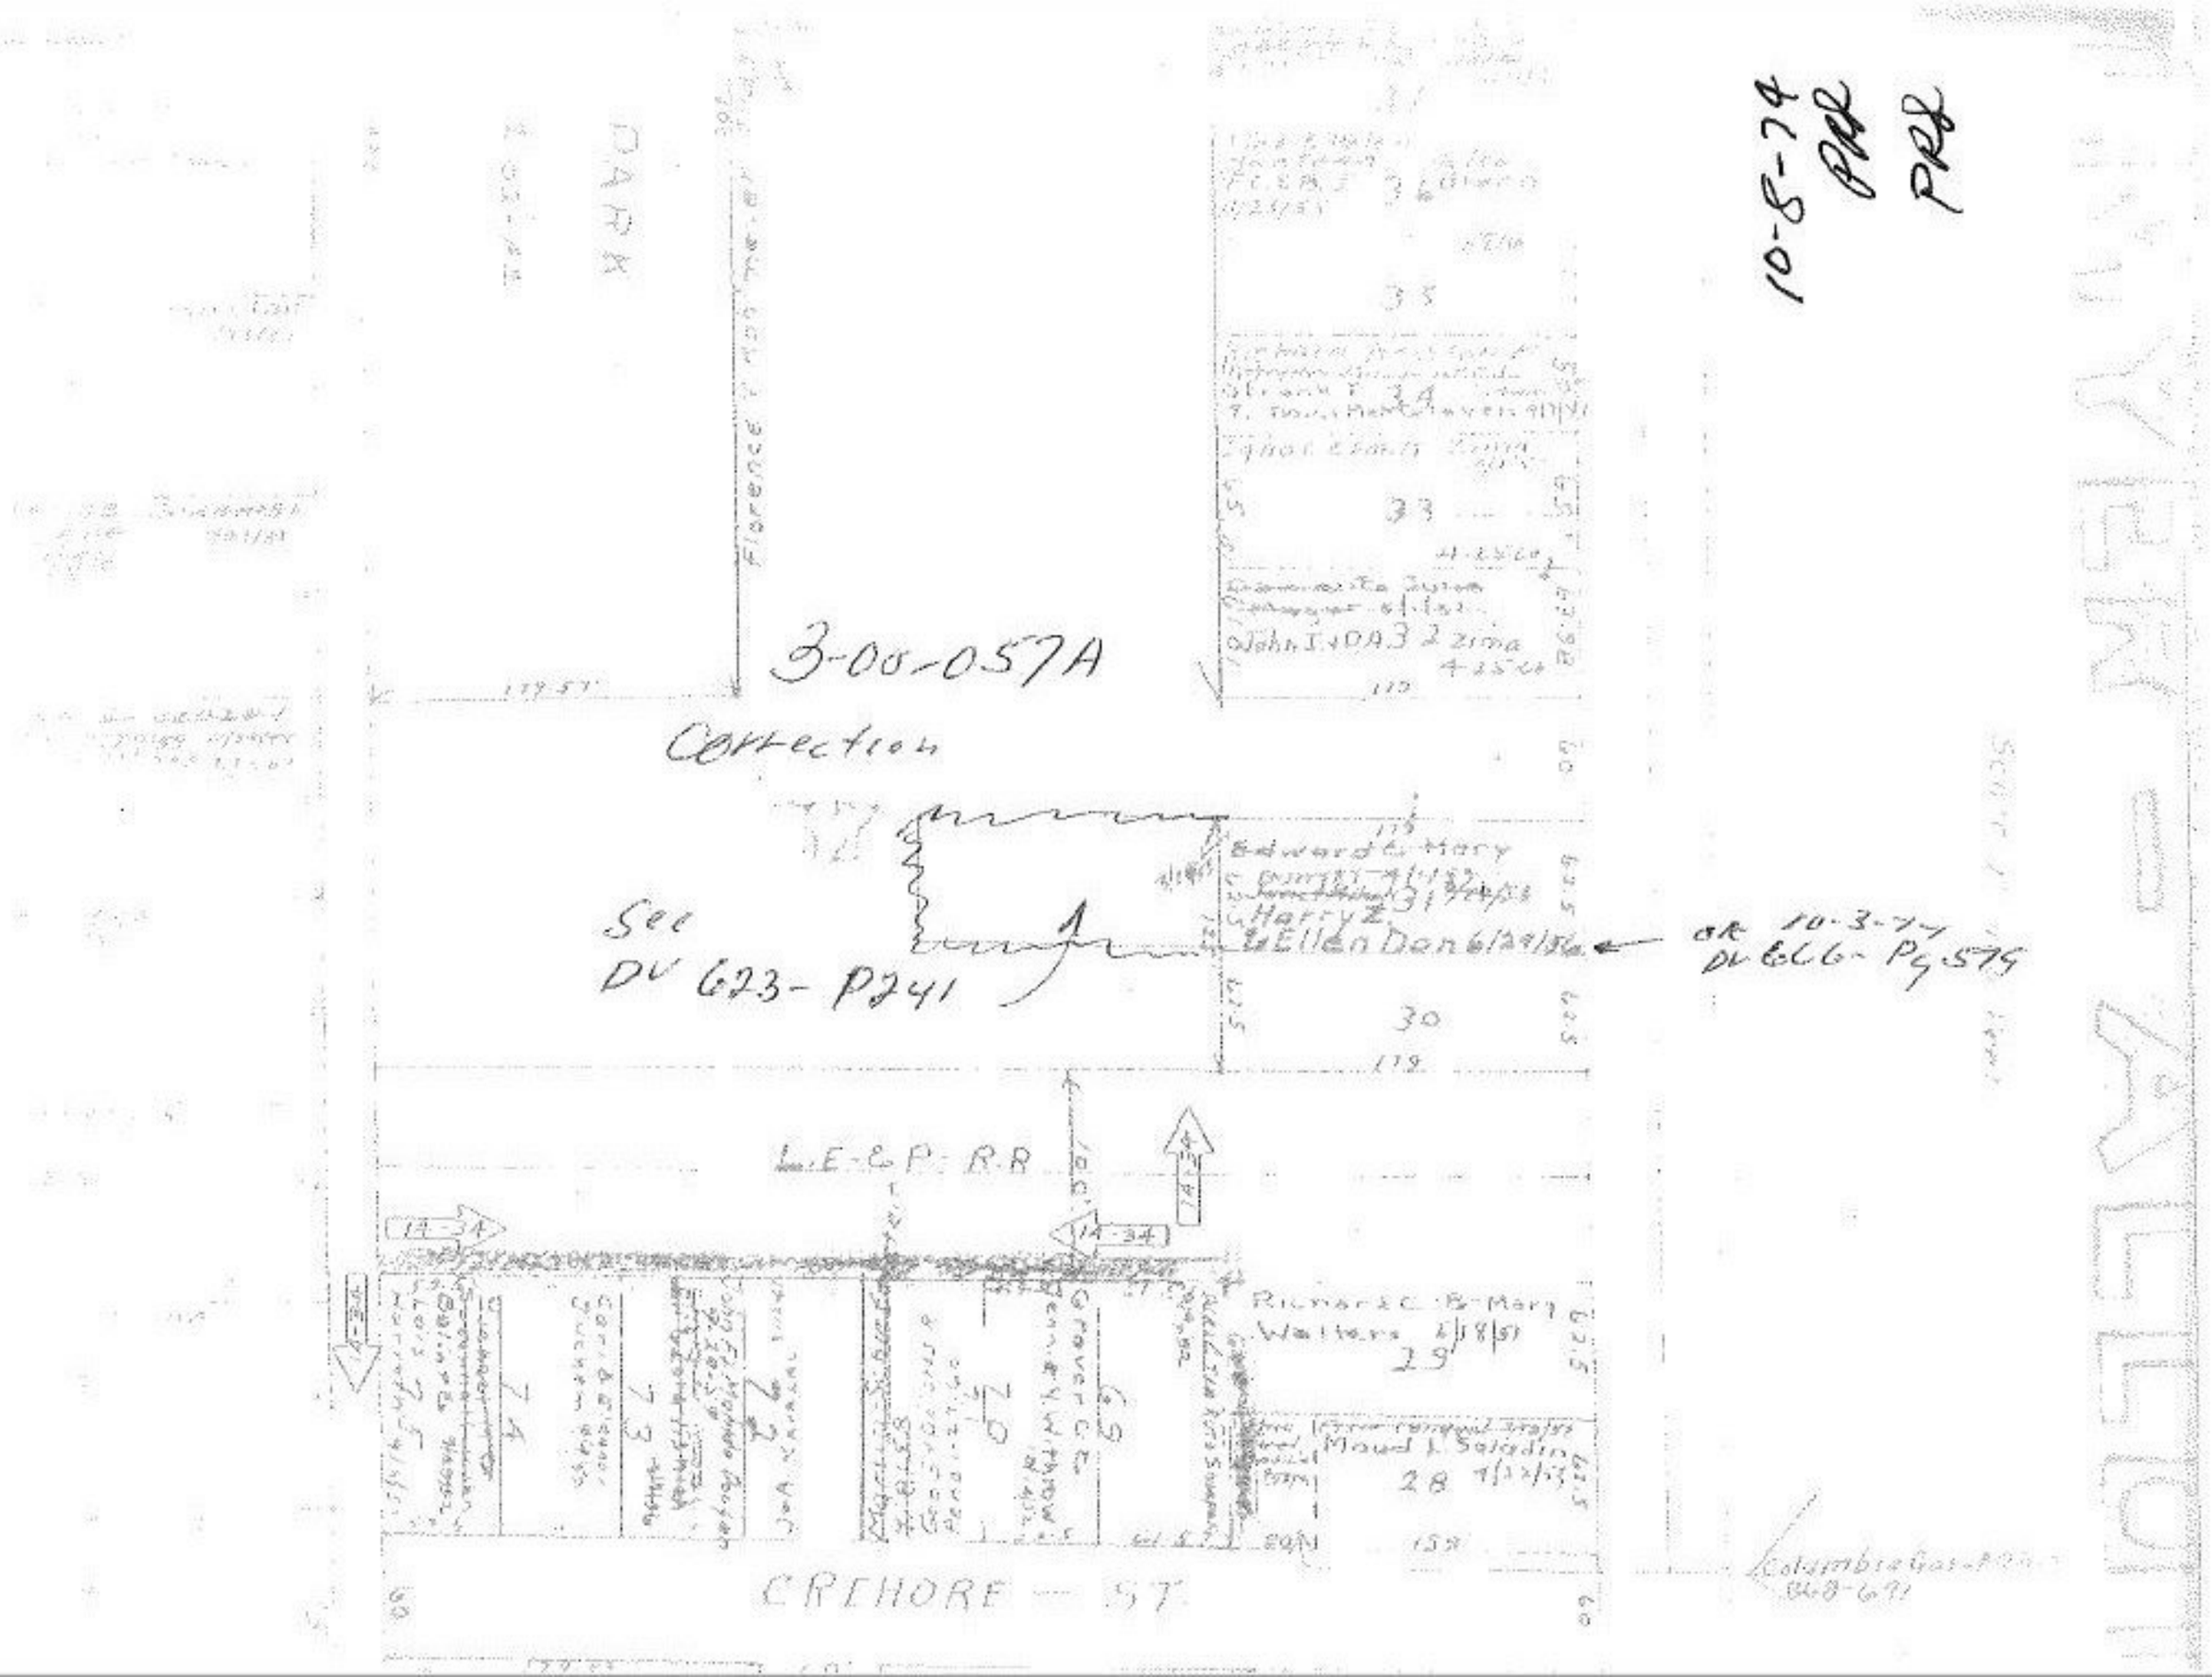

10-8-74
PRR
PRR
3-00-057A
Correction
See
DV 623- P241
Edward C. Mary
Harry Z.
Ellen Don 6/29/56
OR 10-3-74
DV 666- Pg 579
30
L.E.&P. R.R.
14-34
Richard C. & Mary
Walters 6/18/51
29
Maud L. Saladin
28
CREHORE — ST.
Columbia Gas
868-691
Florence
PARK