#8330

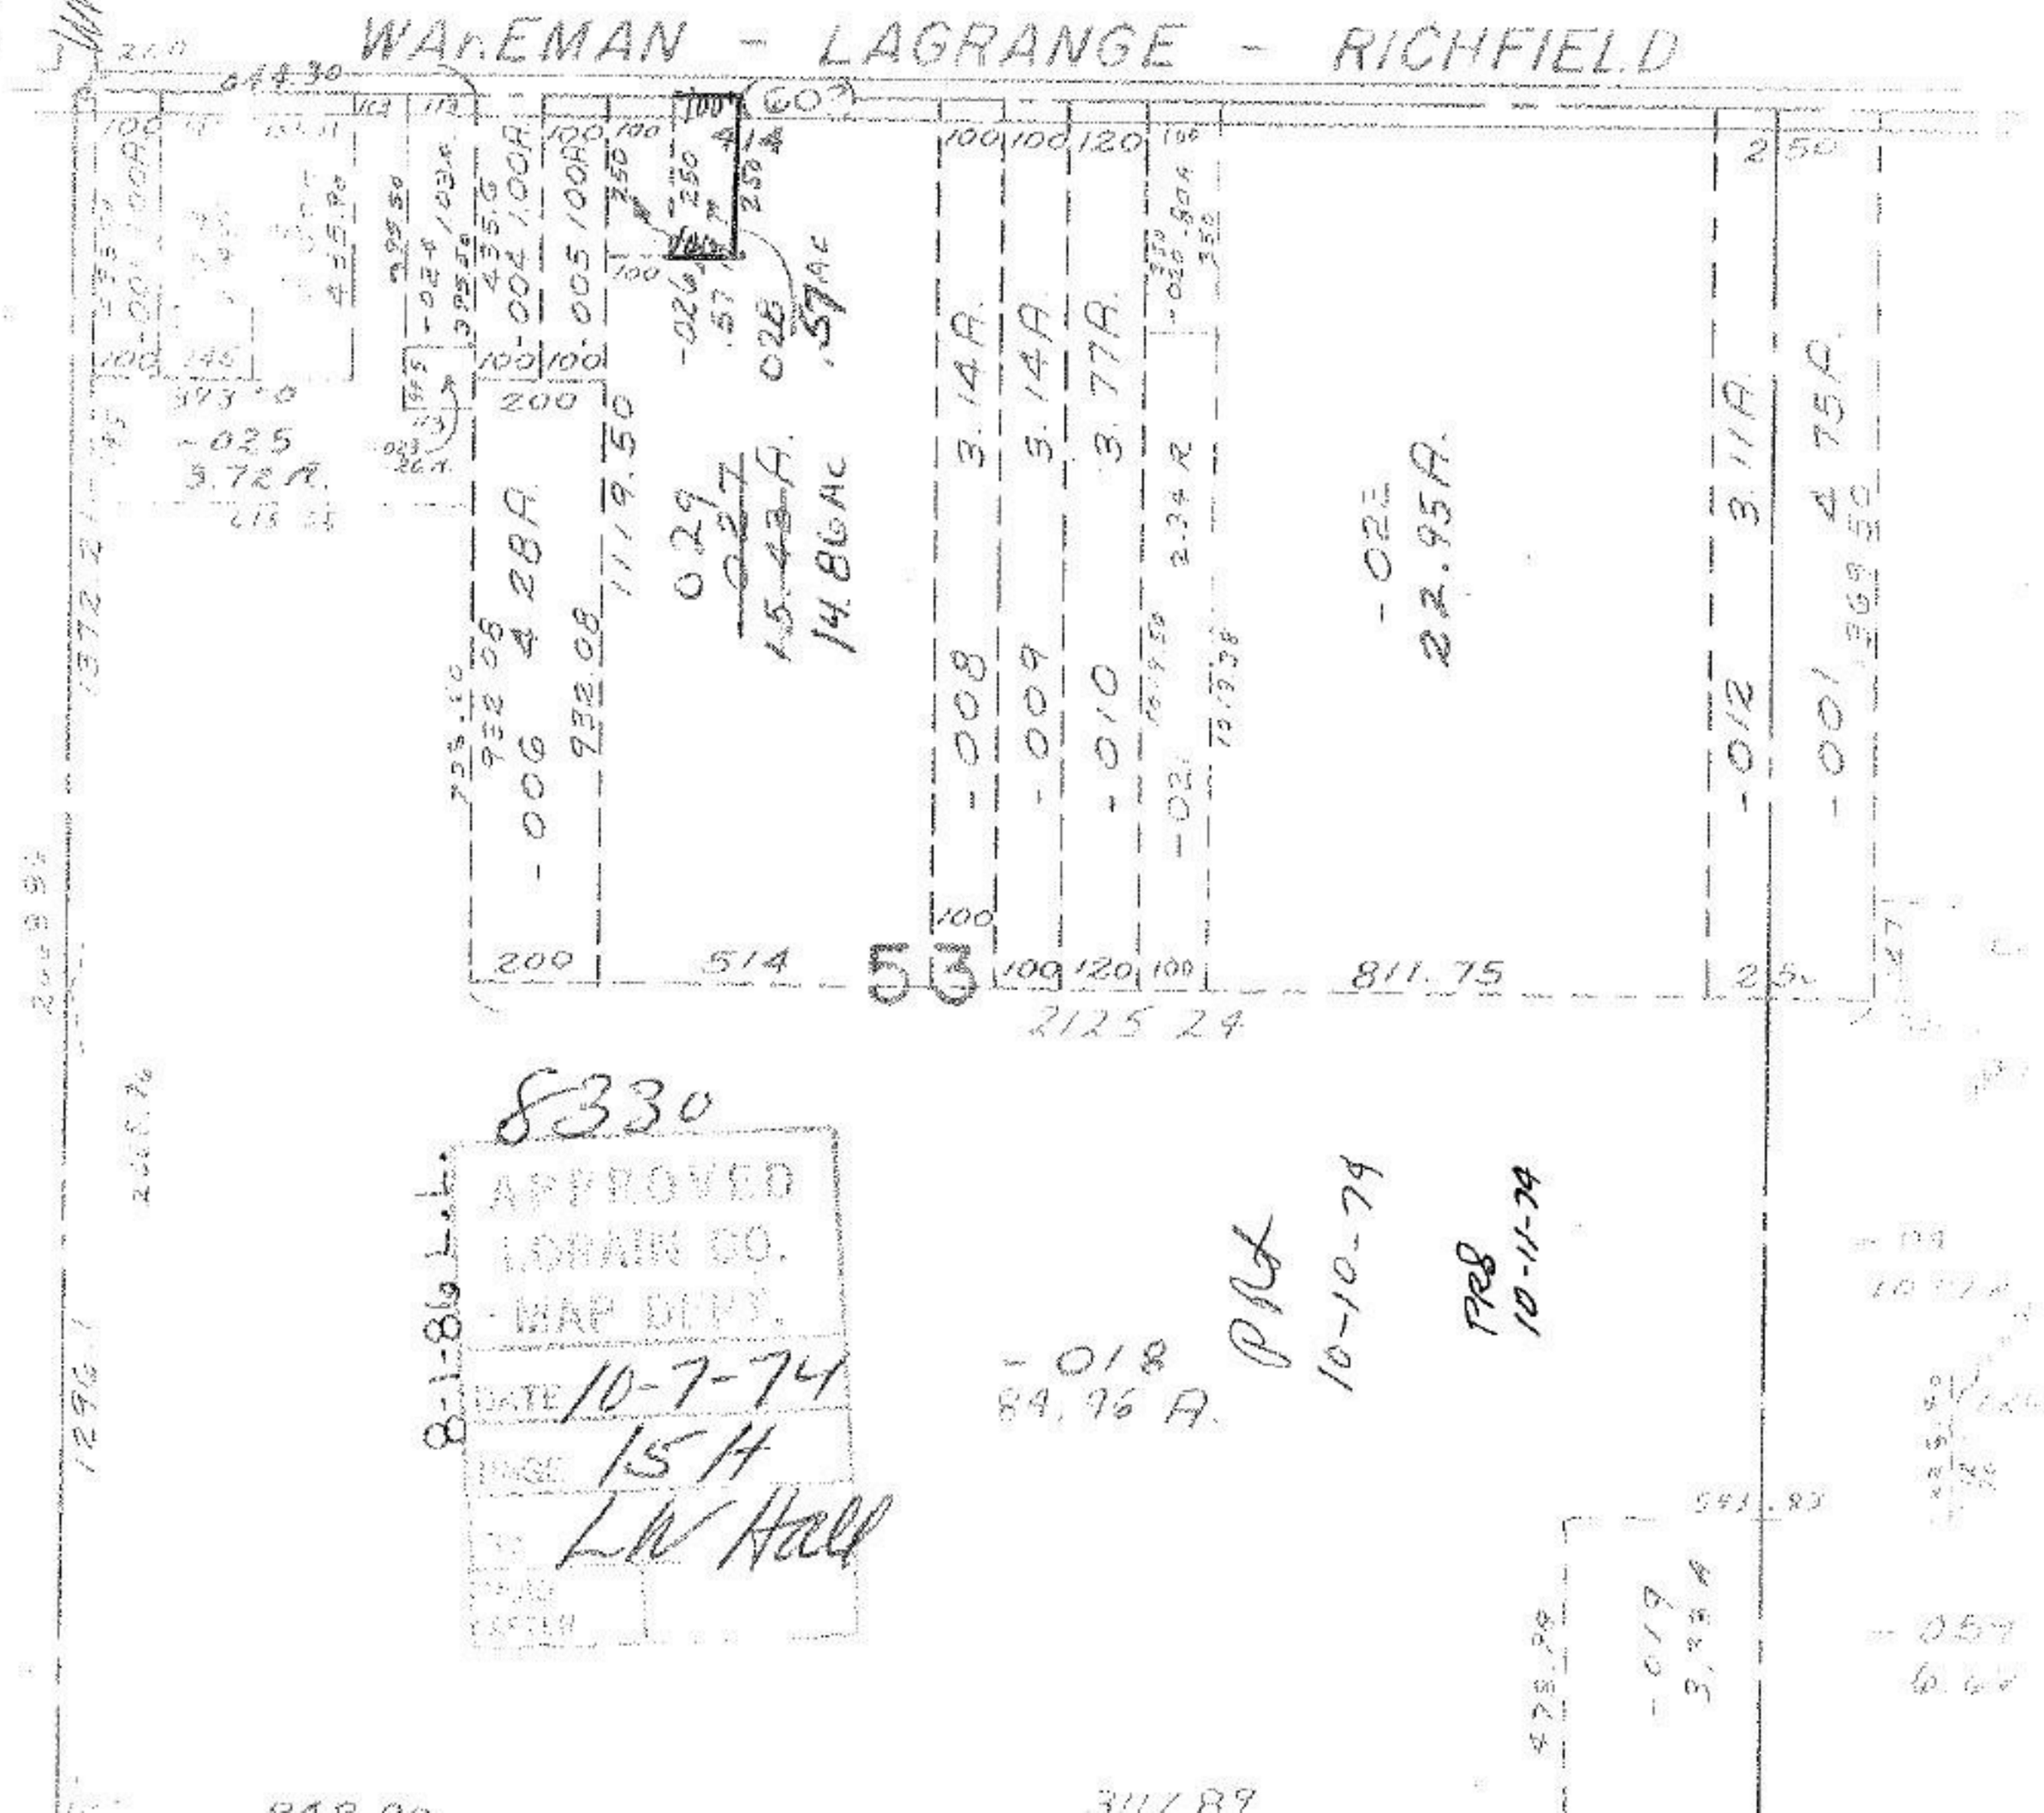
WAKEMAN - LAGRANGE - RICHFIELD
-025
3.72 A.
-006
4.28 A.
932.08
1119.50
029
027
15.43 A.
14.86 AC
.57 AC
028
-026
-008
3.14 A.
-009
3.14 A.
-010
3.77 A.
-021
2.34 A.
-022
22.95 A.
-012
3.11 A.
-001
4.75 A.
200
514
53
100
120
811.75
2125.24
8330
APPROVED
LORAIN CO.
MAP DEPT.
DATE 10-7-74
PAGE 15 H
LW Hall
8-1-86 L.L.
-018
84.96 A.
PRL
10-10-74
PRB
10-11-74
-019
3.38 A.
-057
6.66
311.89