#8331

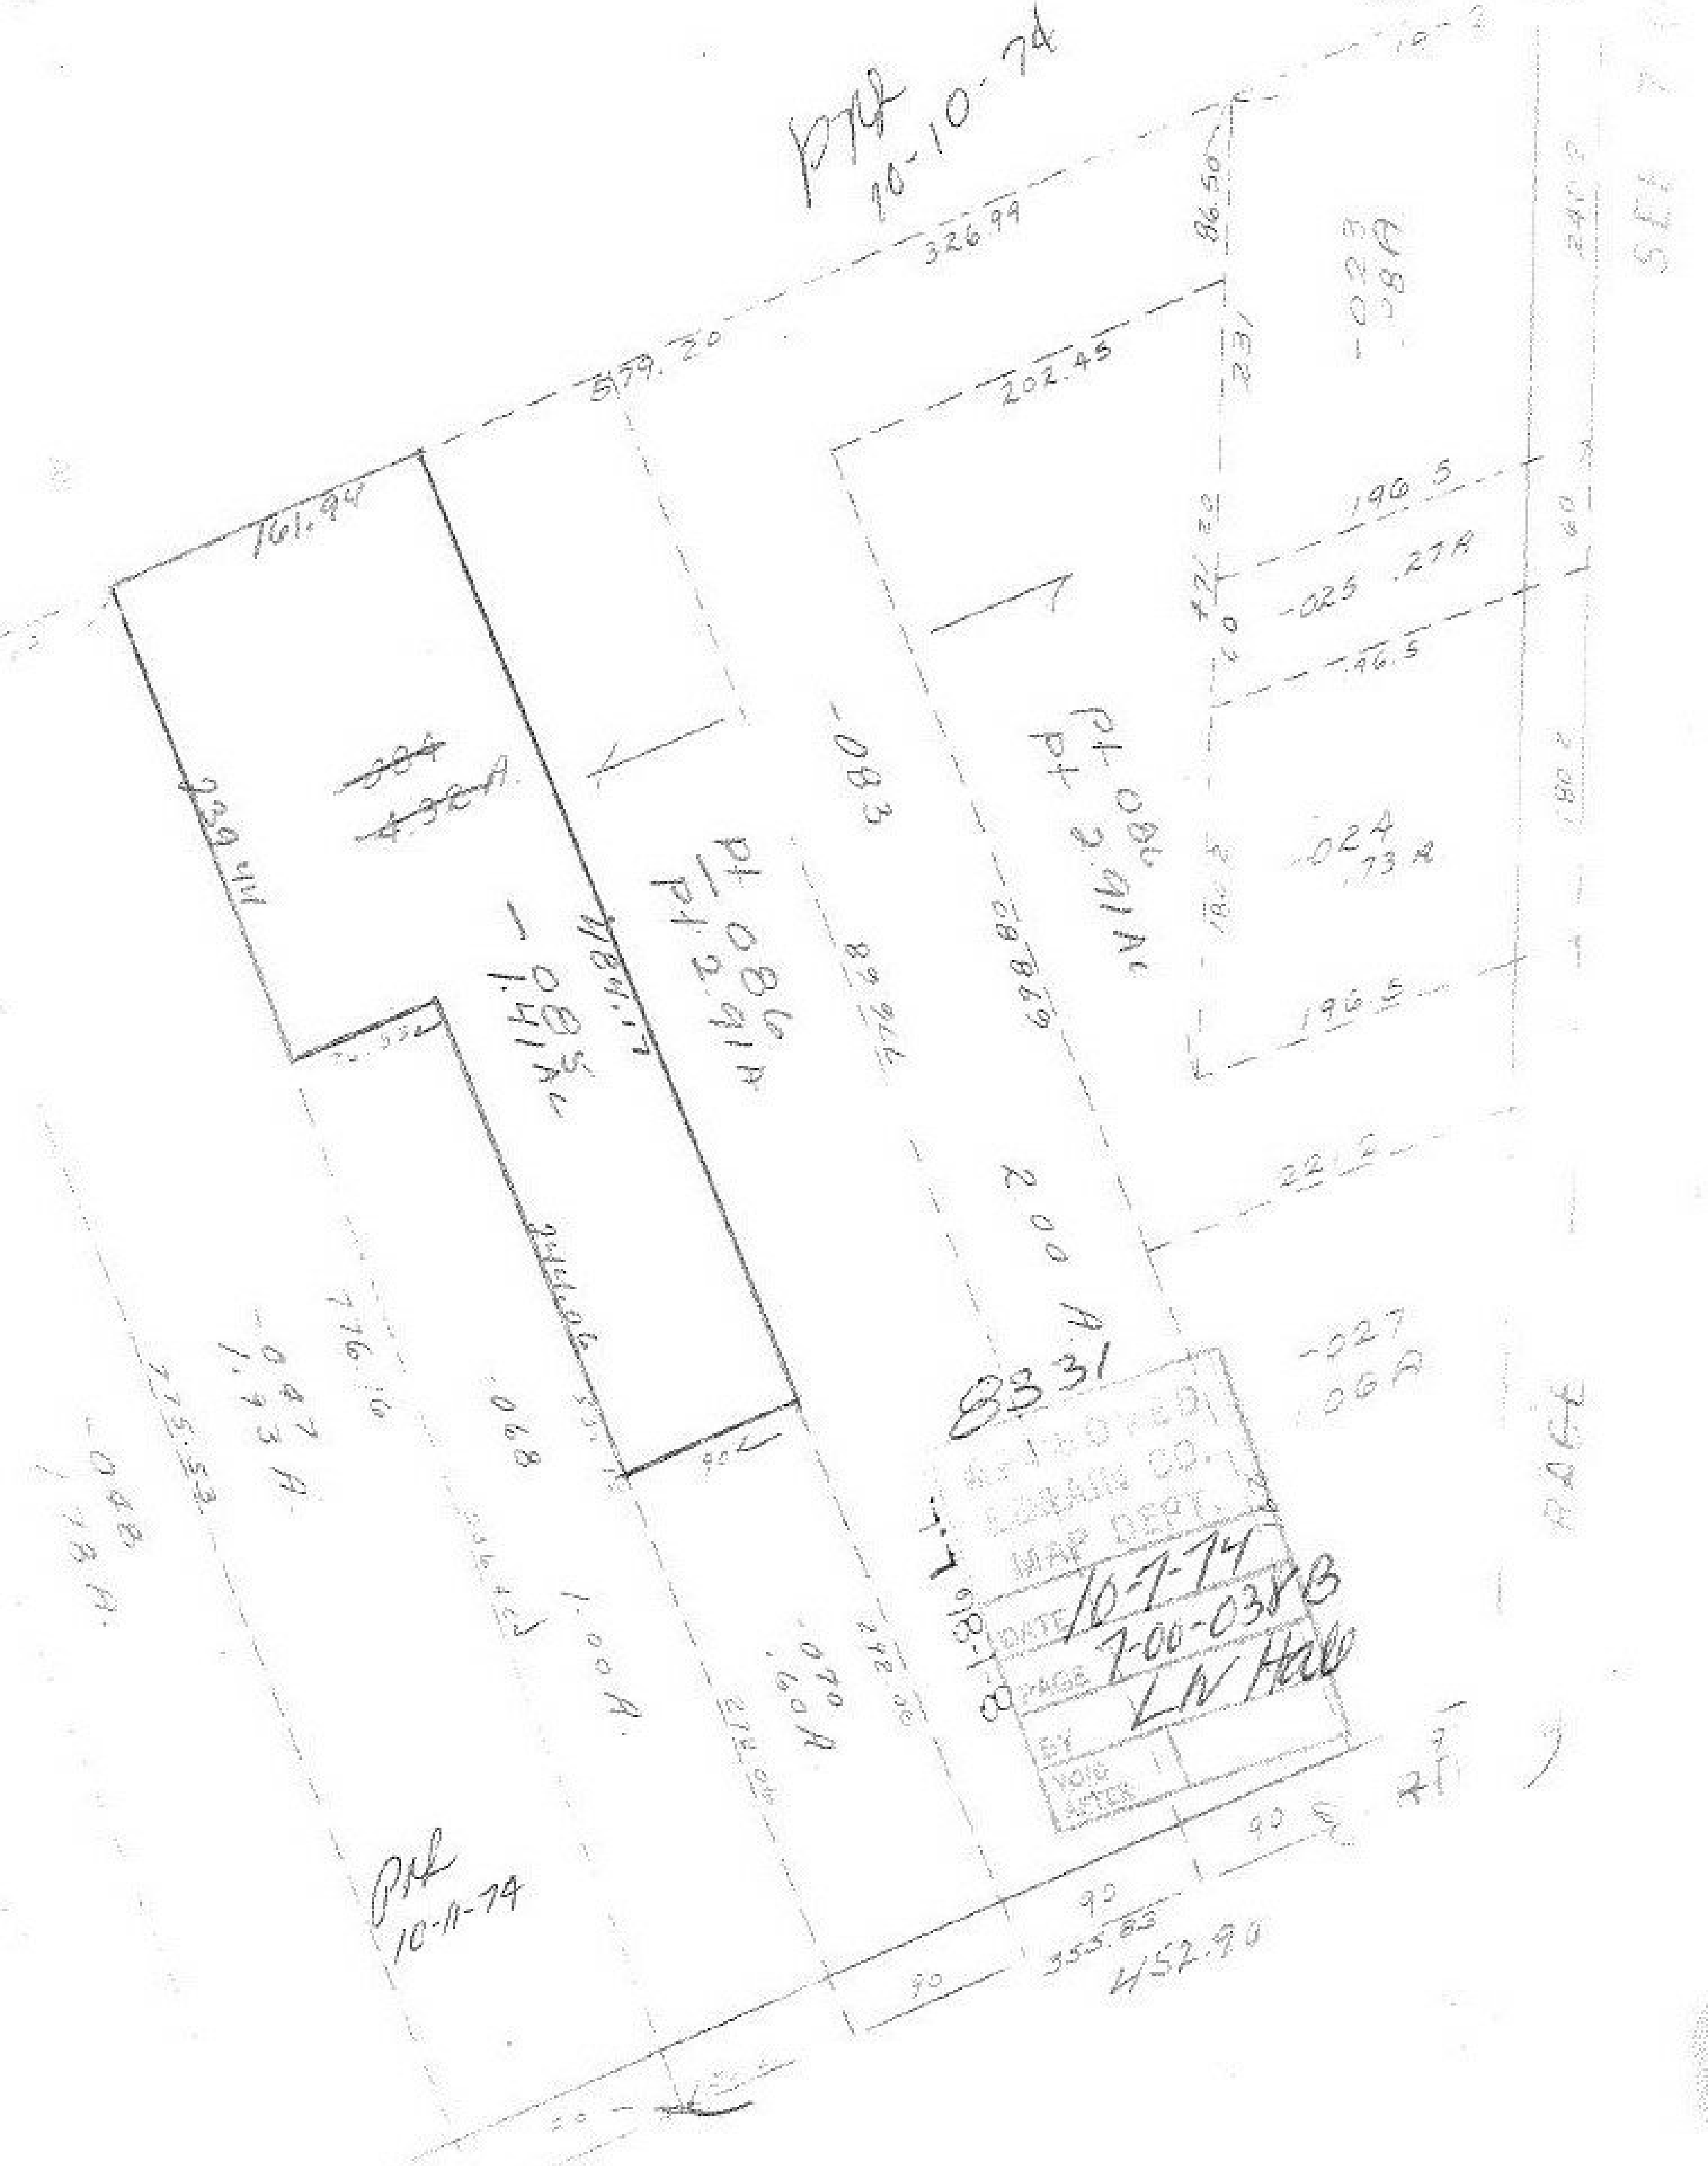

PRR 10-10-74
326.99
579.20
202.45
86.50
161.94
196.5
-025 .27A
196.5
-083
Pt 086
Pt 2.91A
-085
1.41 Ac
-024
.73A
196.5
200 A
-027
.06A
8331
APPROVED
LORAIN CO.
MAP DEPT.
DATE 10-7-74
PAGE 7-00-038B
BY LN Hall
-087
1.73A
-088
.78A
-068
1.00A
-070
.60A
776.10
775.53
90
90
353.83
452.90
PRR 10-11-74