


Tax Map Dept Exp  
8334

PAZ  
10-10-74  
PAZ  
10-11-74

SEE 2-01-006-C

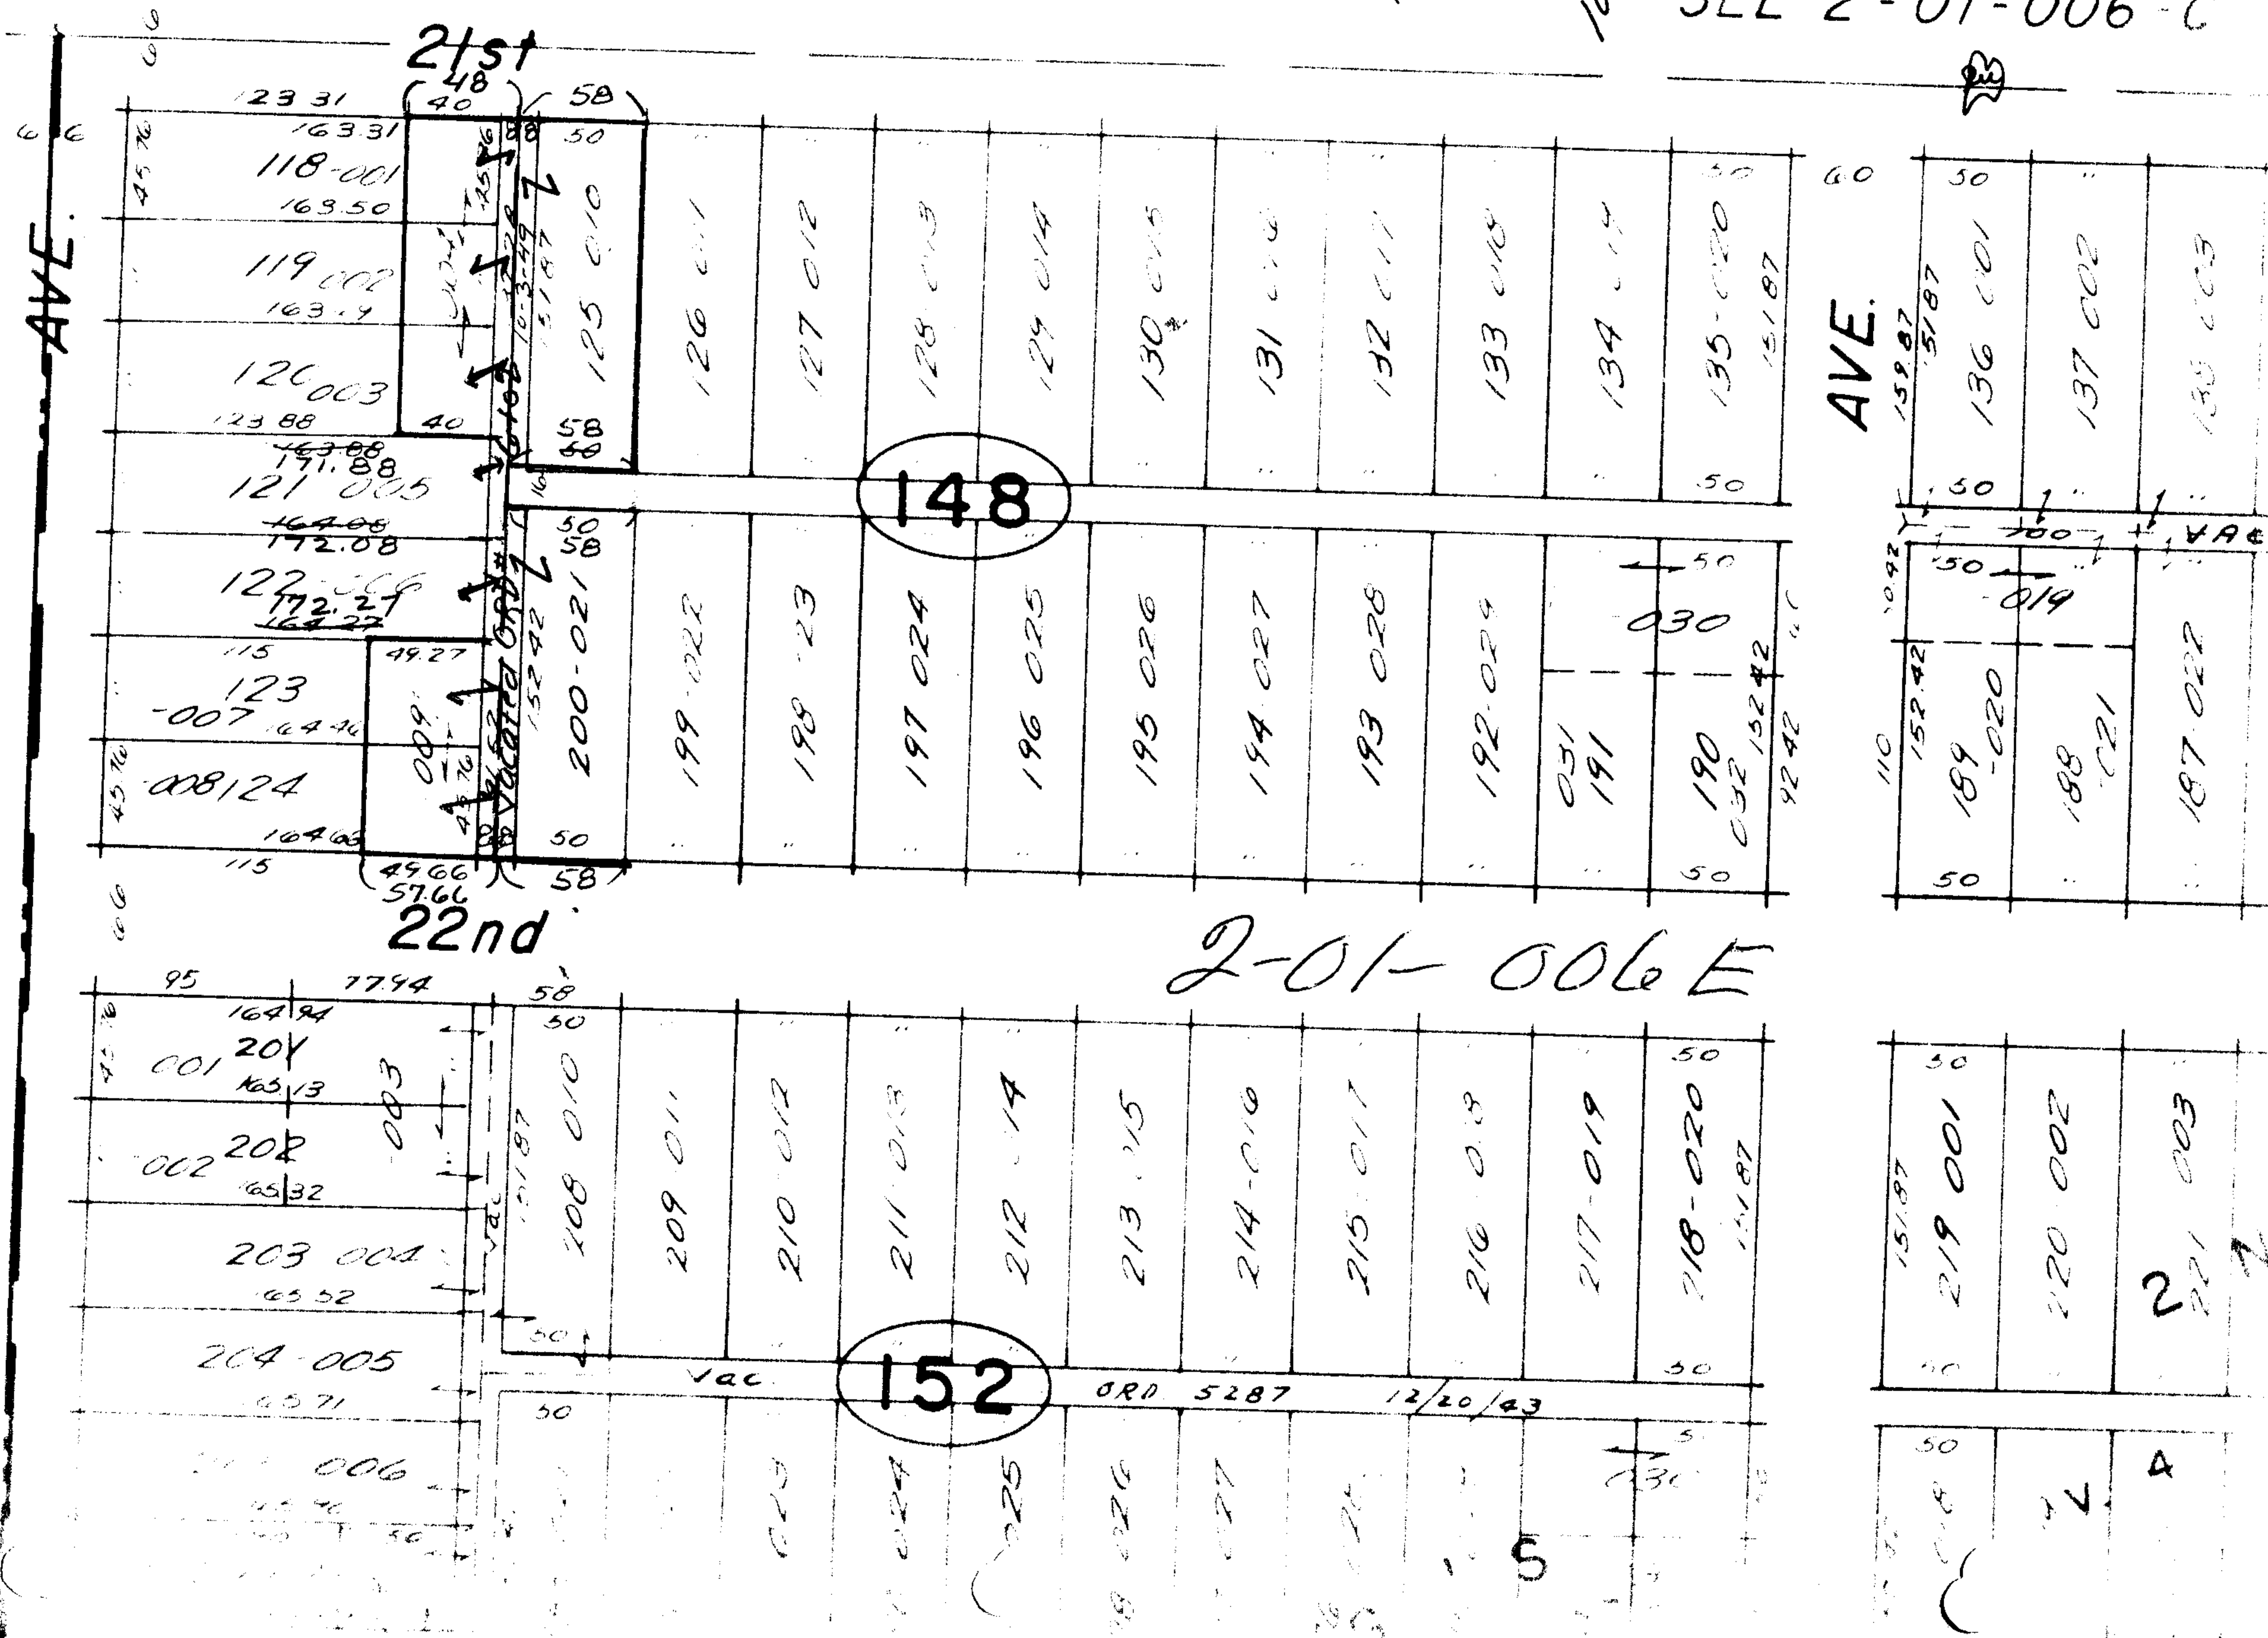

2-01-006E