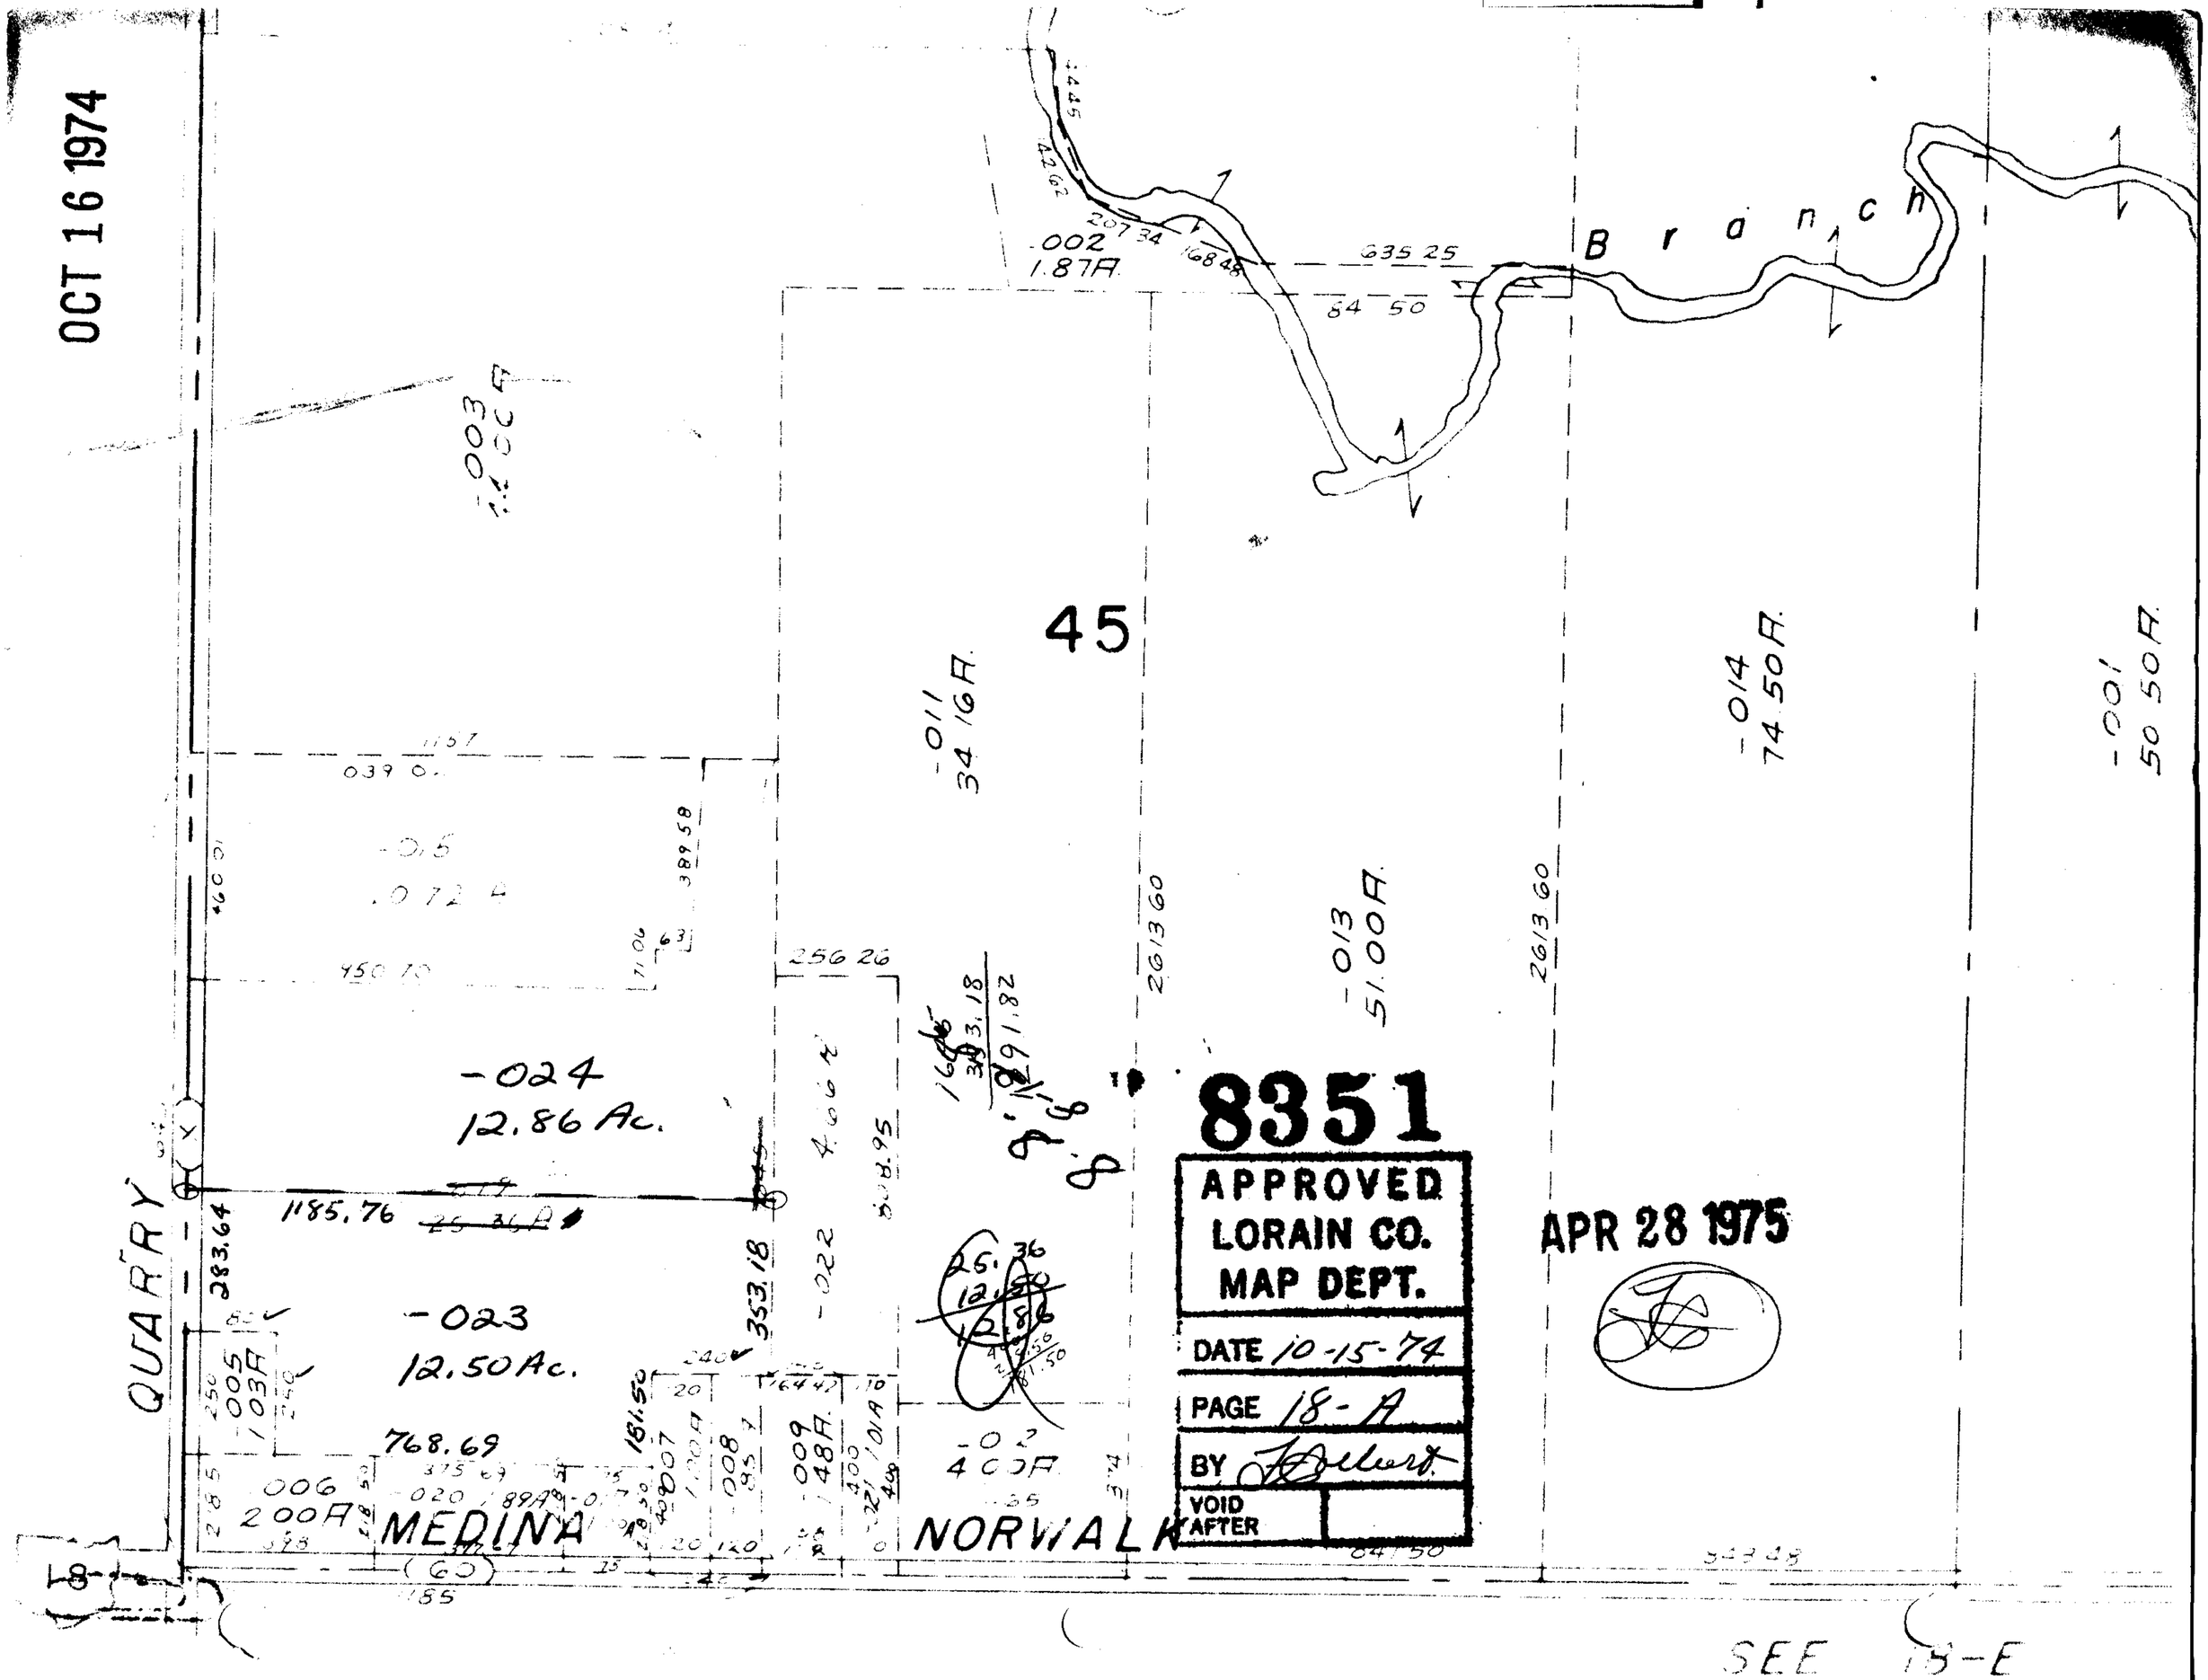
OCT 16 1974
Branch
45
-011
34.16A.
-014
74.50A.
-001
50.50A.
-013
51.00A.
-024
12.86 Ac.
-023
12.50 Ac.
-002
1.87A.
-005
1.03A
-006
2.00A
-009
1.48A.
-022
-02
4.00A
QUARRY
MEDINA
NORWALK
8351
APPROVED
LORAIN CO.
MAP DEPT.
DATE 10-15-74
PAGE 18-A
BY
VOID AFTER
APR 28 1975
SEE 18-E