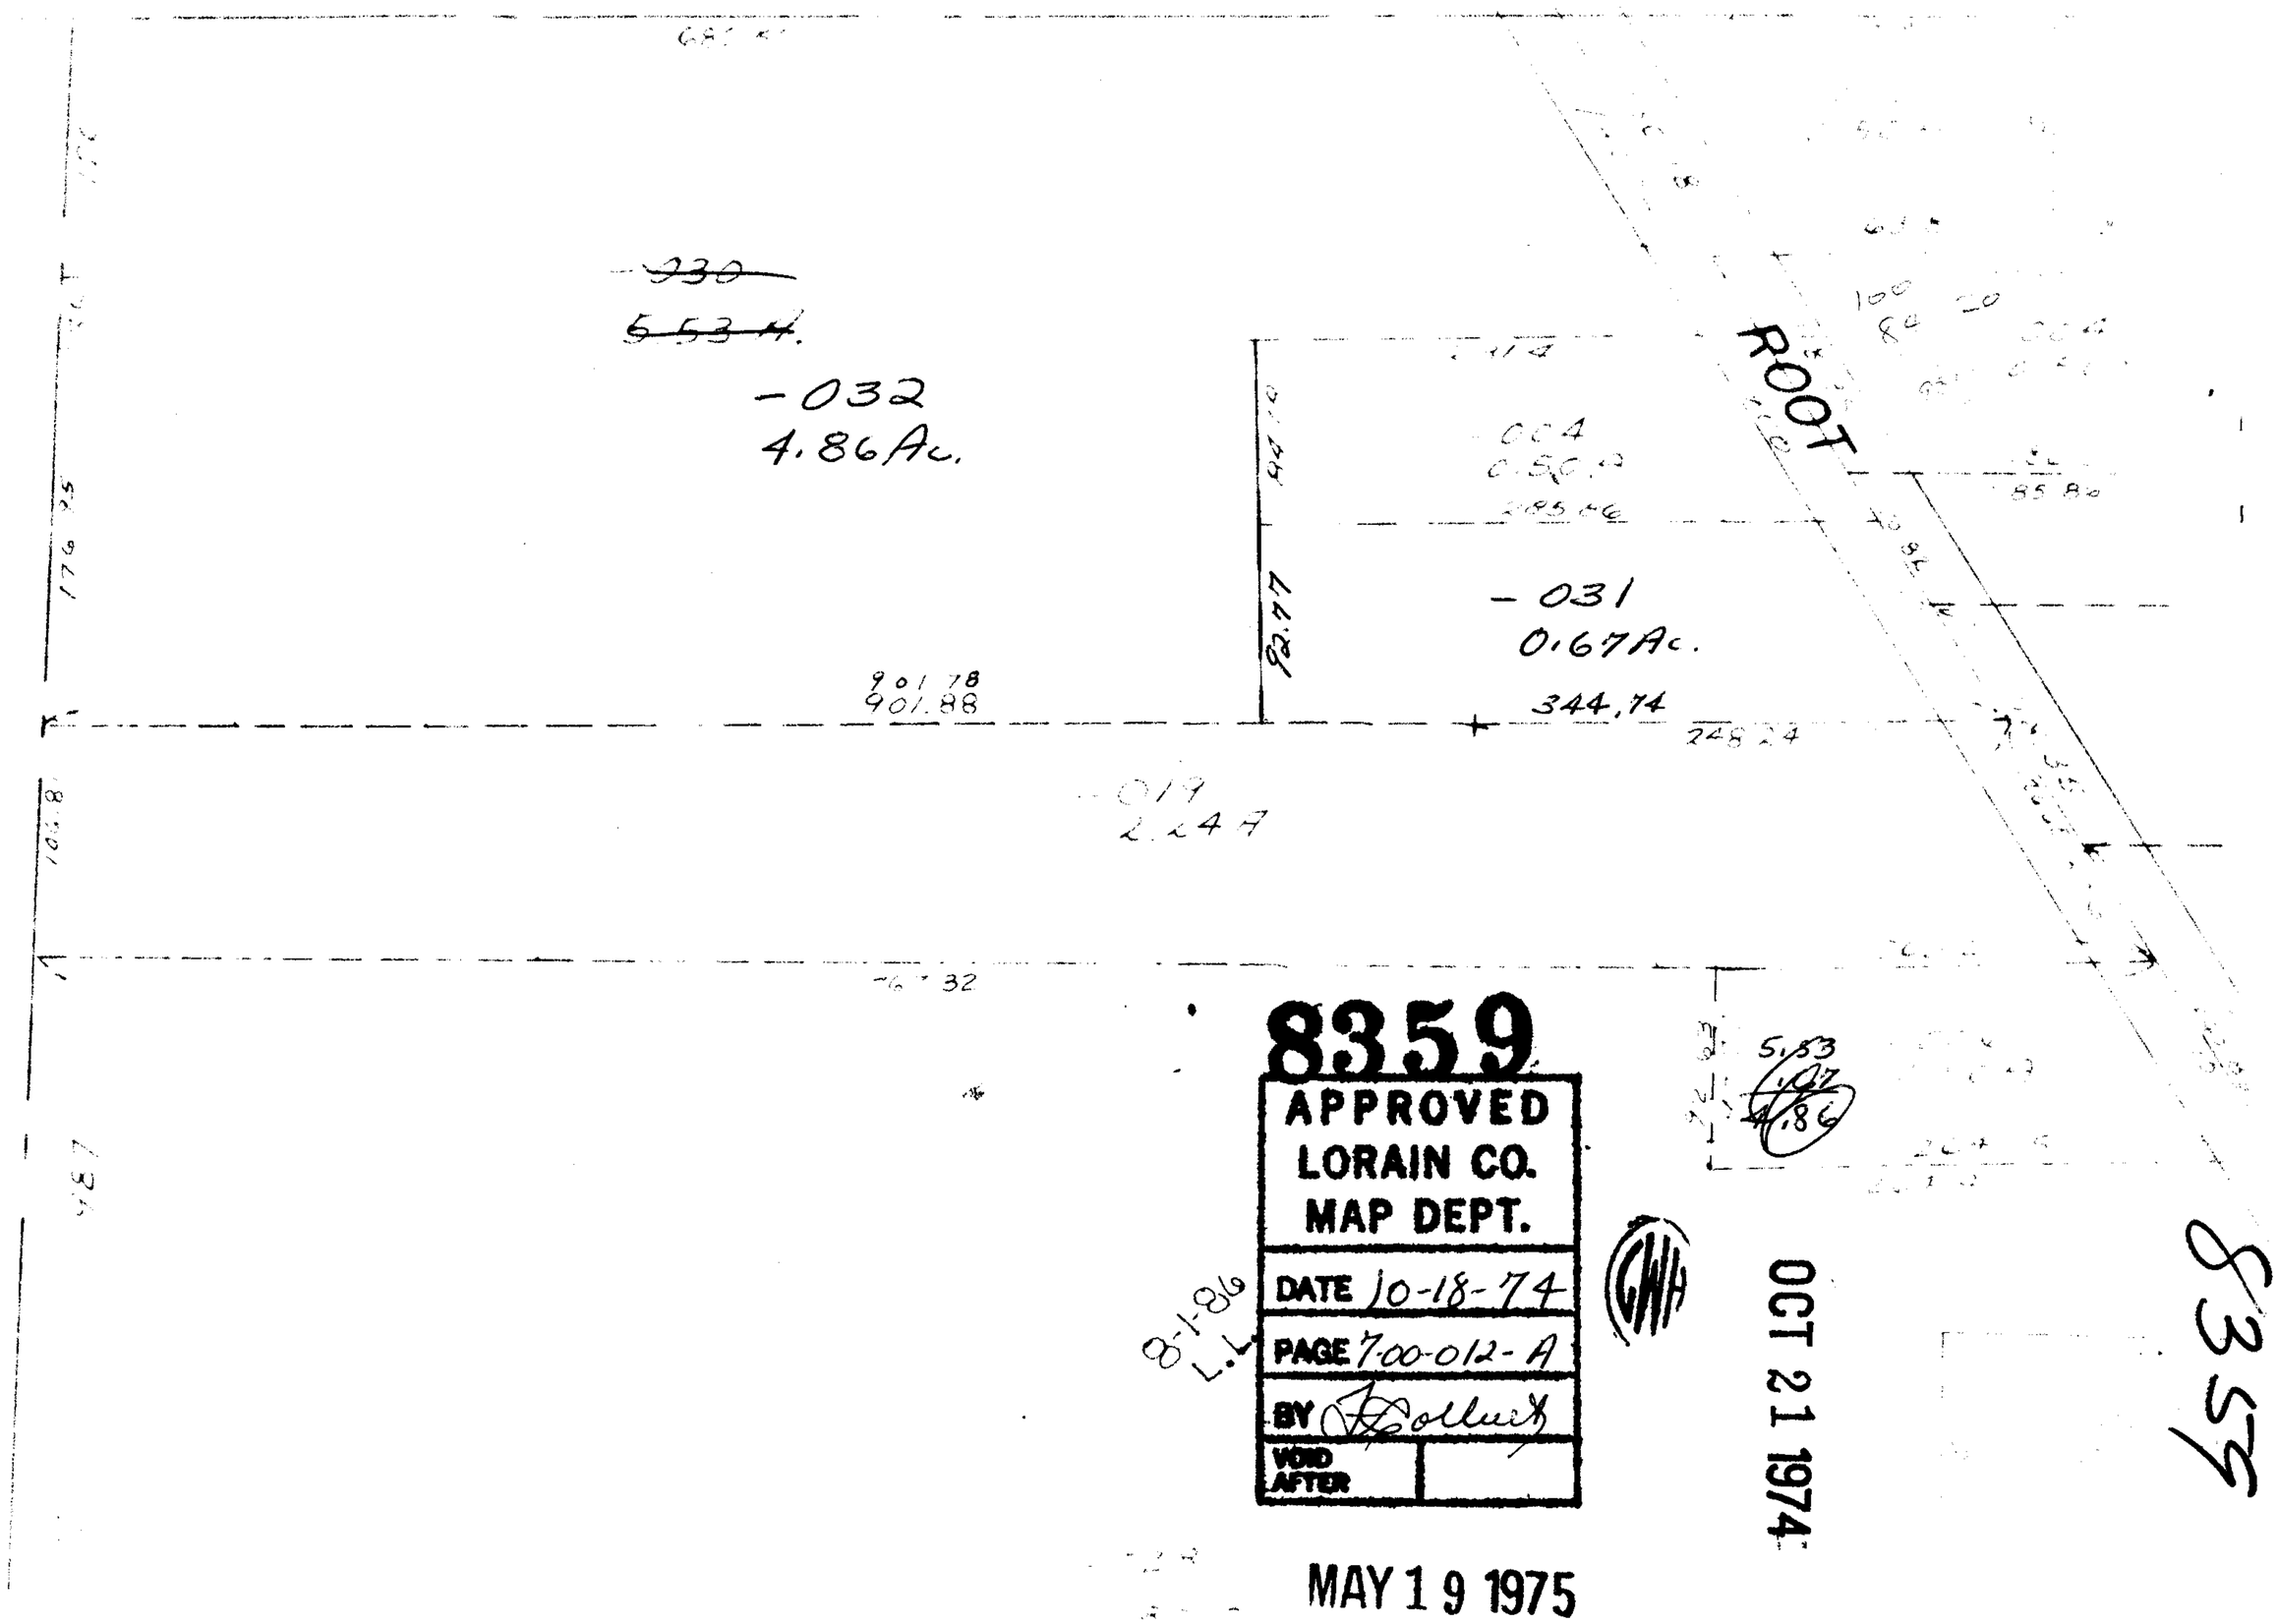

~~030~~
~~5.53 A.~~
-032
4.86 Ac.
-031
0.67 Ac.
344.74
248.24
92.77
901.78
901.88
-019
2.24 A
ROOT
5.53
.07
4.86
8359
APPROVED
LORAIN CO.
MAP DEPT.
DATE 10-18-74
PAGE 7-00-012-A
BY
VOID AFTER
8-1-86
L.L.
OCT 21 1974
MAY 19 1975
8359