

8363

E r i e

OCT 23 1974


APPROVED
TOWN CL.
MAP DEPT.

DATE 10-23-74

1100-002A
L W Hall

(Signature)

APR 16 1975

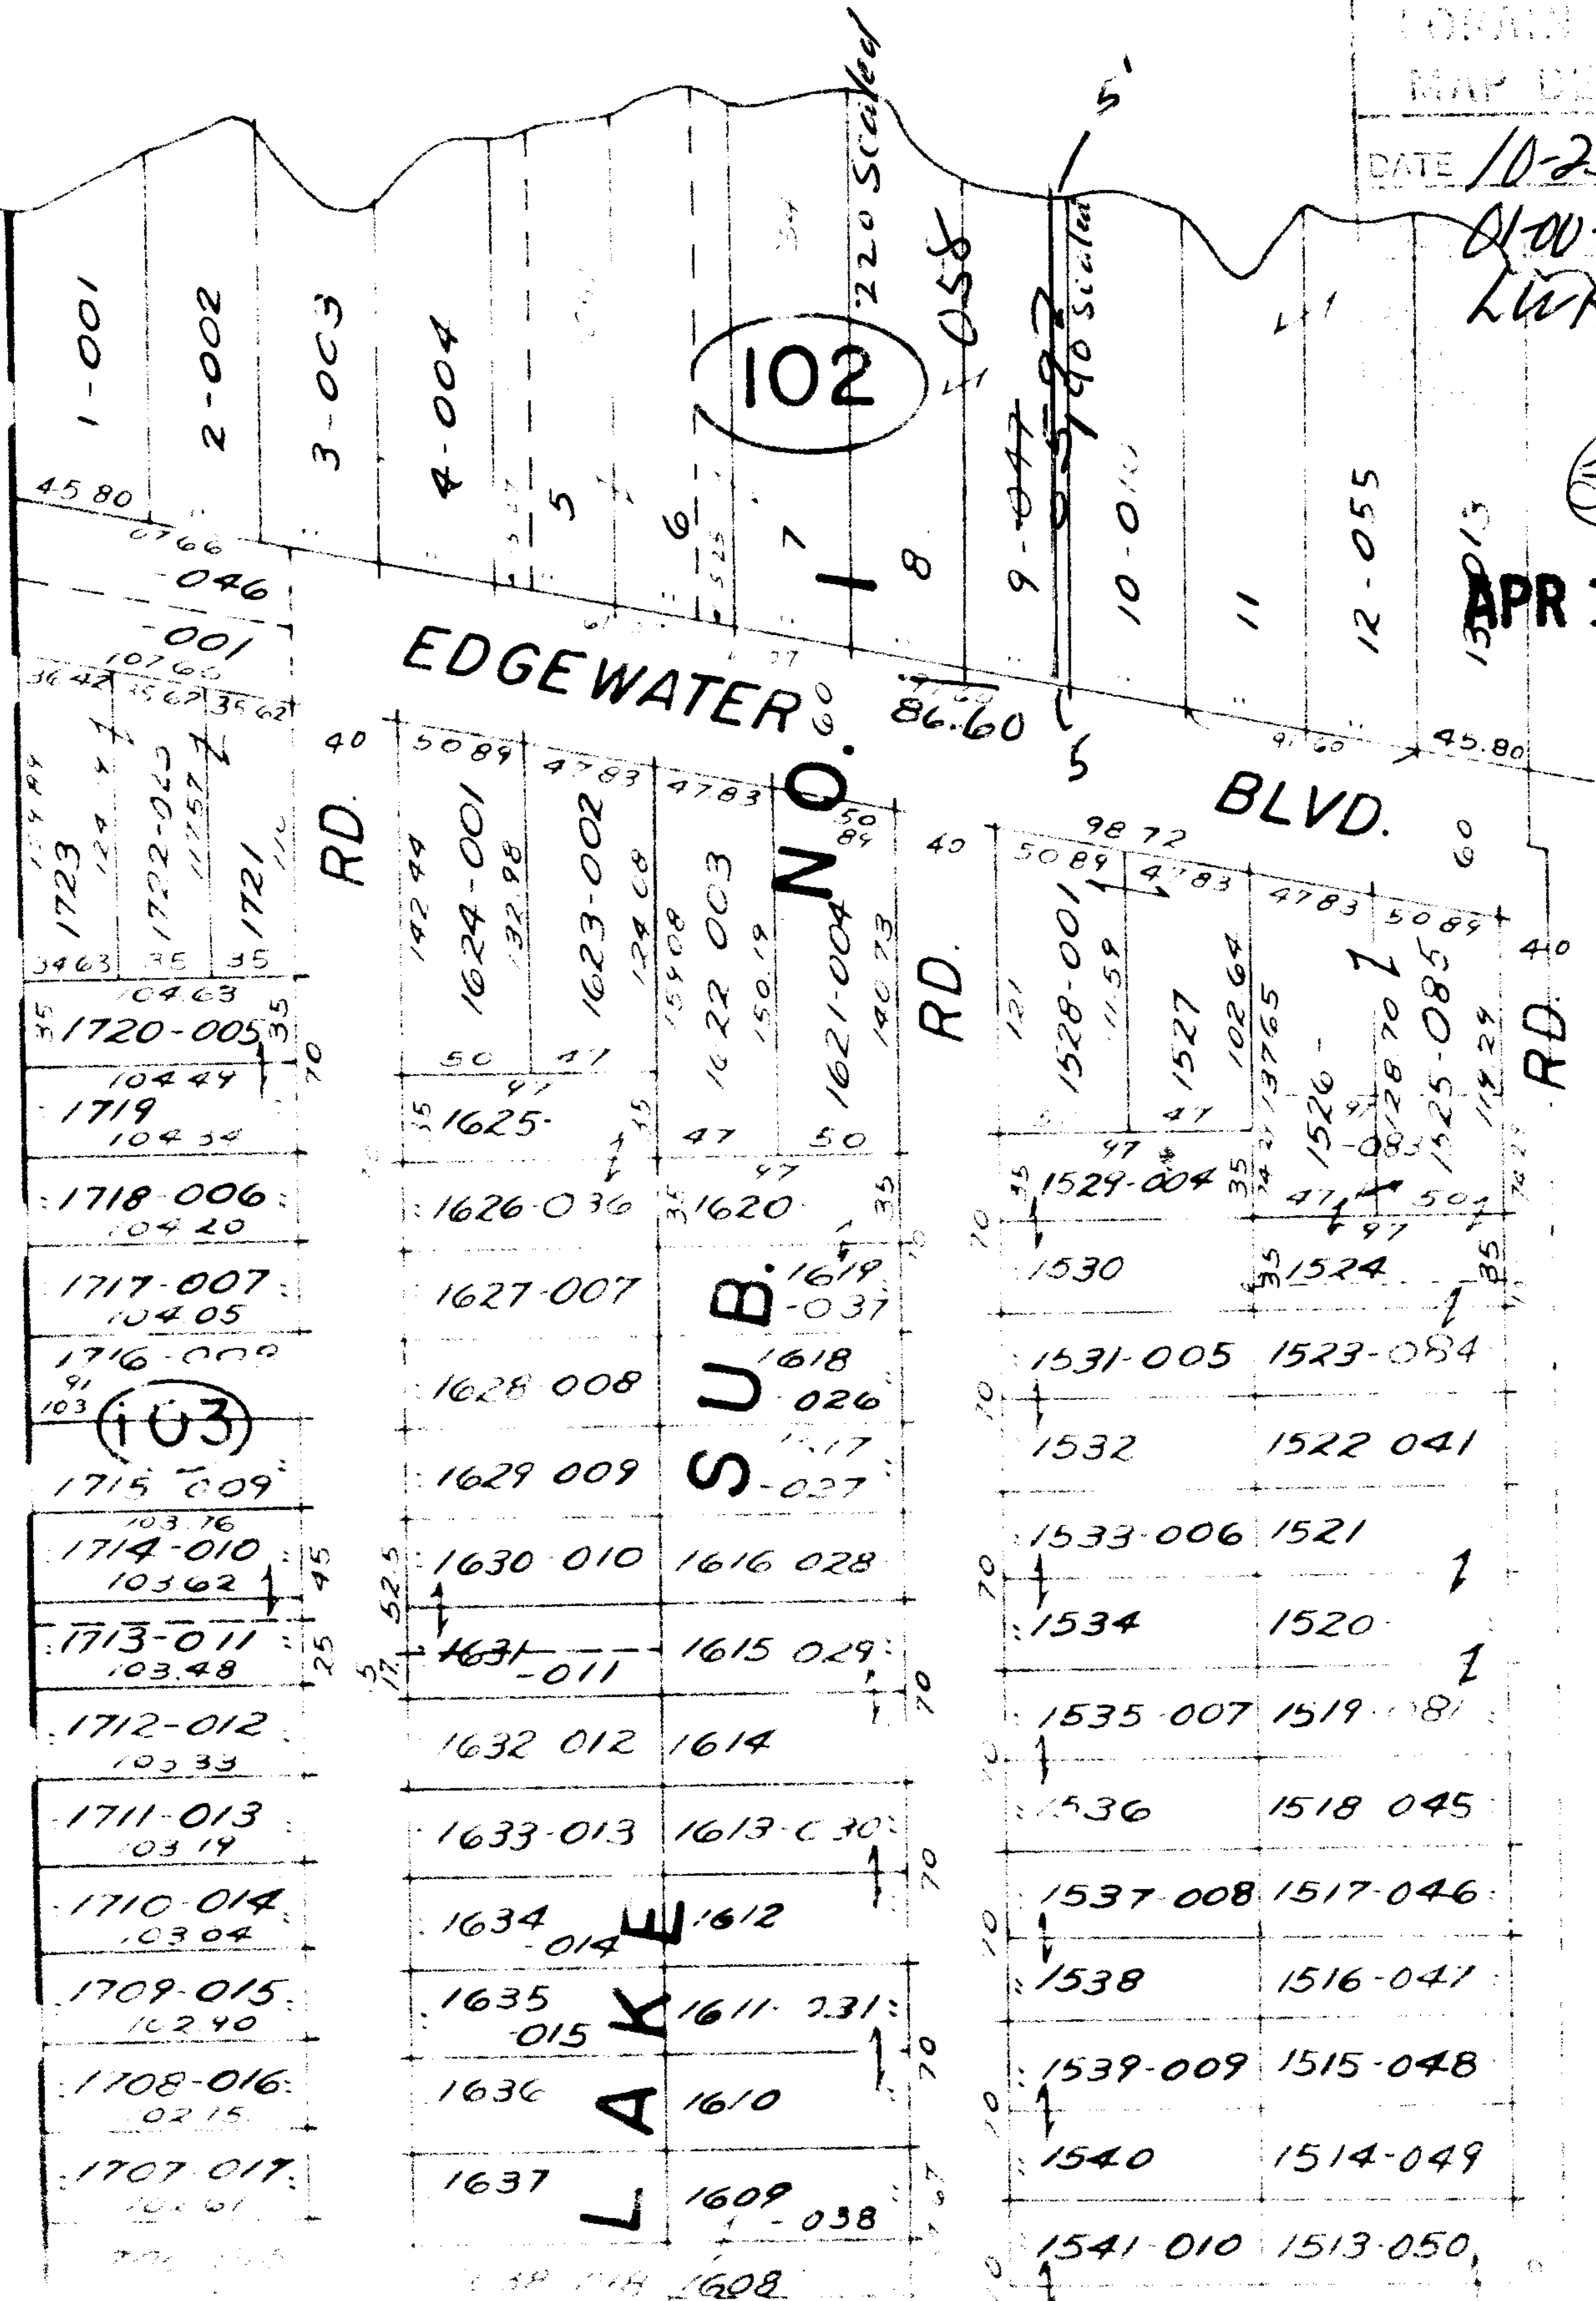

150

()

()