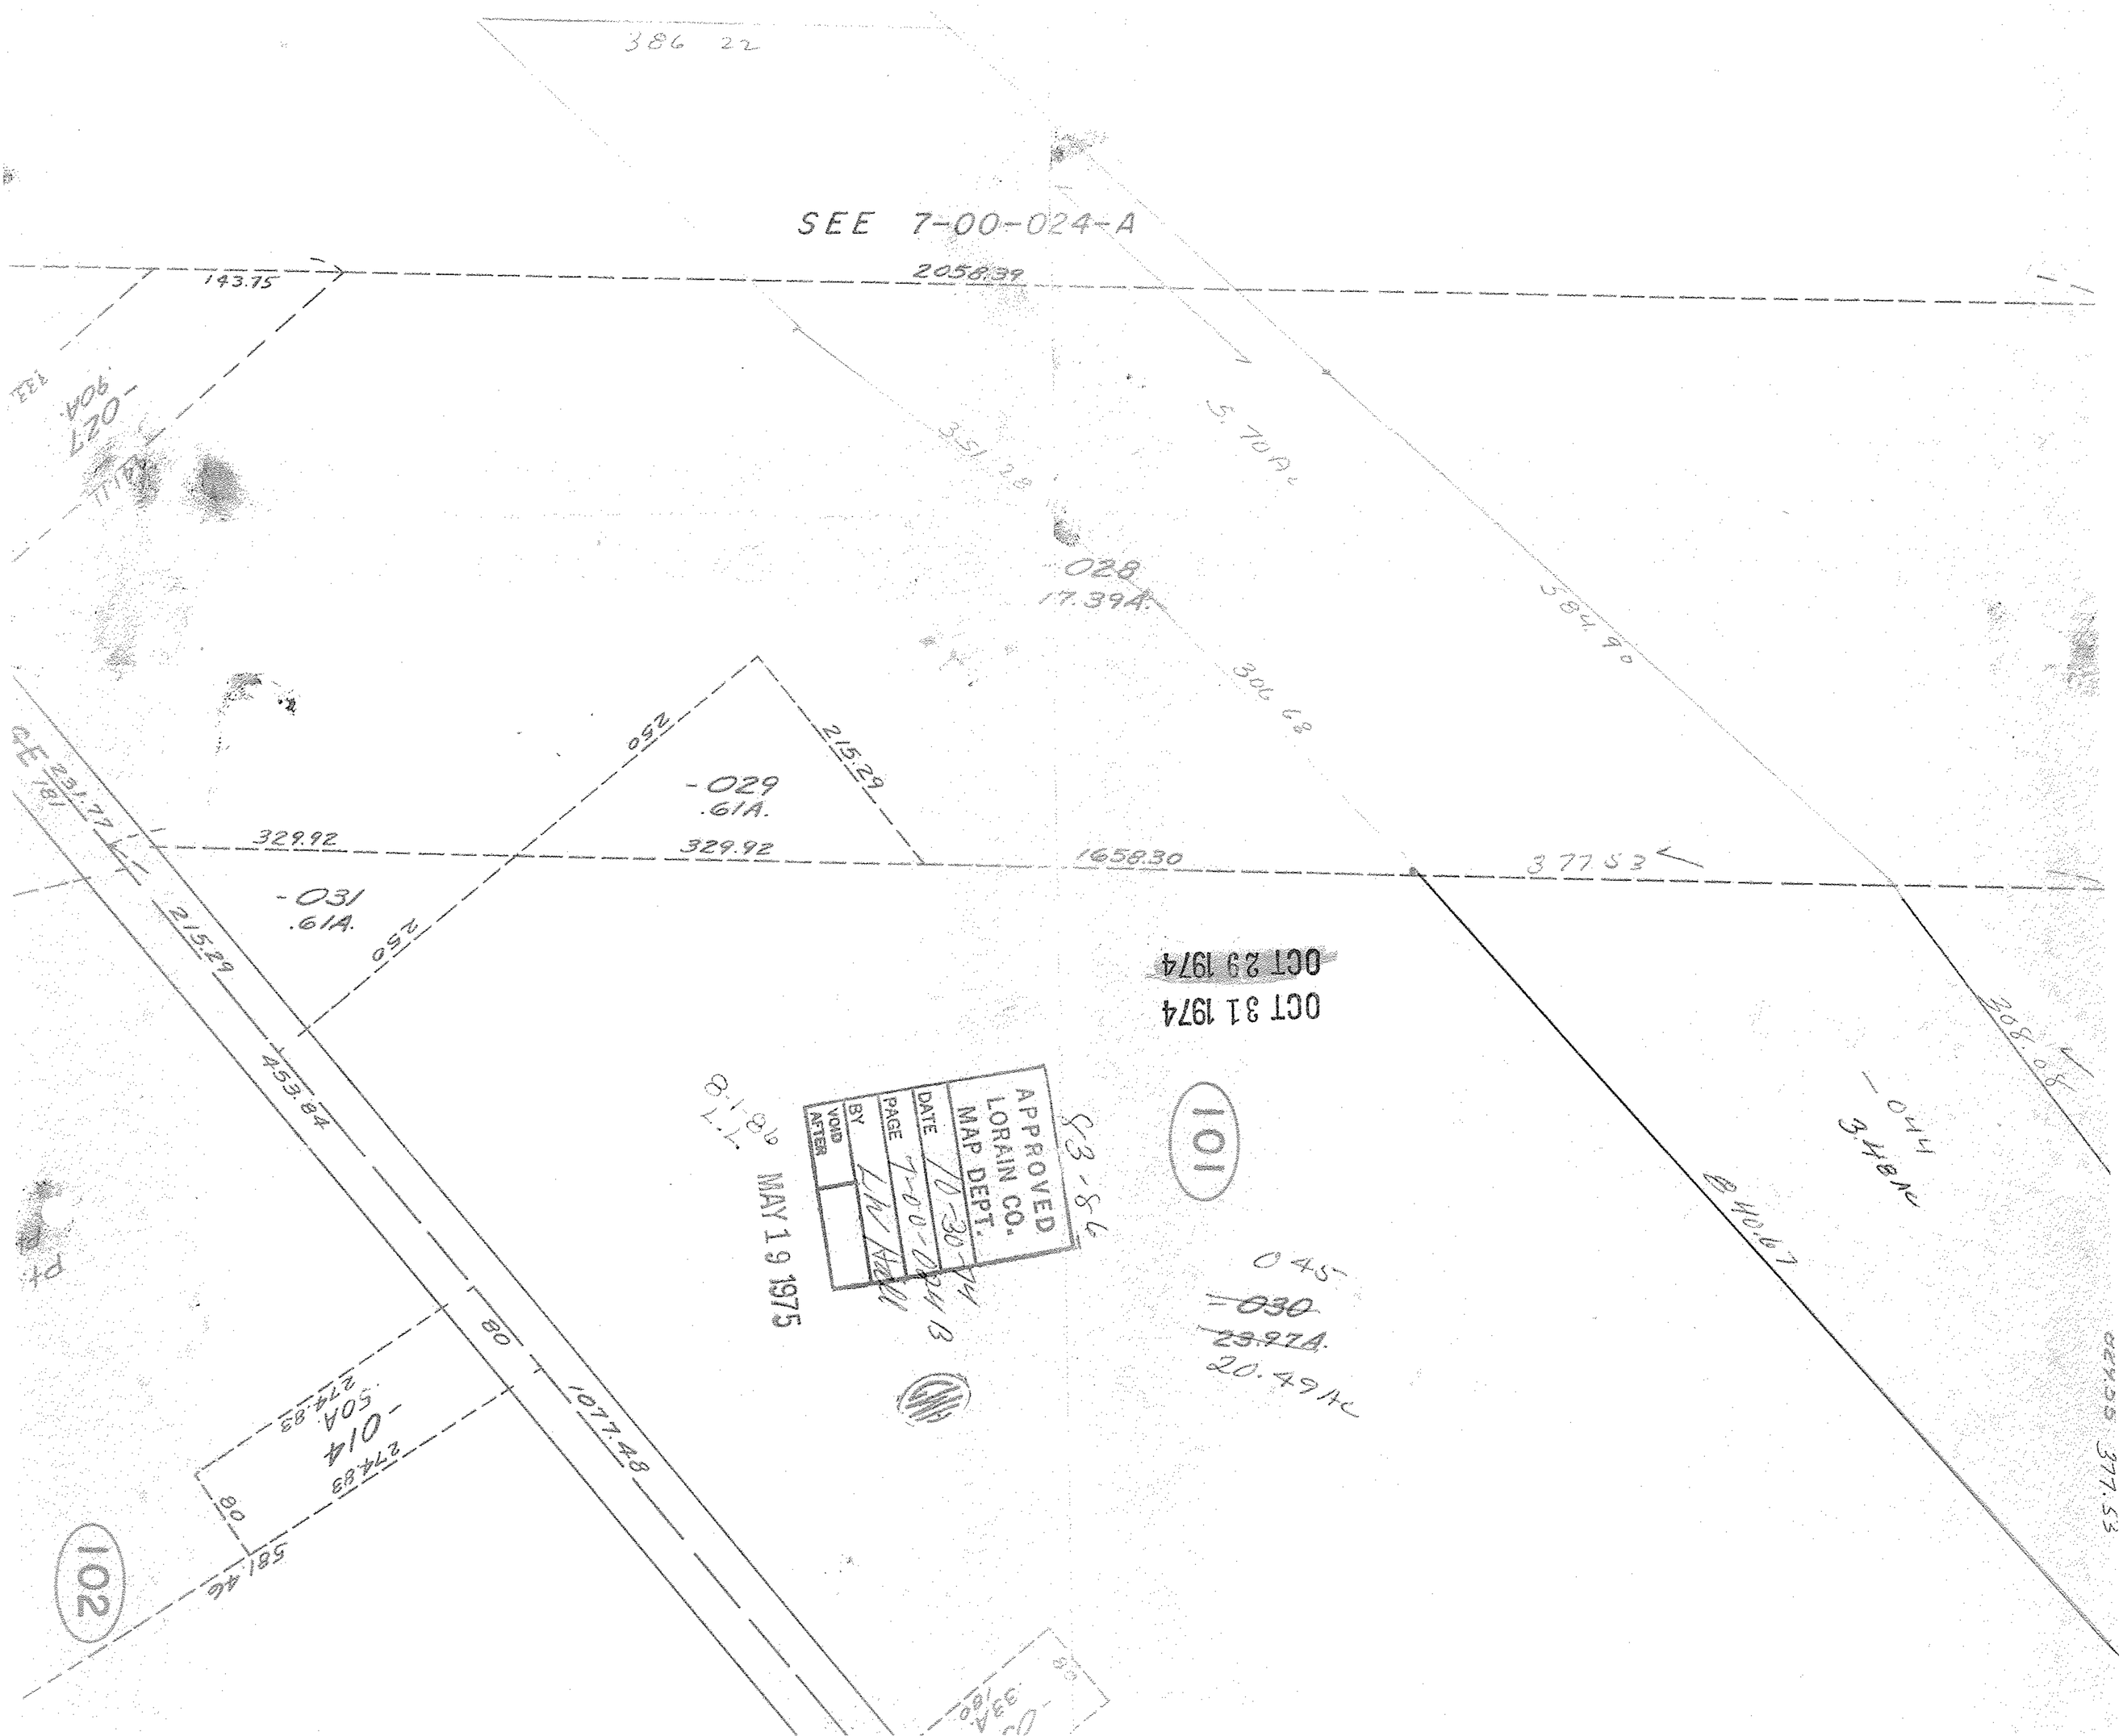#8386
7-00-024D