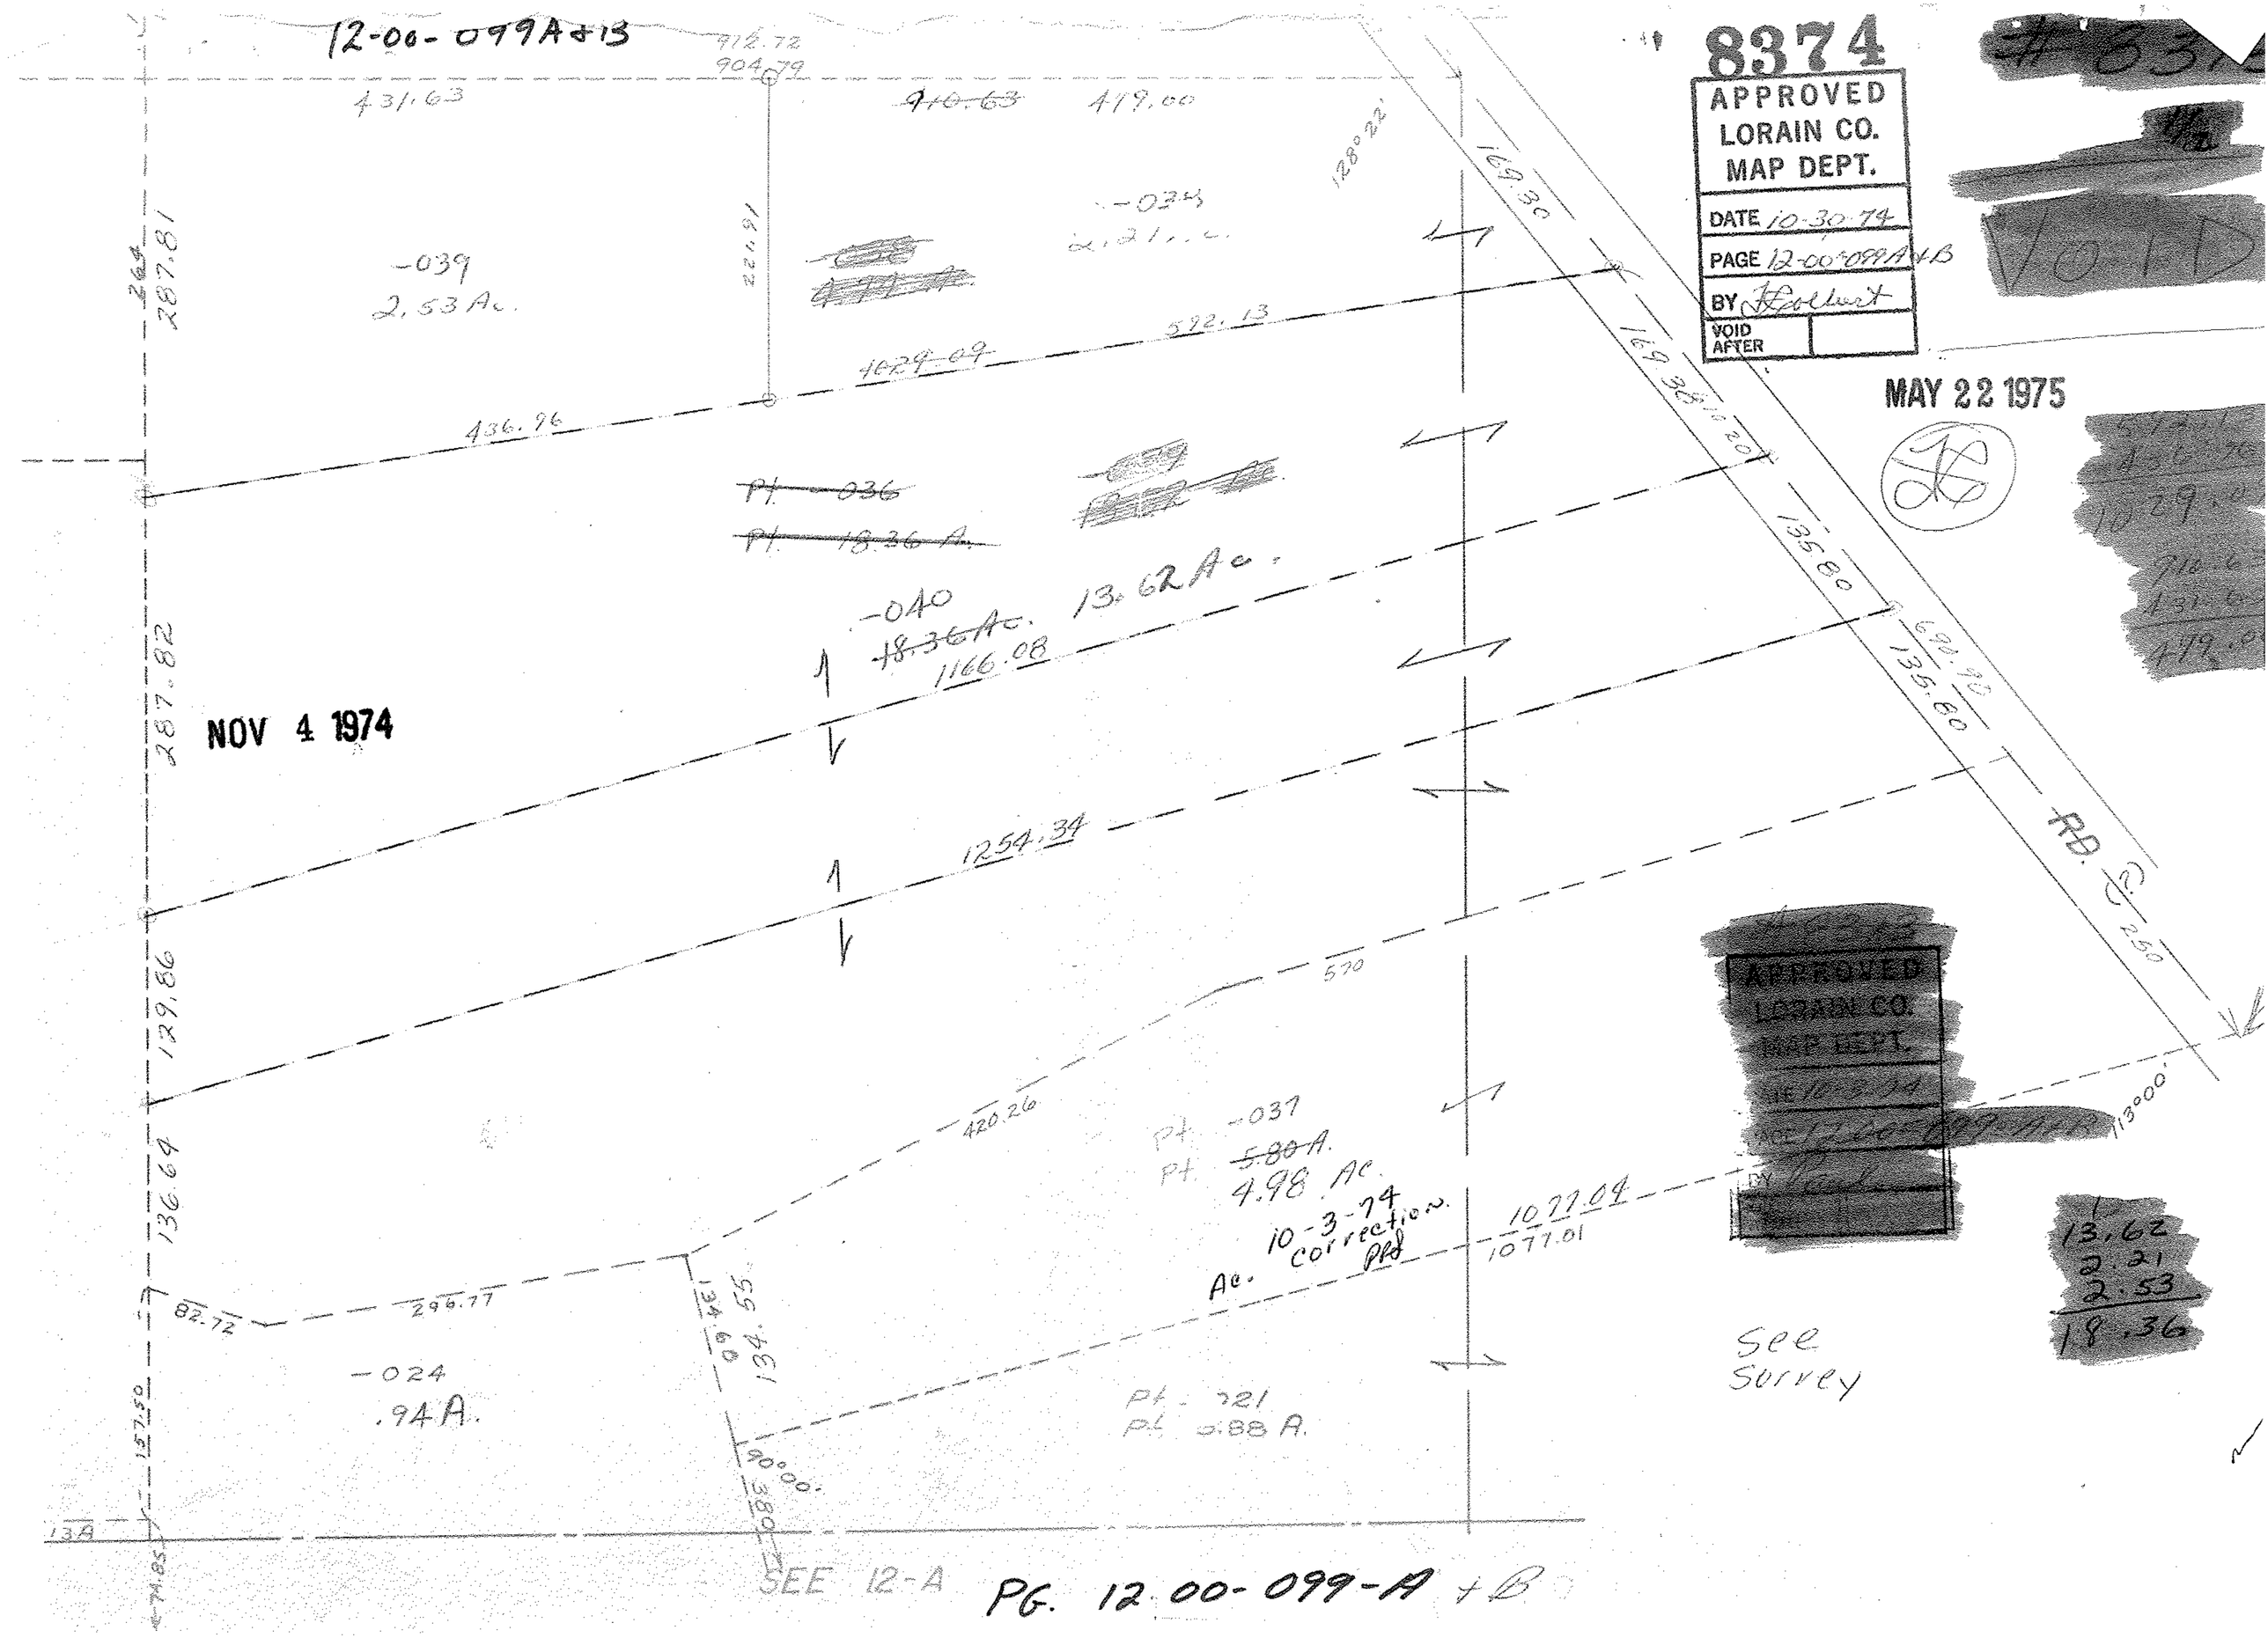
12-00-099A+B
8374
APPROVED
LORAIN CO.
MAP DEPT.
DATE 10-30-74
PAGE 12-00-099A+B
BY
VOID AFTER
MAY 22 1975
NOV 4 1974
-039
2.53 Ac.
-034
2.21 Ac.
-040
18.36 Ac.
13.62 Ac.
1166.08
1254.34
-037
5.80 A.
4.98 Ac.
10-3-74
Ac. correction
-024
.94 A.
See Survey
13.62
2.21
2.53
18.36
SEE 12-A
PG. 12-00-099-A + B