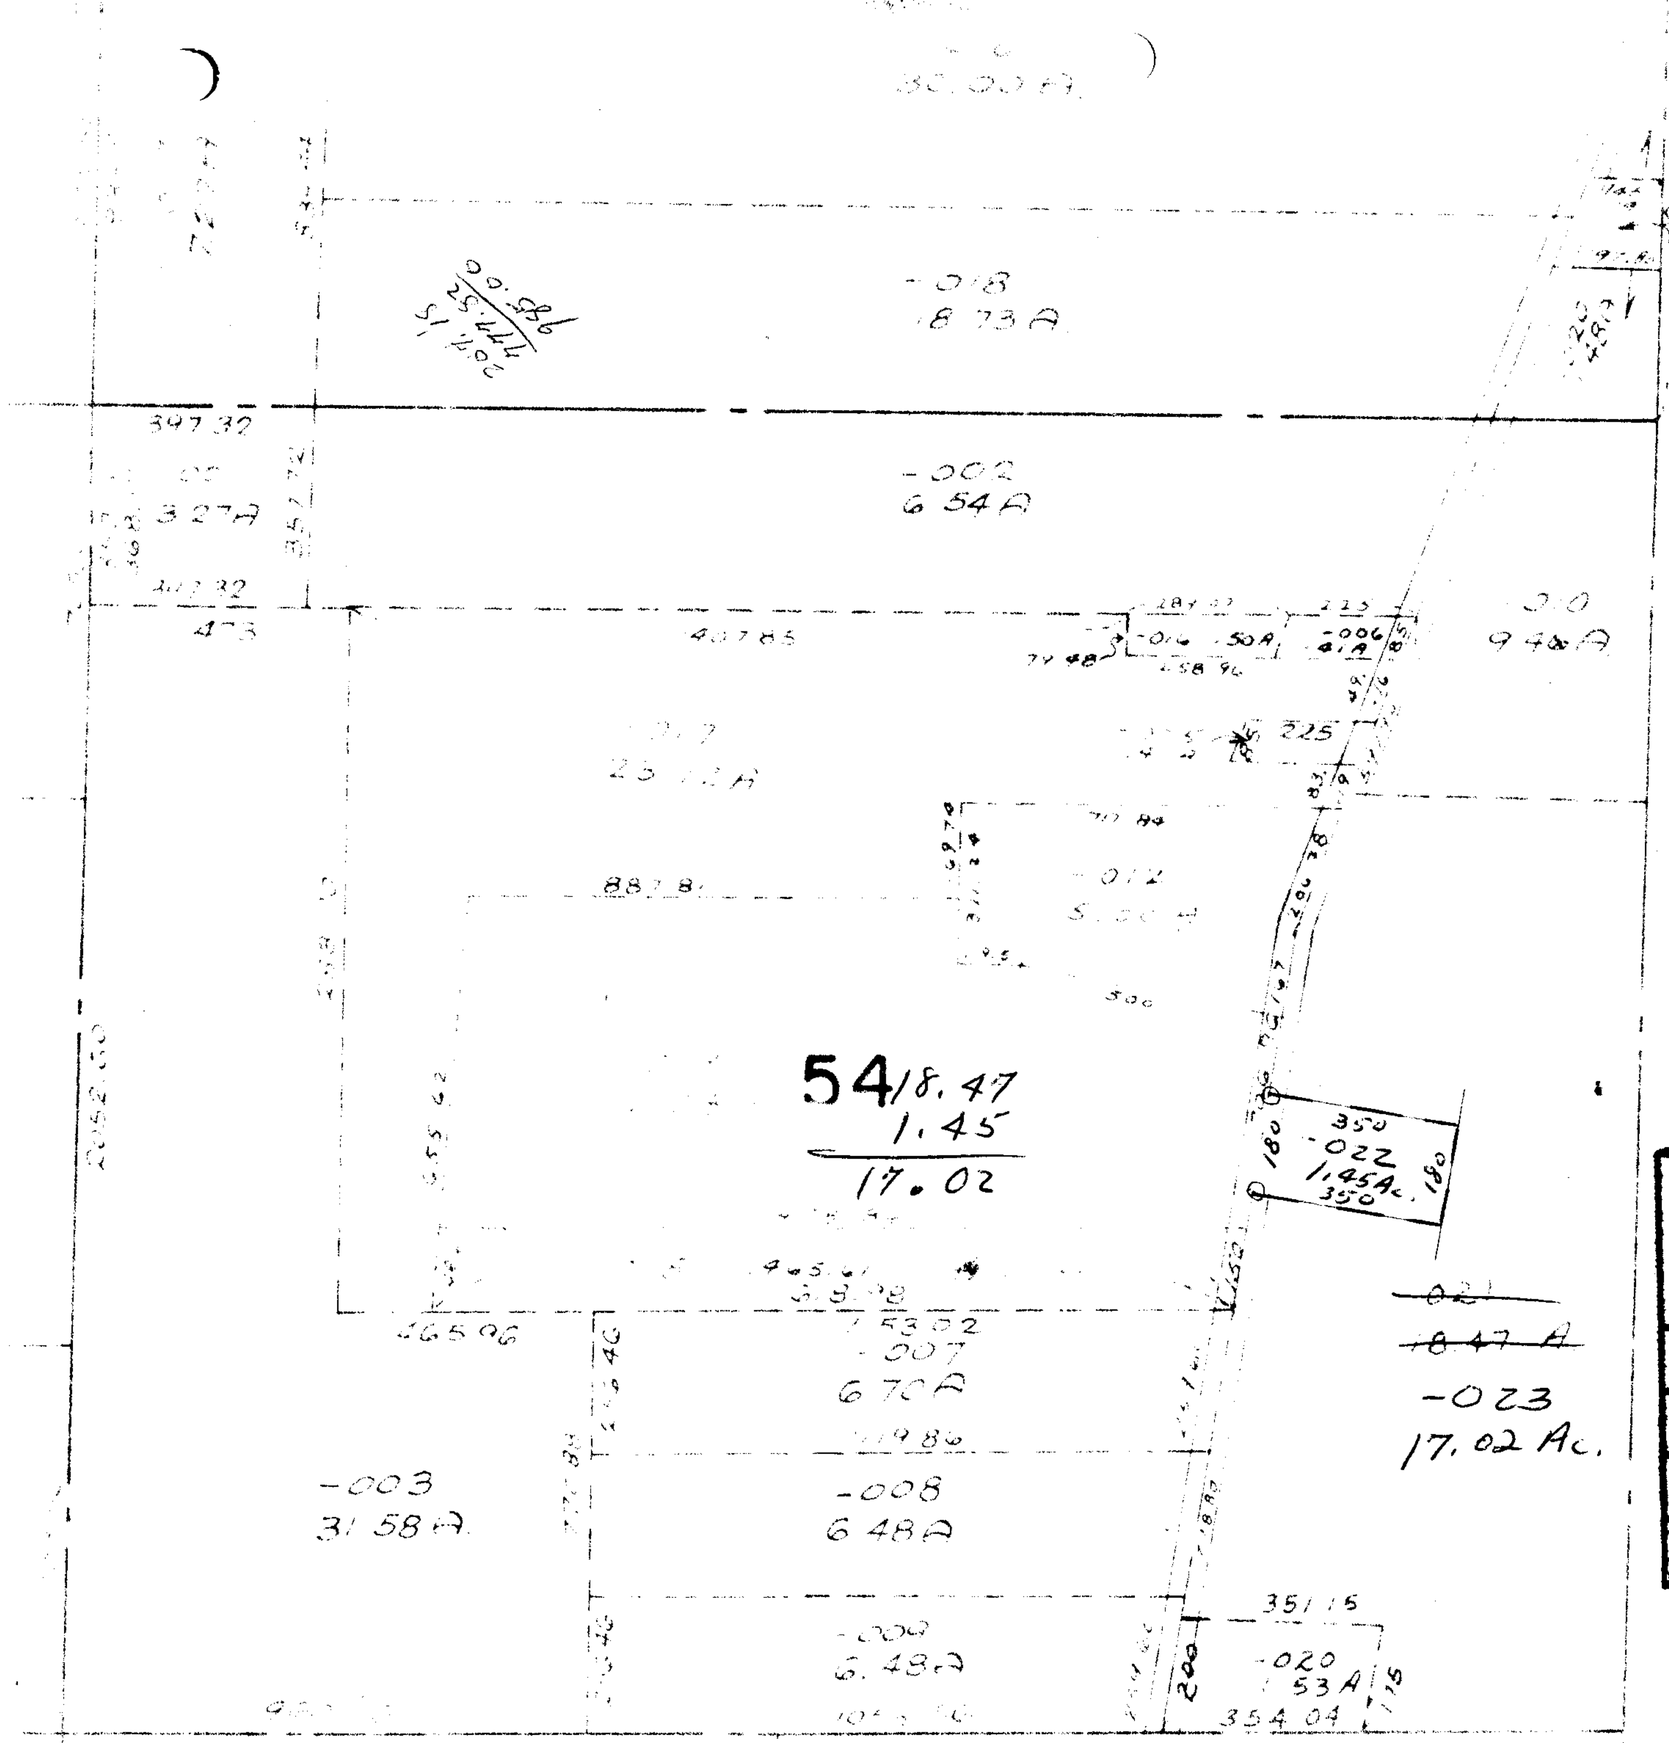

DEC 31 1975

8377

APPROVED
LORAIN CO.
MAP DEPT.
DATE 10-28-74
PAGE 5-G
BY
VOID AFTER

8-186 L.L.

NOV 8 1974