


8382

NOV 12 1974

~~NOV 12 1974~~

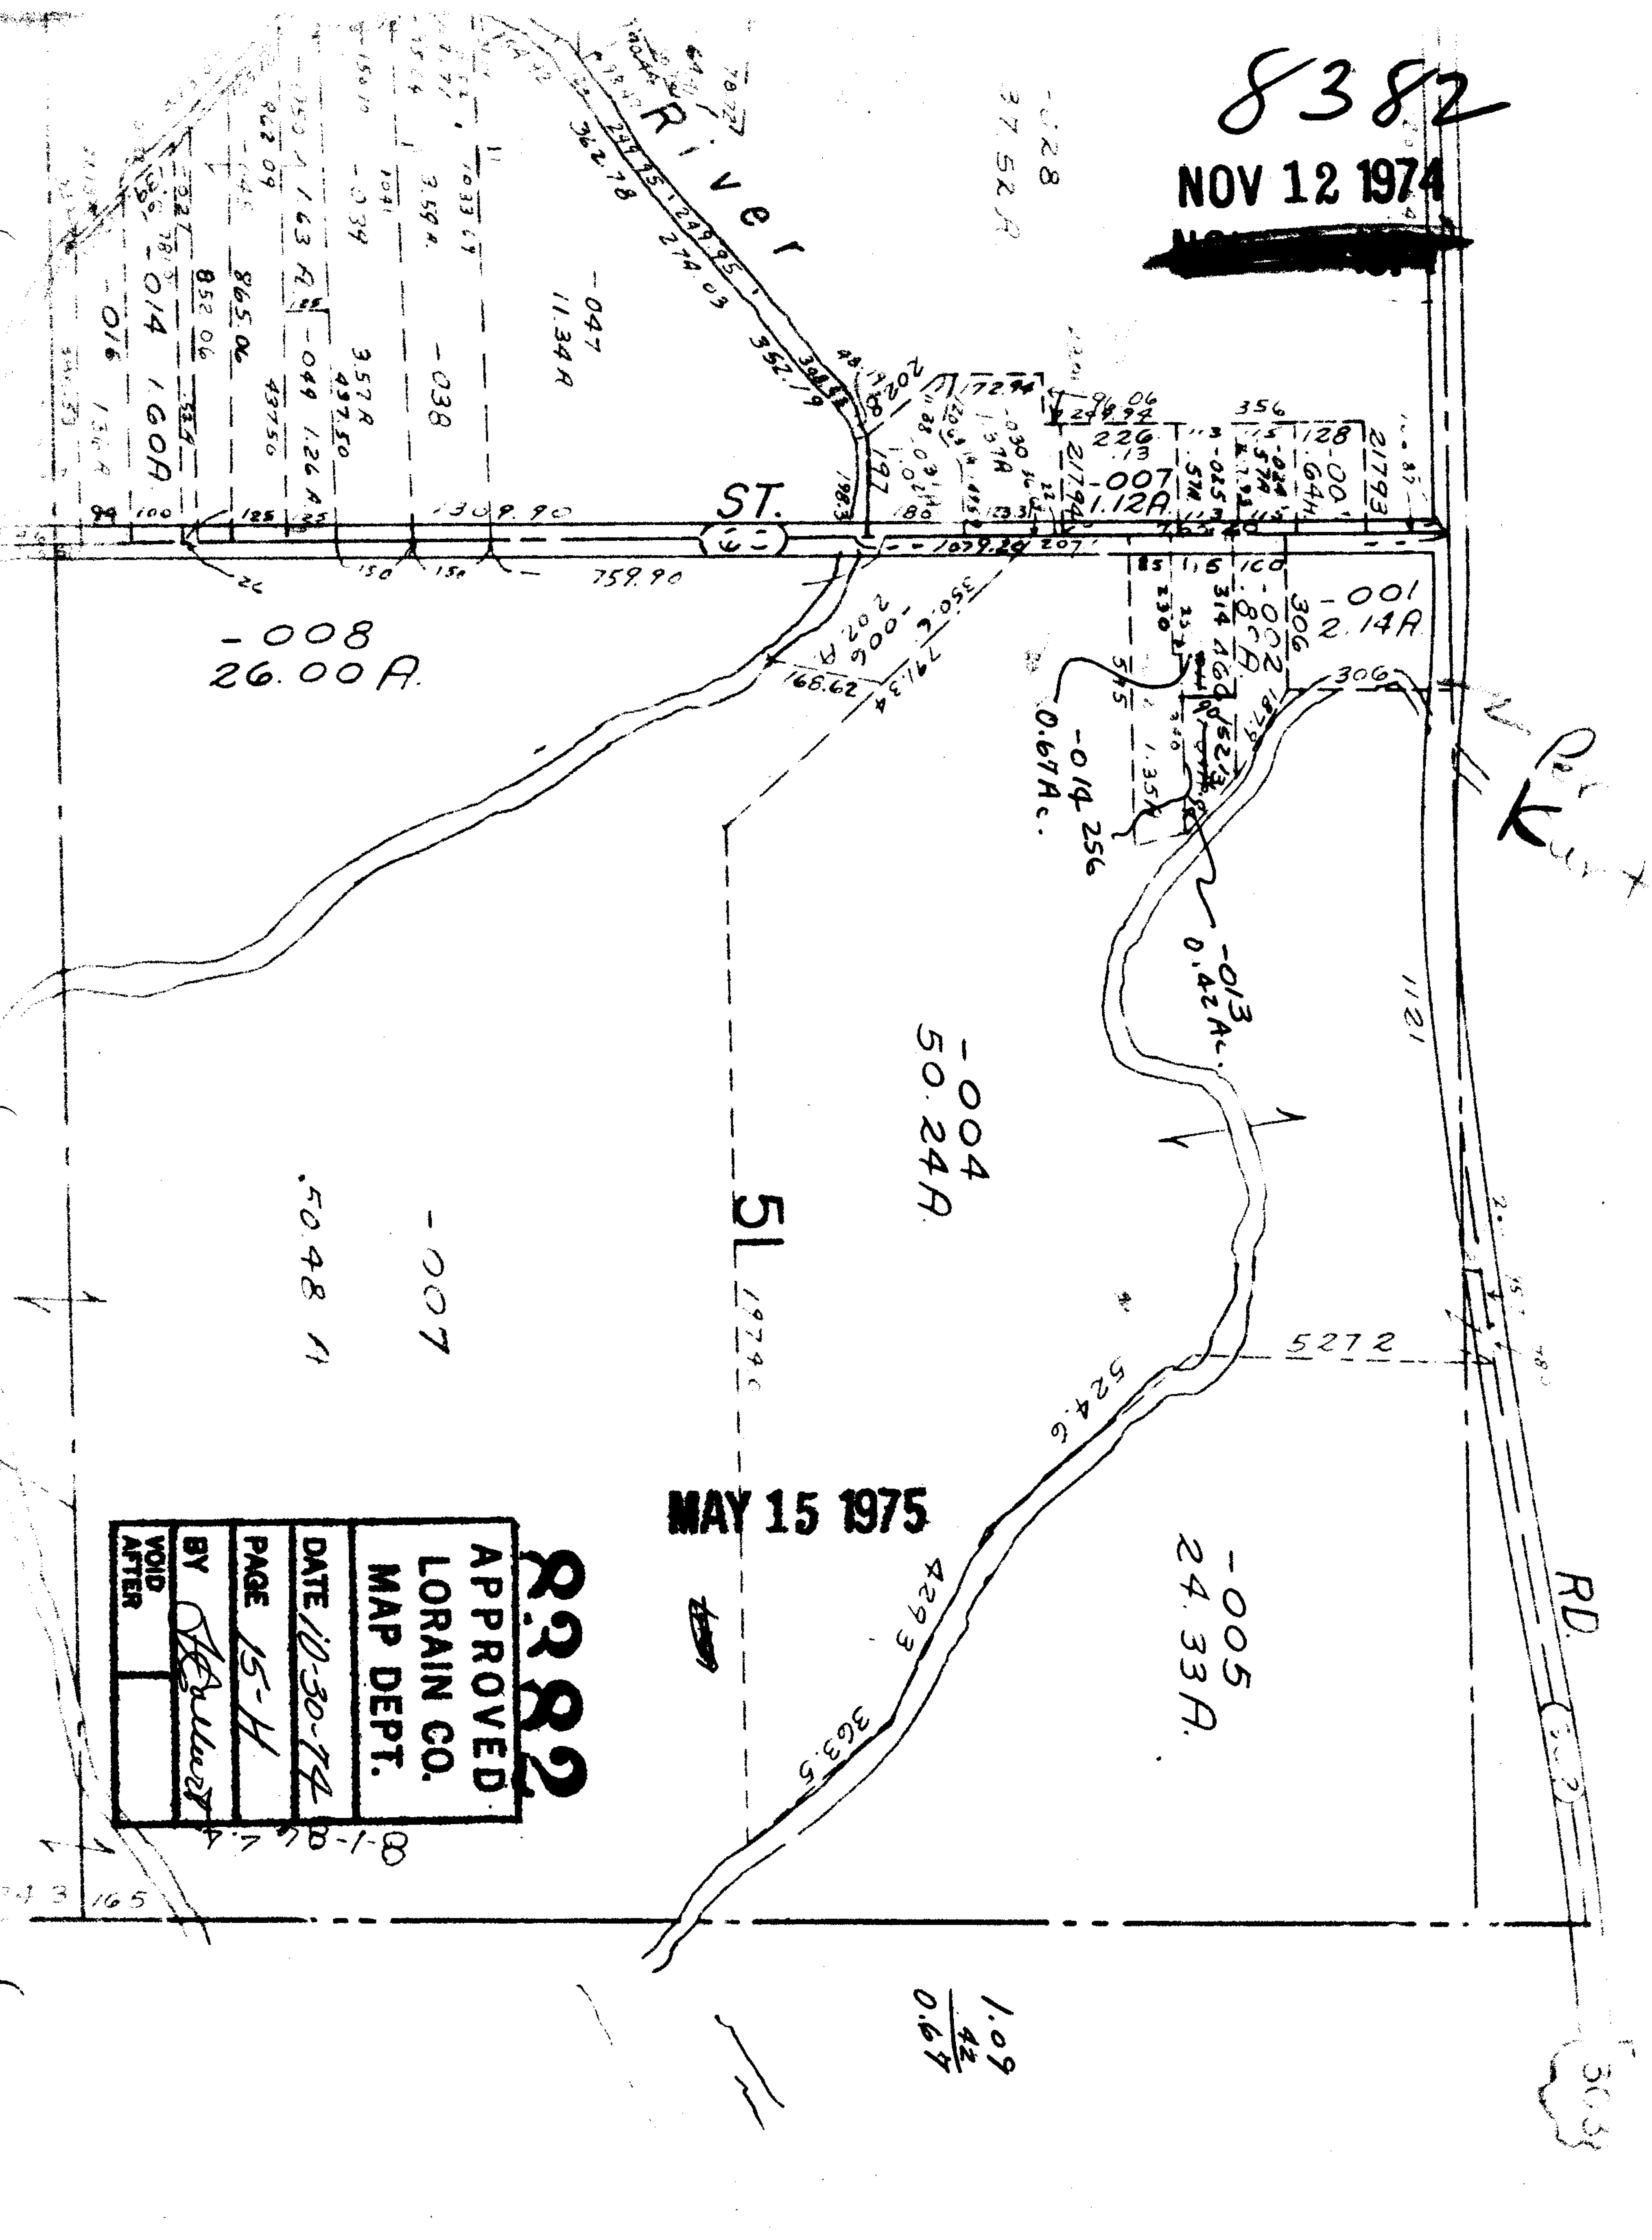

MAY 15 1975

**APPROVED**  
**LORAIN CO.**  
**MAP DEPT.**

|            |                    |
|------------|--------------------|
| DATE       | 10-30-74           |
| PAGE       | 15-H               |
| BY         | <i>[Signature]</i> |
| VOID AFTER |                    |

$$\frac{1.09}{.42} = 0.67$$

503