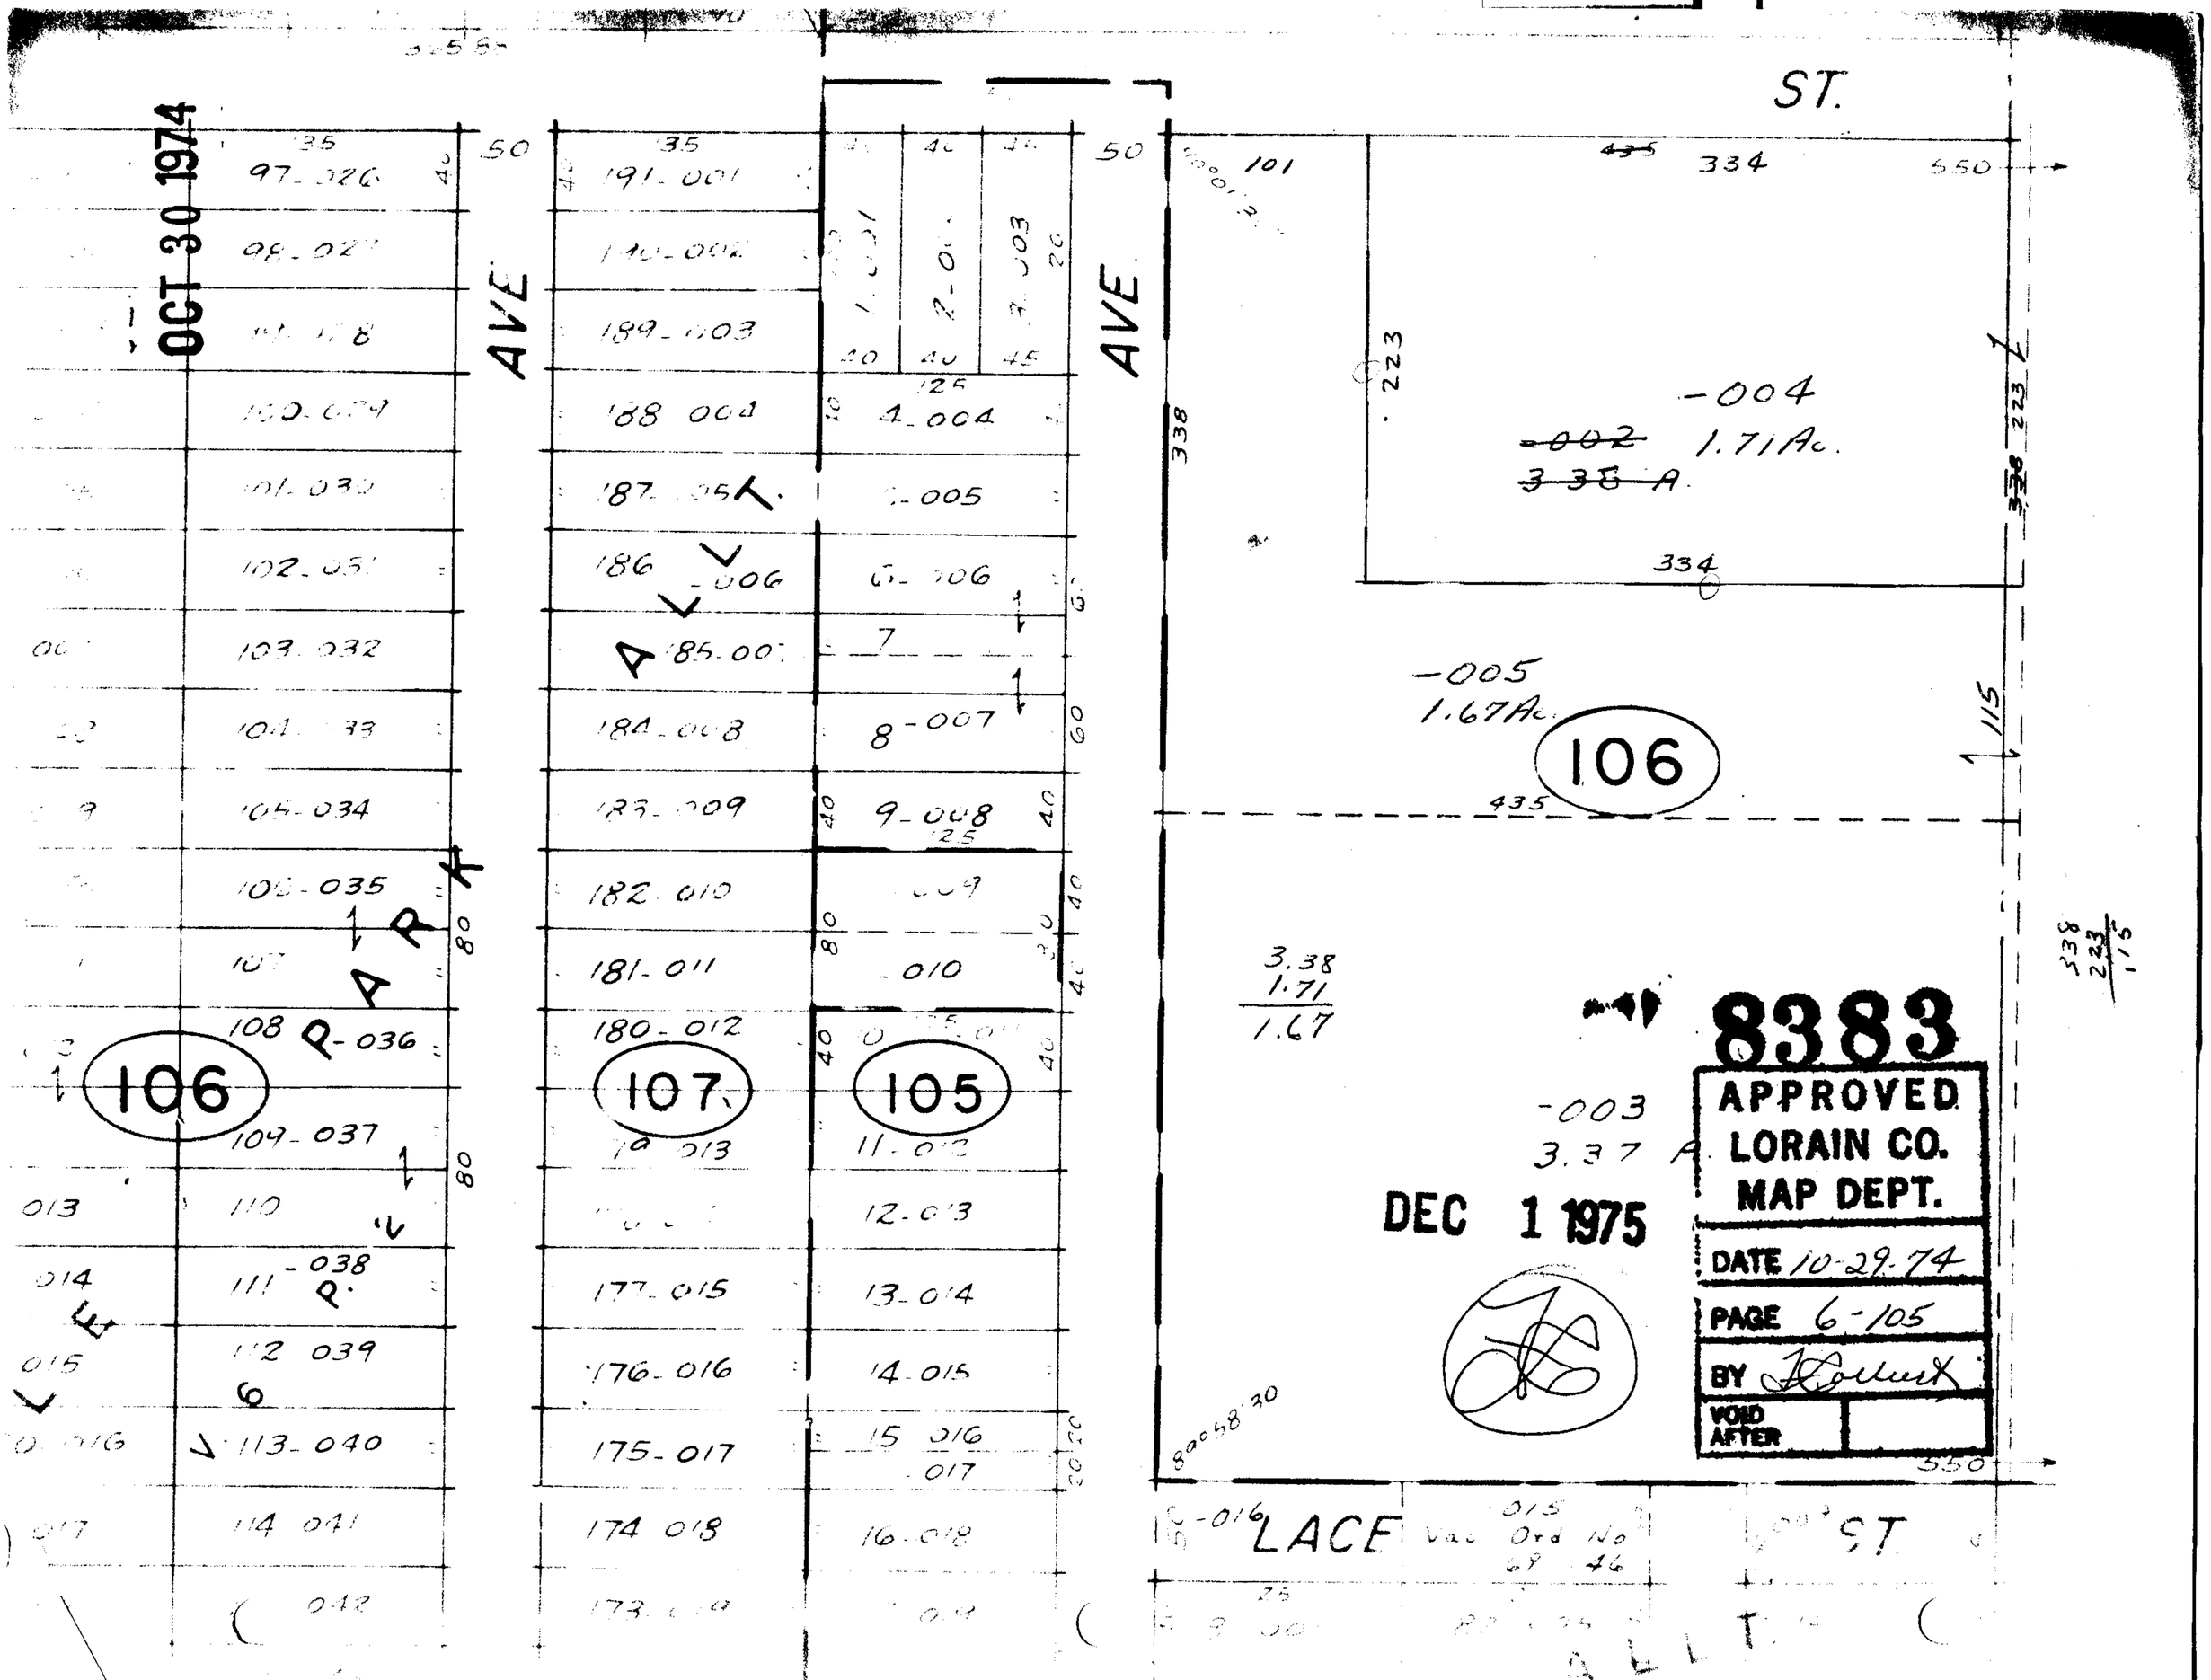

OCT 30 1974
ST.
AVE
AVE
ALLT.
PARK
LE
LACE
ST.
106
107
105
106
-004
1.71Ac.
-002
3.38 A
-005
1.67Ac.
-003
3.37 A
3.38
1.71
1.67
8383
APPROVED
LORAIN CO.
MAP DEPT.
DATE 10-29-74
PAGE 6-105
BY
VOID AFTER
DEC 1 1975