


NOV 18 1974

SEE 1-L

-036  
~~-034~~  
45.59 Ac.  
44.79 Ac.

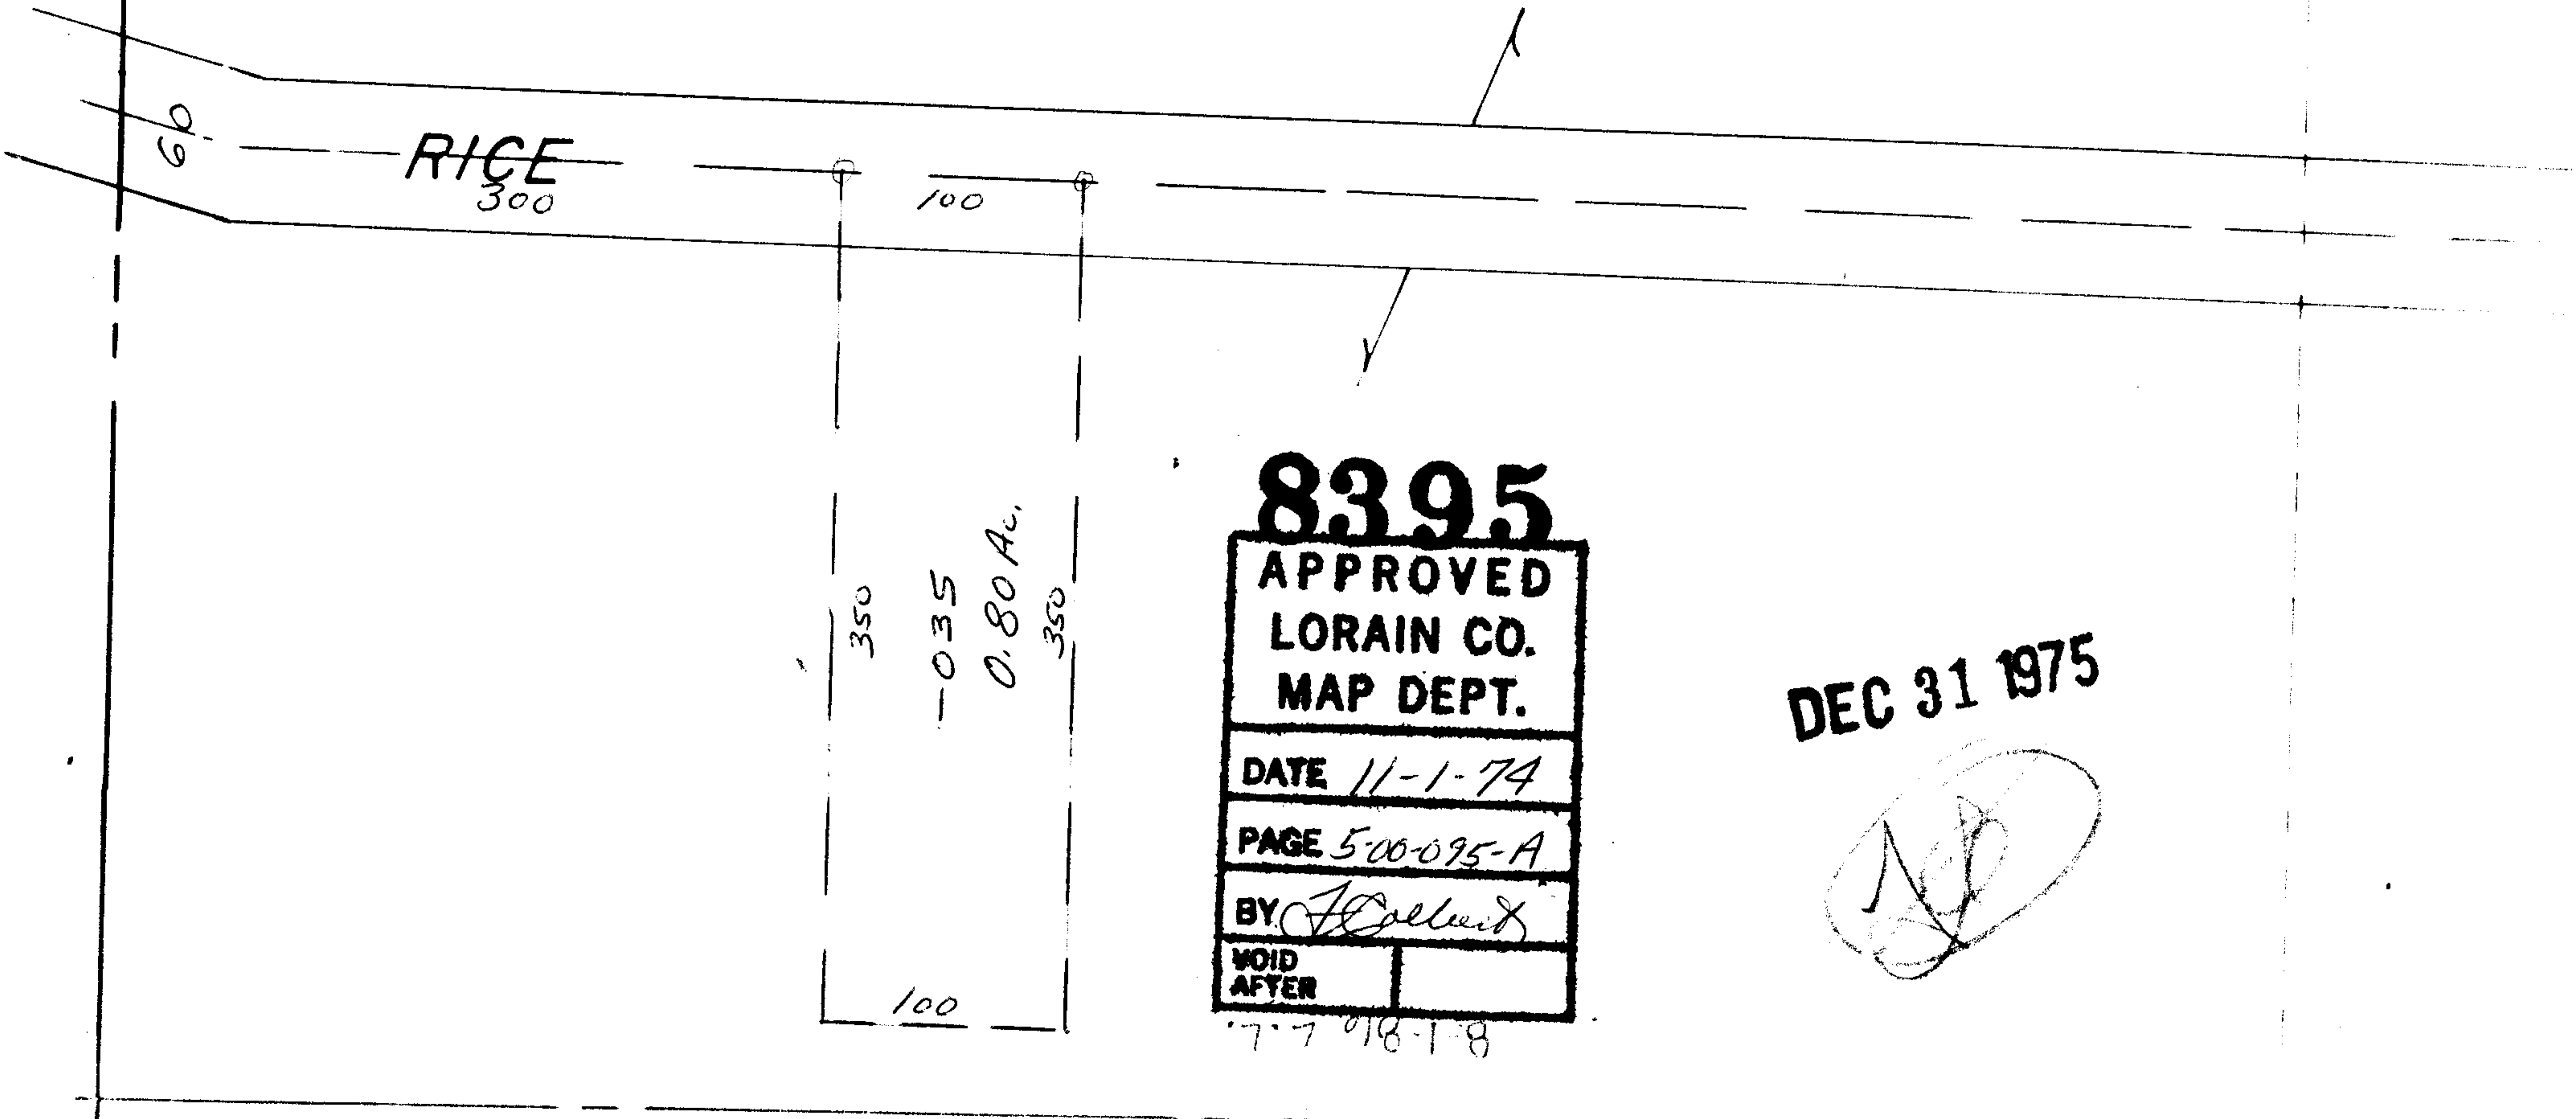

SEE 5-00-094