


8399

NOV 7 1974

OCT 16 1975

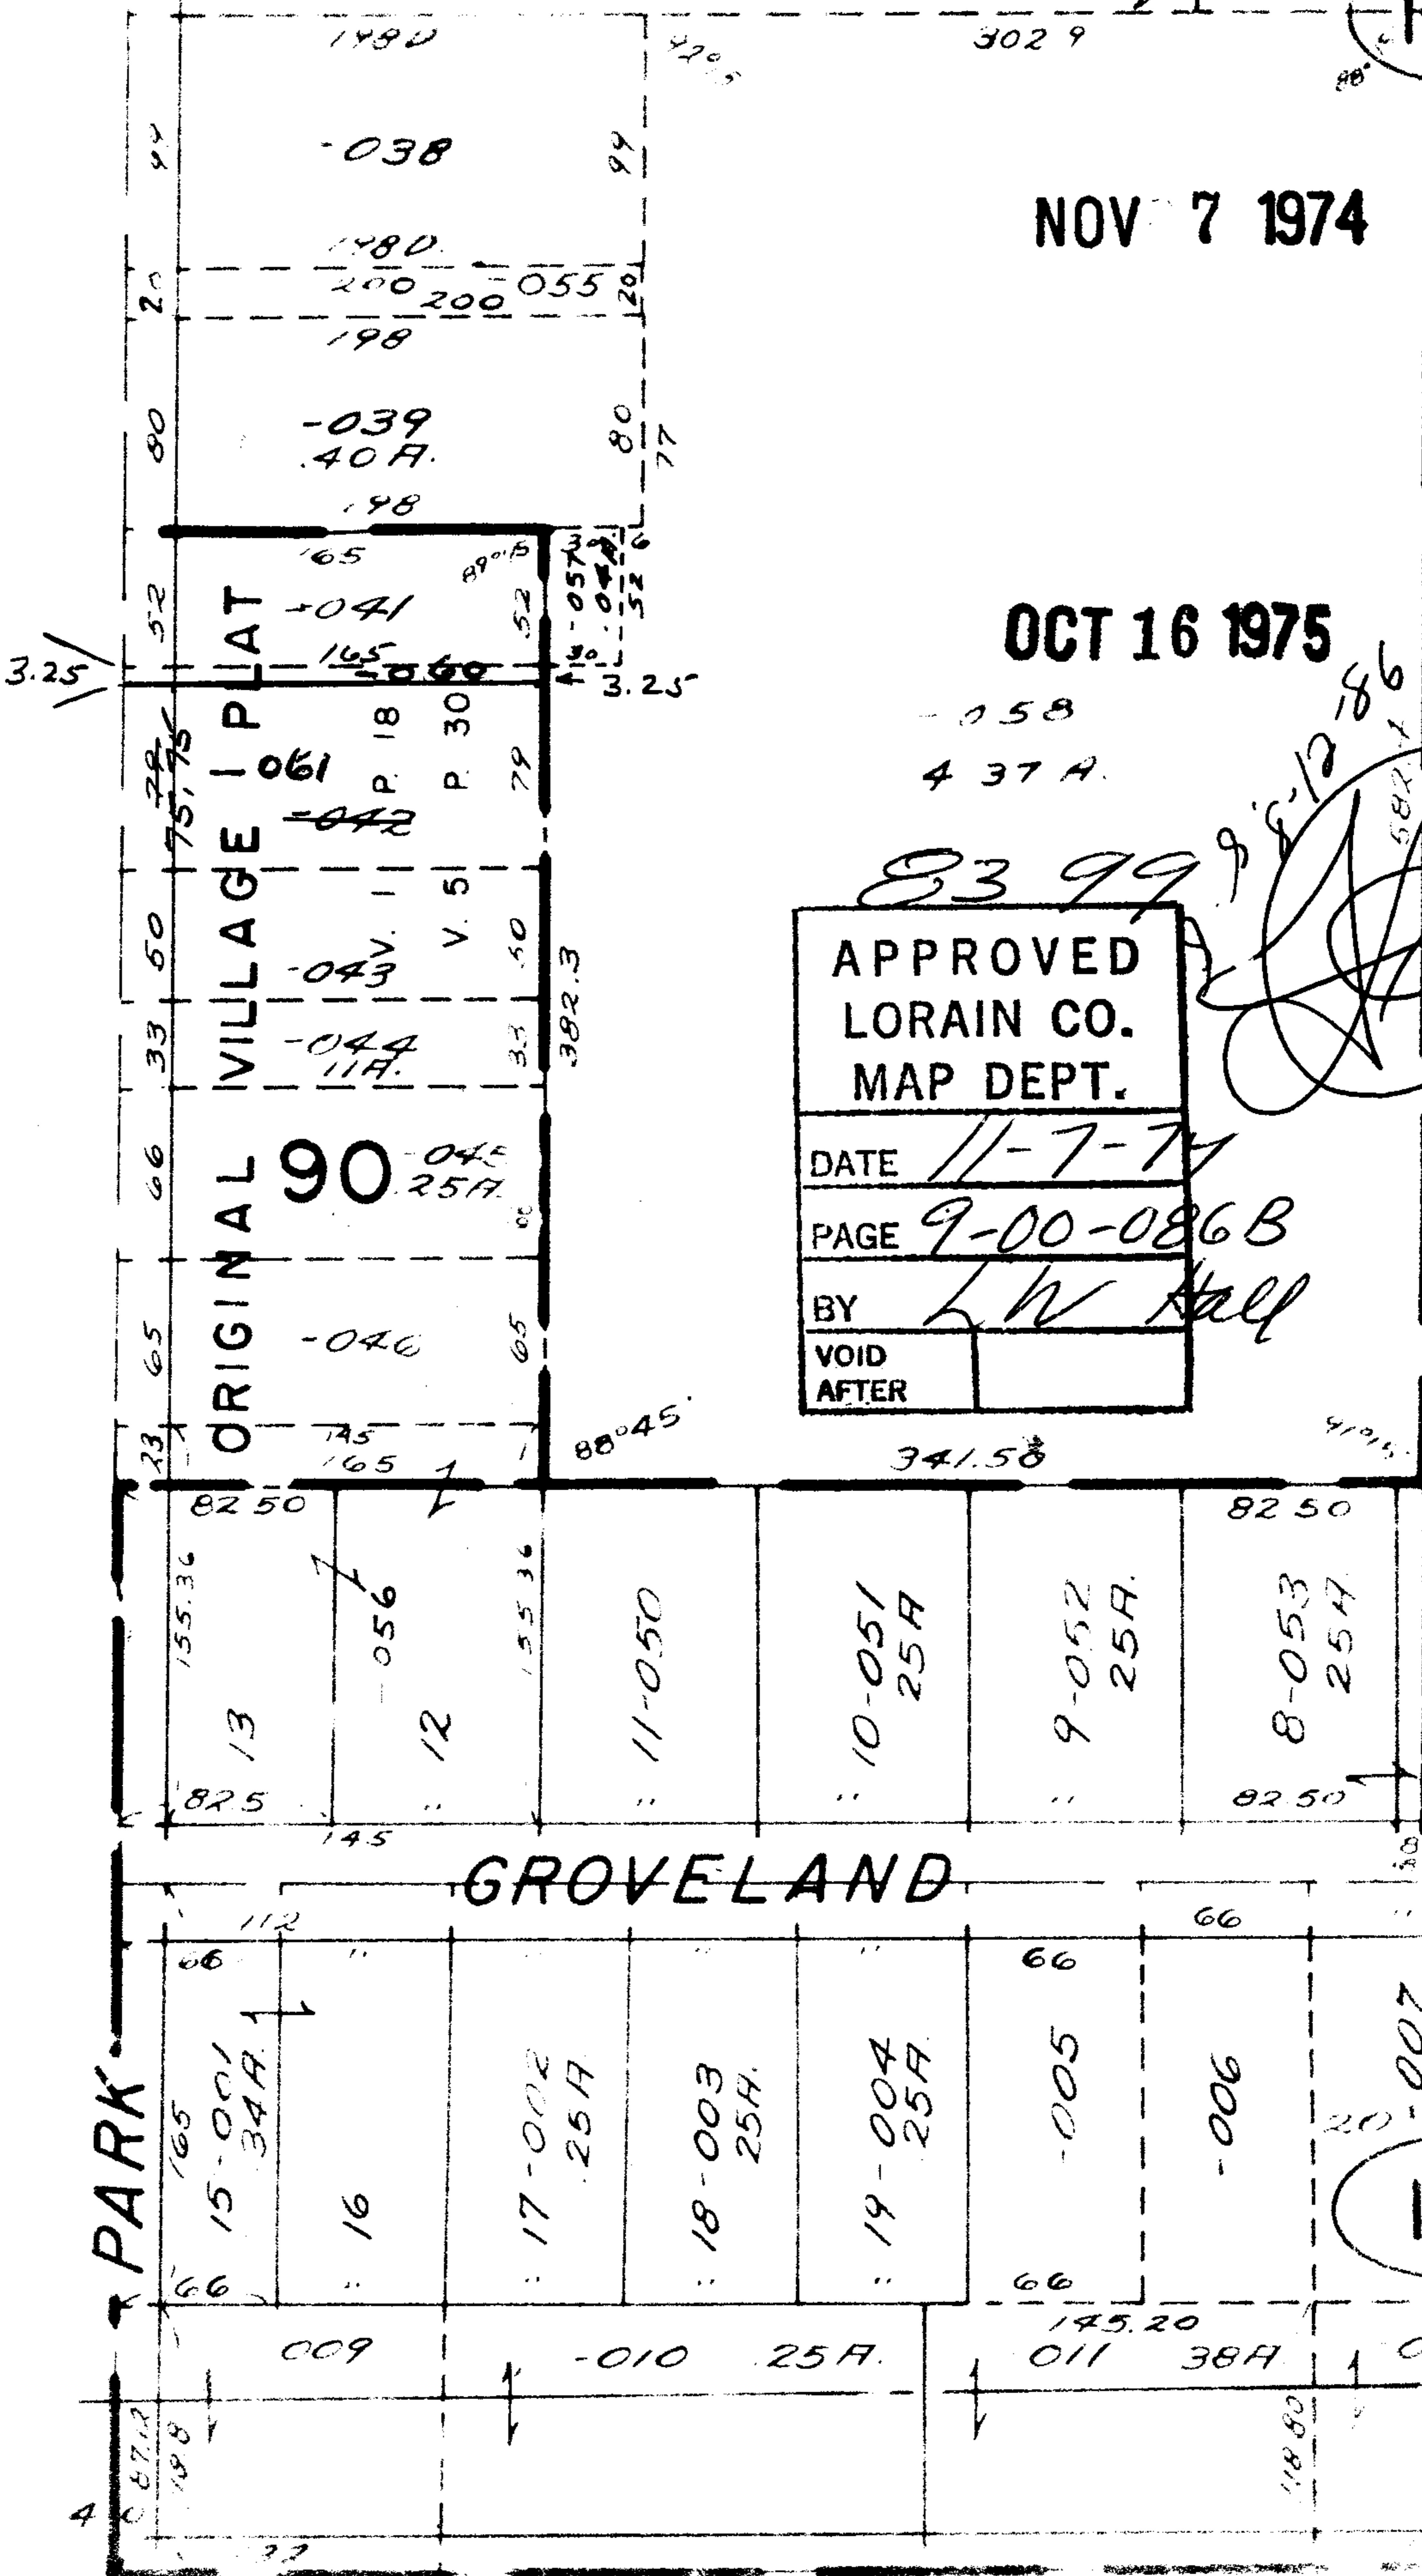


APPROVED
LORAIN CO.
MAP DEPT.

DATE 11-7-74

PAGE 9-00-086B

BY L W Hall

VOID AFTER

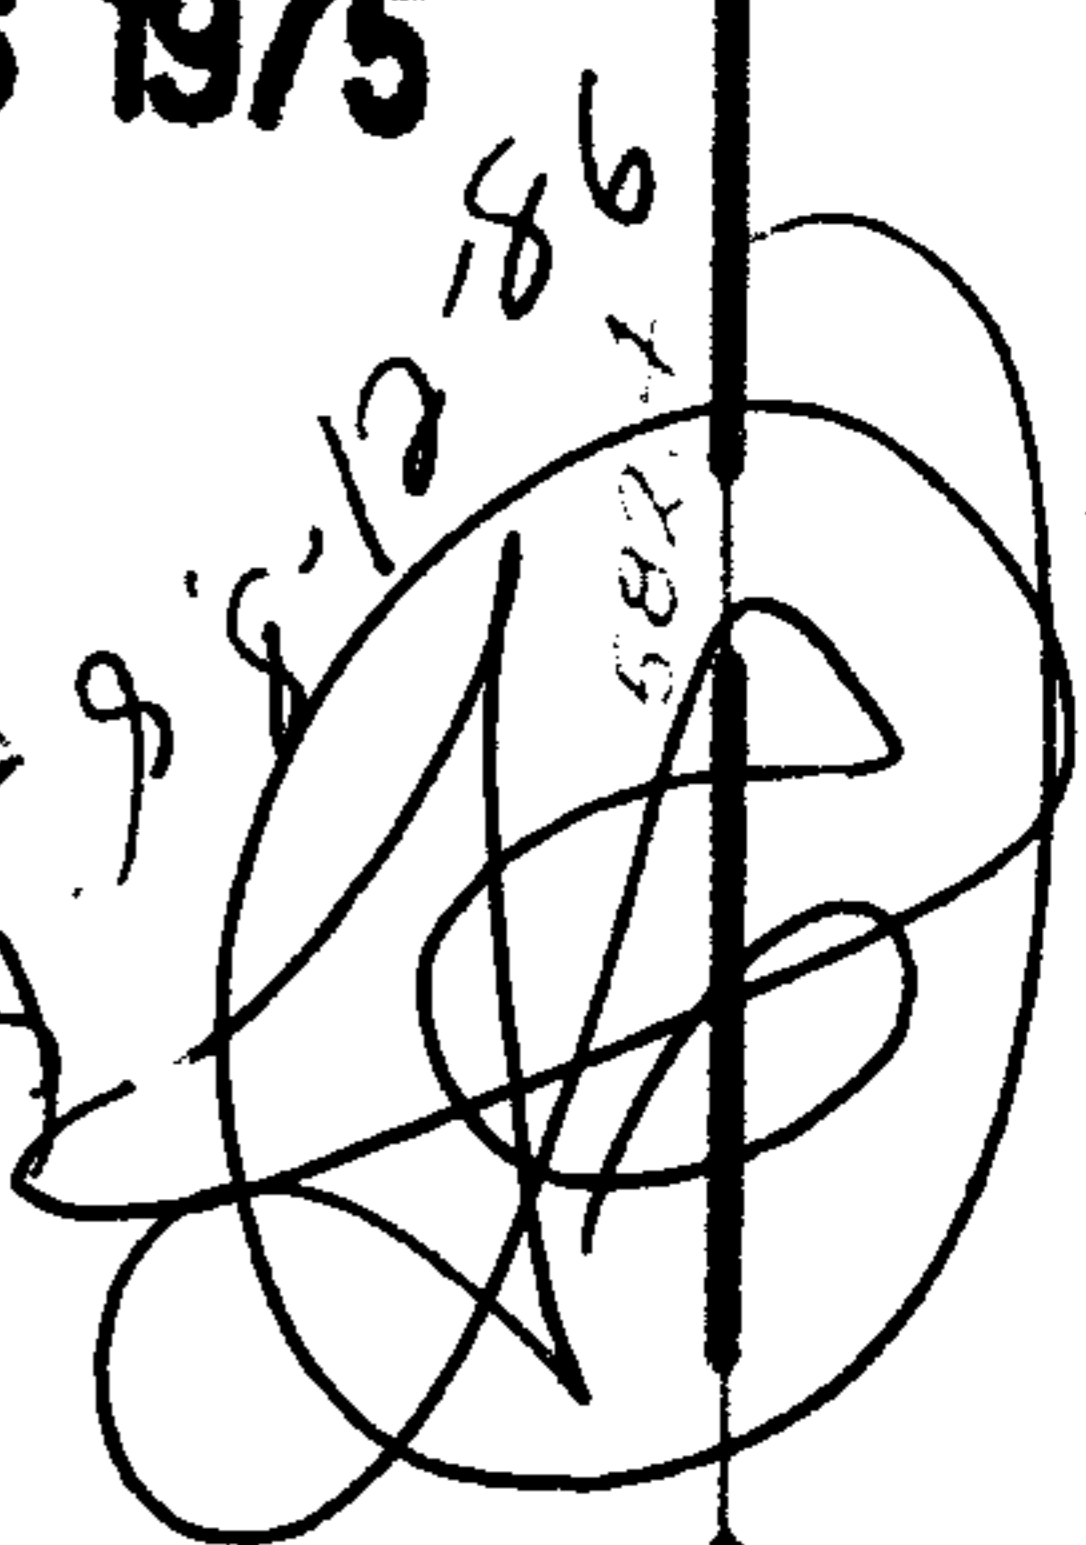

H.

PARK

GROVELAND

FRANKFORT