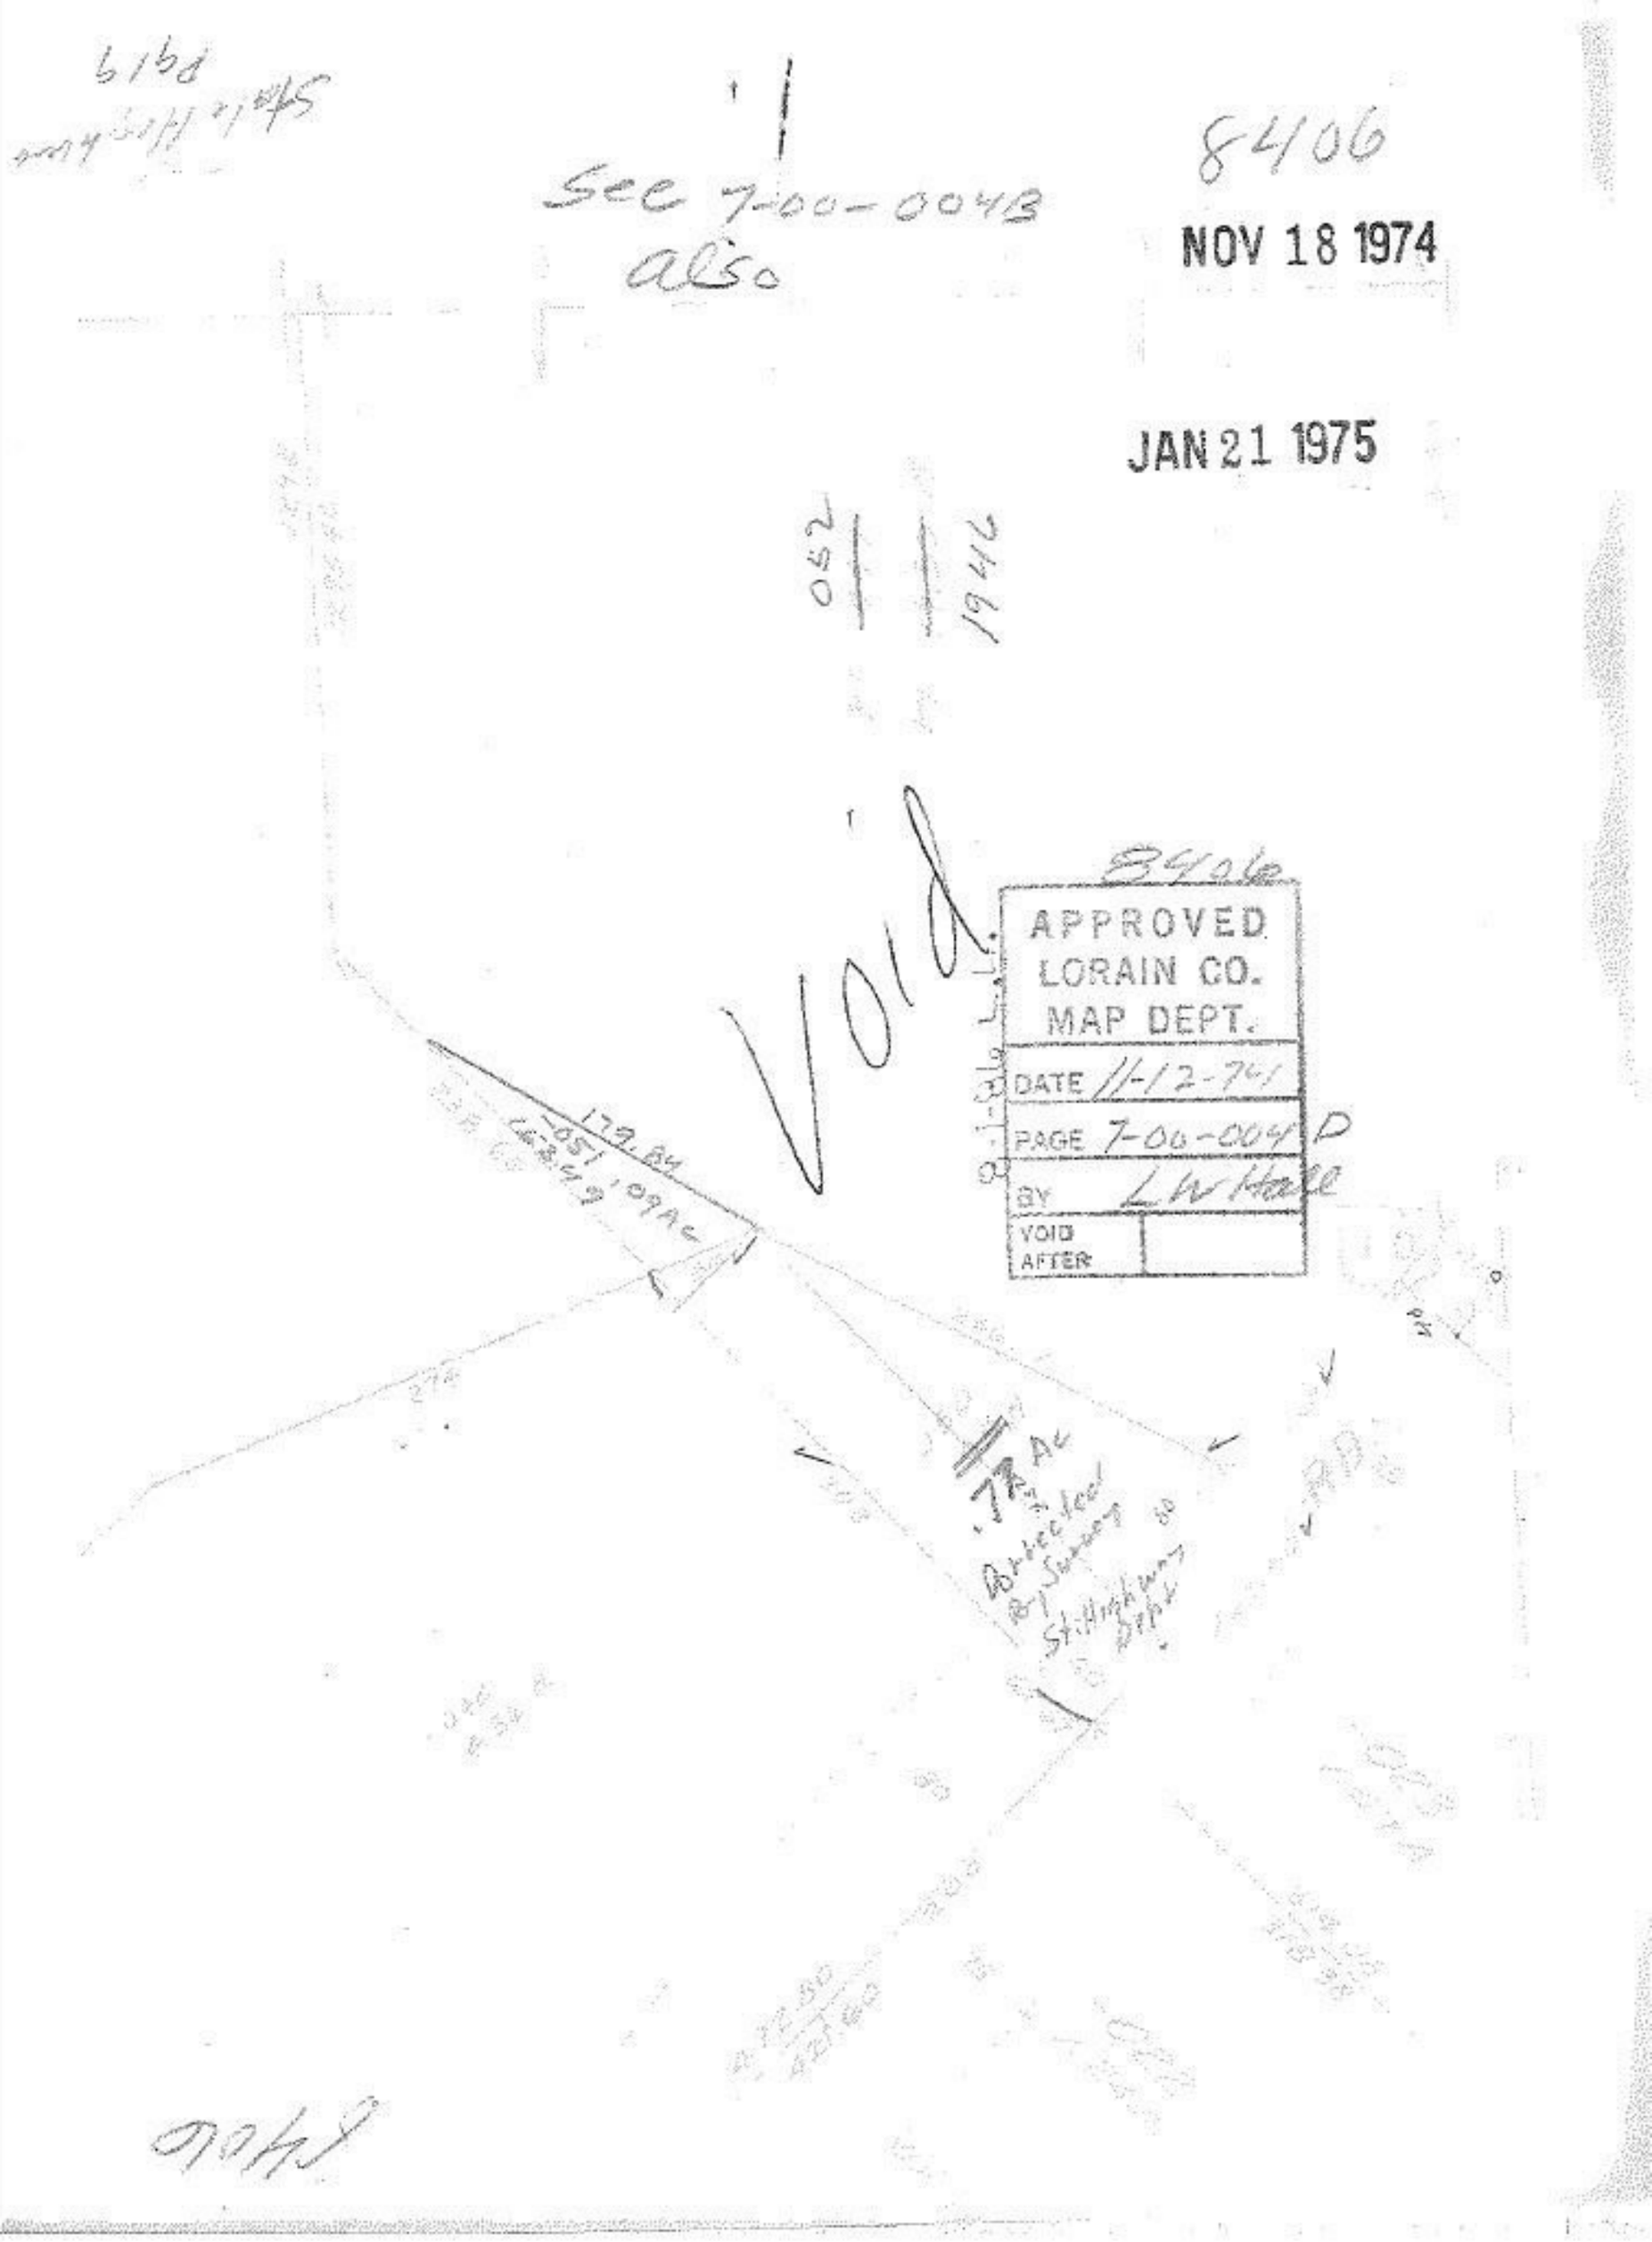

Sec 7-00-004B
also
8406
NOV 18 1974
JAN 21 1975
052
1946
Void
8406
APPROVED
LORAIN CO.
MAP DEPT.
DATE 11-12-74
PAGE 7-00-004 D
BY L W Hall
VOID AFTER
179.84
.051
.09 Ac
.77 Ac
Corrected By Survey
St. Highway Dept